





A
A-1 SCALE NTS
PERSPECTIVES

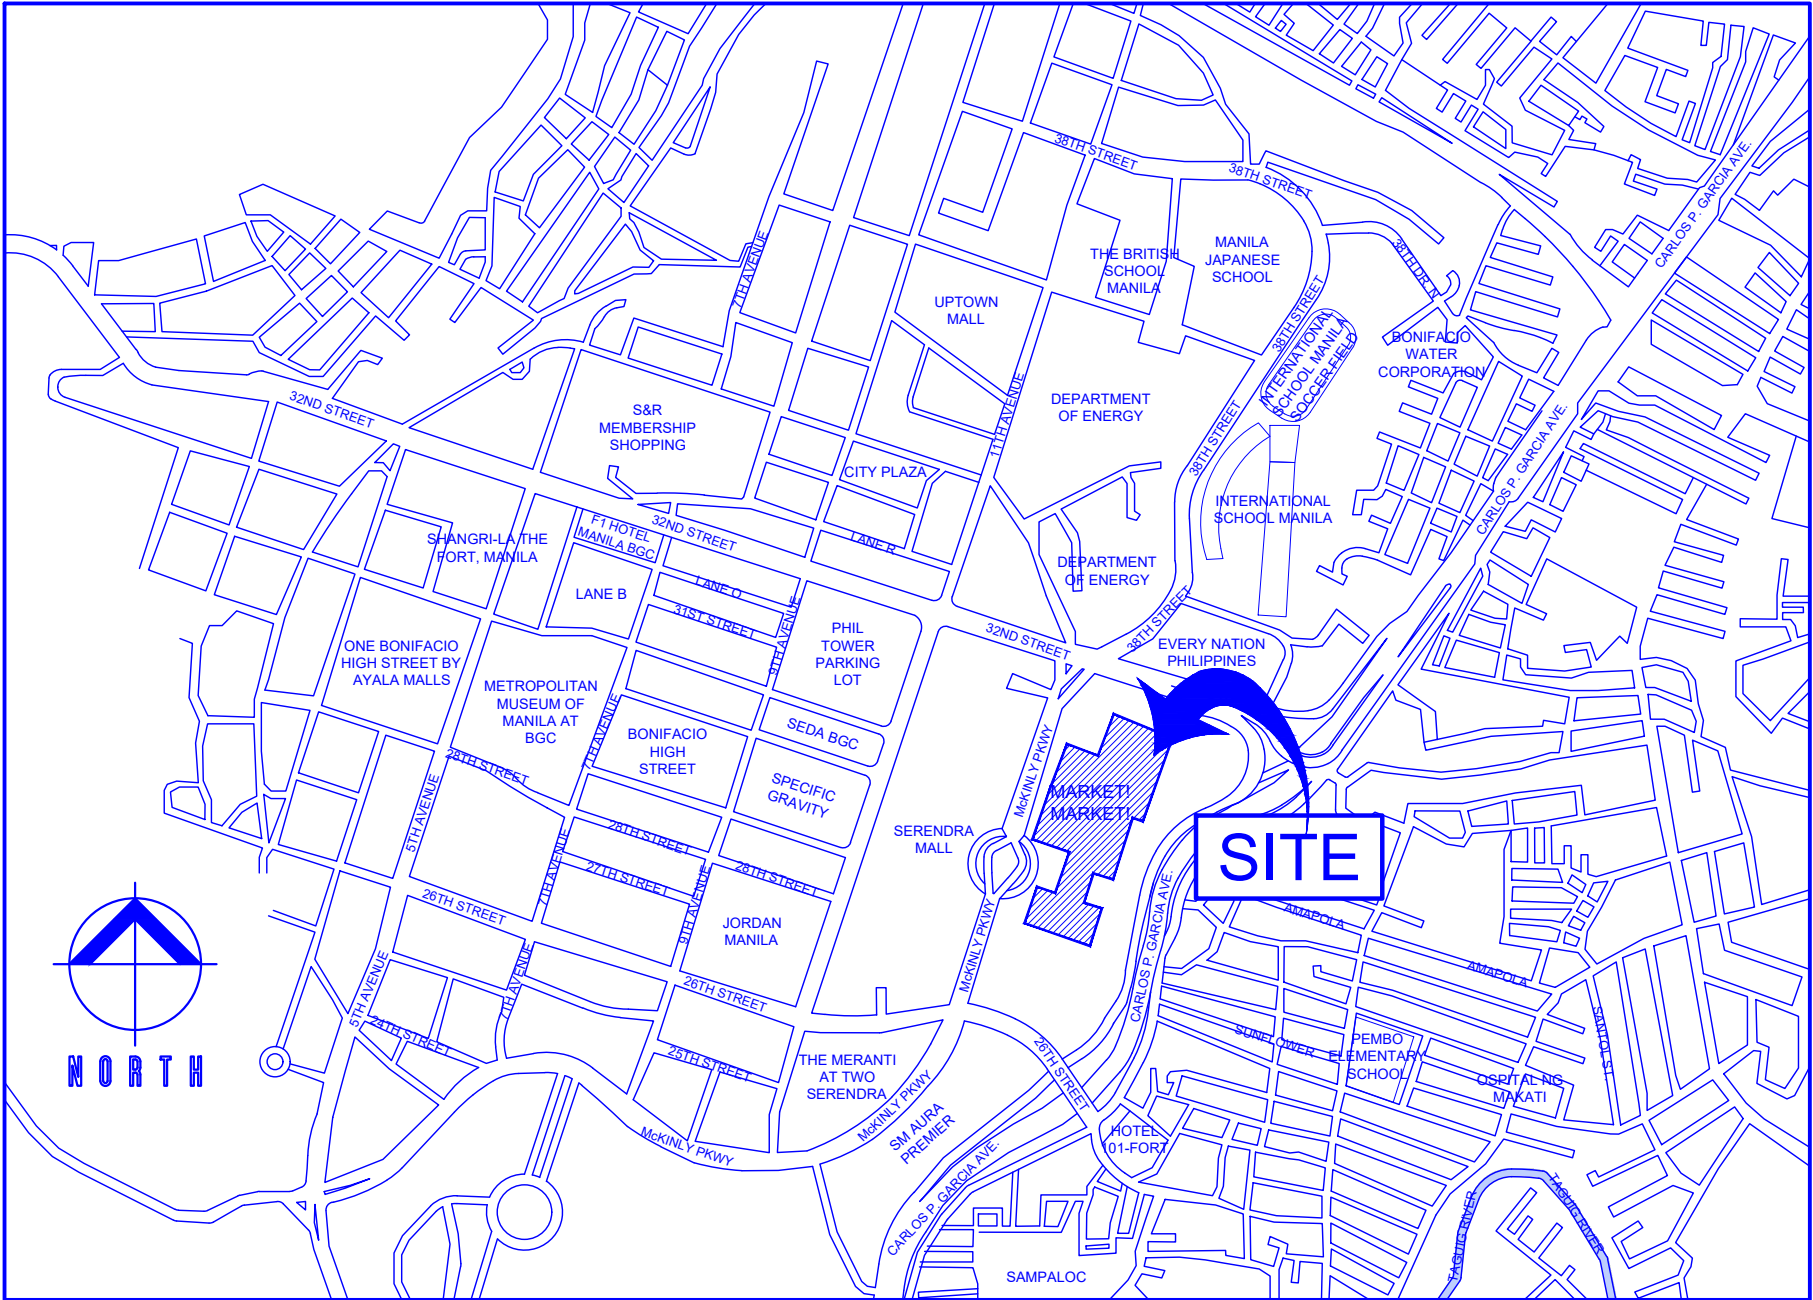

B
A-1 SCALE NTS
VICINITY MAP

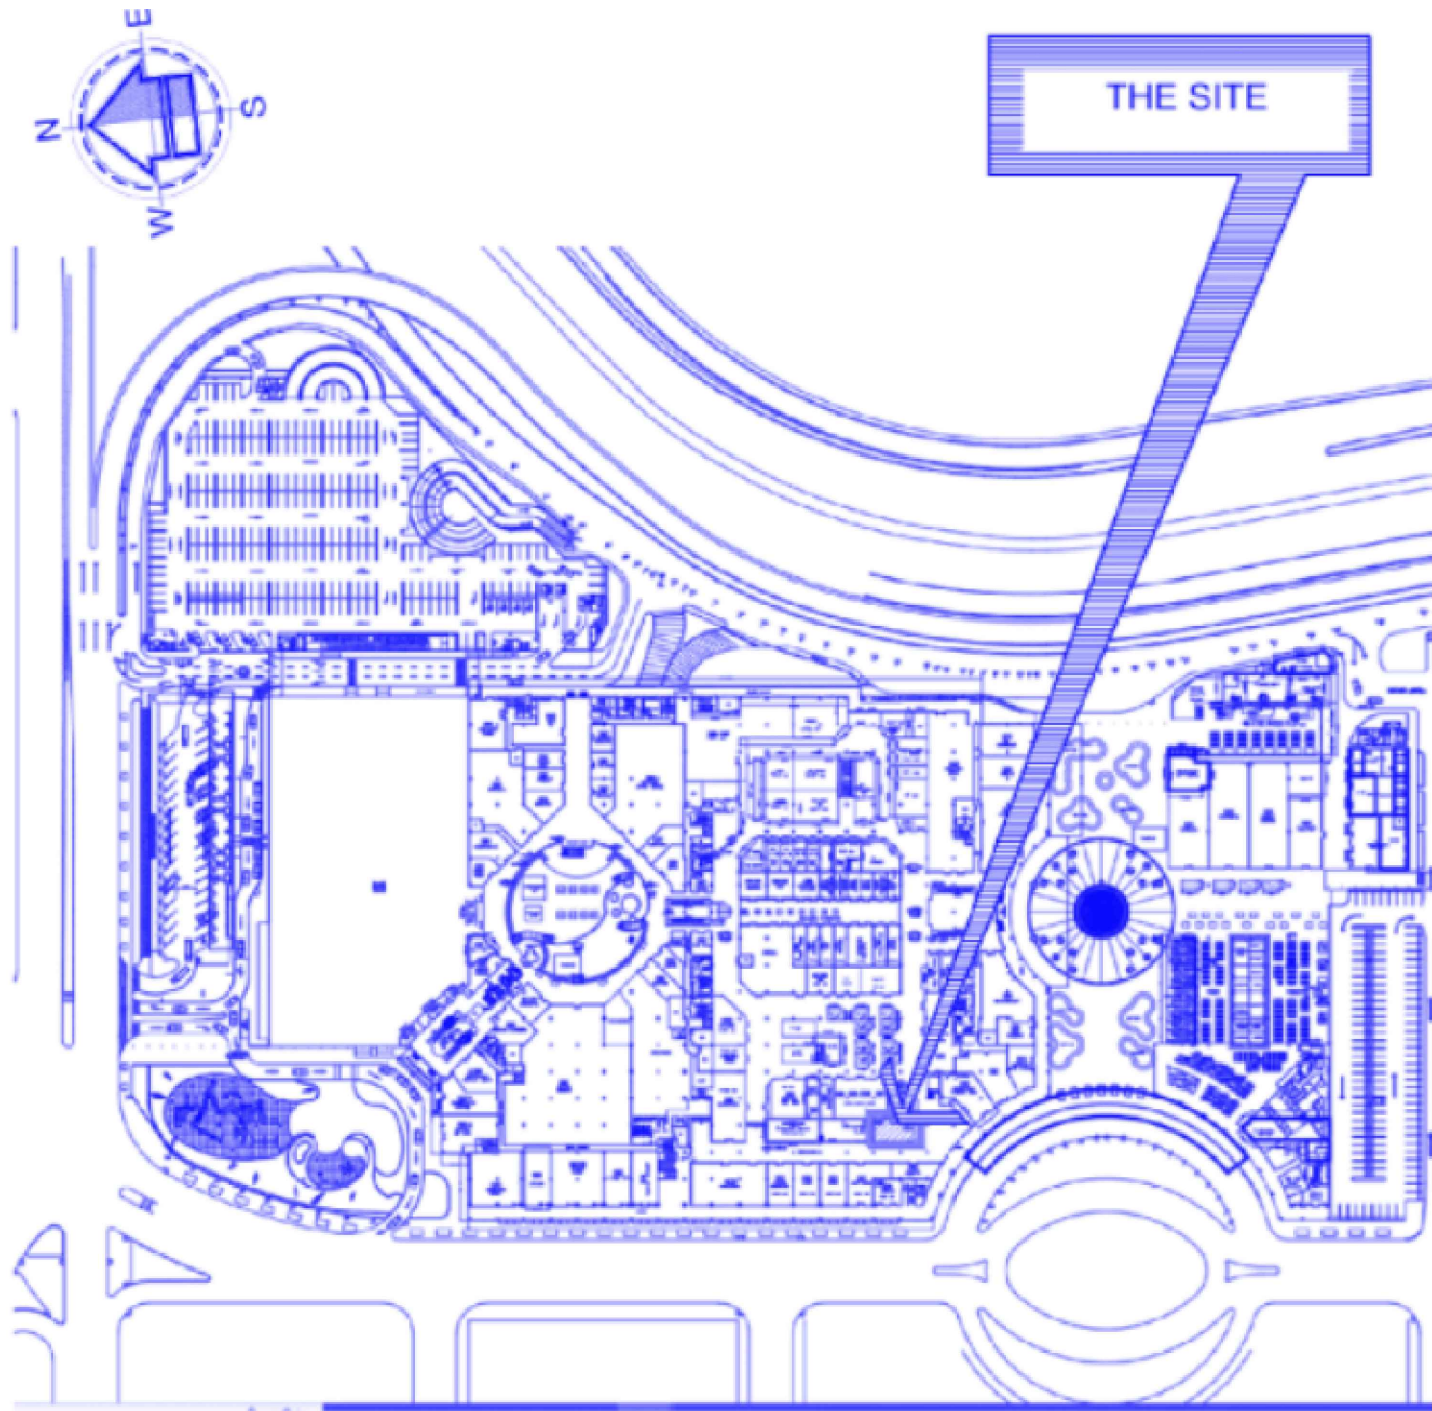

C
A-1 SCALE NTS
KEY PLAN

AS-BUILT PLAN

TABLE OF CONTENTS	
ARCHITECTURAL	
A-1	EXTERIOR PERSPECTIVE, VICINITY MAP, KEY PLAN
A-2	FLOOR PLAN, DIMENSIONAL PLAN, WALL FINISHING PLAN, FLOOR PATTERN LAYOUT
A-3	REFLECTED CEILING PLAN, STOREFRONT ELEVATION - A, INTERIOR ELEVATION - B, INTERIOR ELEVATION - C
A-4	INTERIOR ELEVATION - D, E, F, G, H
A-5	INTERIOR ELEVATION - I, ARCHITRAVE DETAILS, SHELVES - WORKTOP DETAILS, FITTING ROOM MIRROR DETAILS, CURTAIN COVE DETAILS
A-6	CASH TILL COUNTER DETAILS, SIGNAGE DETAILS, CLICK & COLLECT ENCLOSURE DETAILS
A-7	ENTRANCE SHUTTER, STORAGE / EE / DATA ROOM DOOR DETAILS
ELECTRICAL	
E-1	GENERAL NOTES, TYPICAL DETAILS, VICINITY MAP, SCHEDULE OF LOADS, SINGLE LINE DIAGRAM
E-2	LIGHTING LAYOUT, POWER LAYOUT, LEGEND & SYMBOLS
MECHANICAL	
M-1	GENERAL NOTES, VICINITY MAP, TYPICAL DETAILS, AIR-CONDITIONING LAYOUT, CHILLED WATER AND CONDENSATE DRAIN PIPING
FIRE PROTECTION	
FP-1	GENERAL NOTES, FIRE PROTECTION SYSTEM, LEGEND & SYMBOLS, VICINITY MAP, FIRE EXTINGUISHER DETAIL, SPRINKLER DETAILS
ELECTRONICS	
ECE-1	GENERAL NOTES, VICINITY MAP, FIRE DETECTION AND ALARM SYSTEM LAYOUT, DATA/TEL, CCTV & SPEAKER LAYOUT, TYPICAL DETAILS, RISER DIAGRAM

REPUBLIC OF THE PHILIPPINES DEPARTMENT OF PUBLIC WORKS & HIGHWAYS	
OFFICE OF THE BUILDING OFFICIAL CITY OF TAGUIG	
ISSUANCE RECOMMENDED	
SECTION HEAD: ISSUED BY:	DATE
BUILDING OFFICIAL	DATE
LAND USE AND ZONING	
HEAD	DATE
LINE AND GRADE	
HEAD	DATE
ARCHITECTURAL	
HEAD	DATE
STRUCTURAL	
HEAD	DATE
SANITARY	
HEAD	DATE
ELECTRICAL	
HEAD	DATE
MECHANICAL	
HEAD	DATE
ELECTRONICS	
HEAD	DATE



R.A.9266 Section 33
Drawing and specifications and other contract documents signed, stamped or sealed, as instruments of service, are the intellectual property and documents of the architect, whether the object for which they are made is executed or not, if shall be unlawful for any person to duplicate or to make copies of said documents for use in the repetition of and for other projects of building, whether executed partly in whole, without the written consent of architect or author of said documents.

ARCHITECT		
PRC. NO.:	ISSUED :	VALID :
PTR NO. :	ISSUED :	PLACE :
TIN :		

SEAL	PROJECT TITLE
	AS-BUILT OF DECATHLON CONNECT (71.95 SQM. INTERIOR RENOVATION)
	LOCATION: Unit L1 224-225 Market! Market! McKinley Parkway, Bonifacio Global City, Taguig, Metro Manila

APPROVED BY
DECATHLON PHILIPPINES INC. LAILA MONICA FLOR
OWNER
ADDRESS:

SHEET CONTENT
-EXTERIOR PERSPECTIVE -INTERIOR PERSPECTIVE -VICINITY MAP -KEYPLAN


DESIGNED BY:	THIS DRAWING IS ISSUED FOR :		
DRAFTED BY: SBMI	☒ AS BUILT	☐ ESTIMATE	
DATE ISSUED:	☐ BIDDING	☐ FABRICATION	
	☐ BUILDING PERMIT	☐ OWNER'S APPROVAL	
	☐ CONSTRUCTION	☐ PRESENTATION	
REVISIONS	DATE	REVISIONS	DATE
①		①	
②		②	
③		③	

SHEET NO.	
A-1	
01	04


SECTION HEAD: DATE
ISSUED BY:

BUILDING OFFICIAL DATE


SALES AREA : 63.05 SQM.
BOH/FTG RM. : 8.90 SQM.
TOTAL AREA : 71.95 SQM.

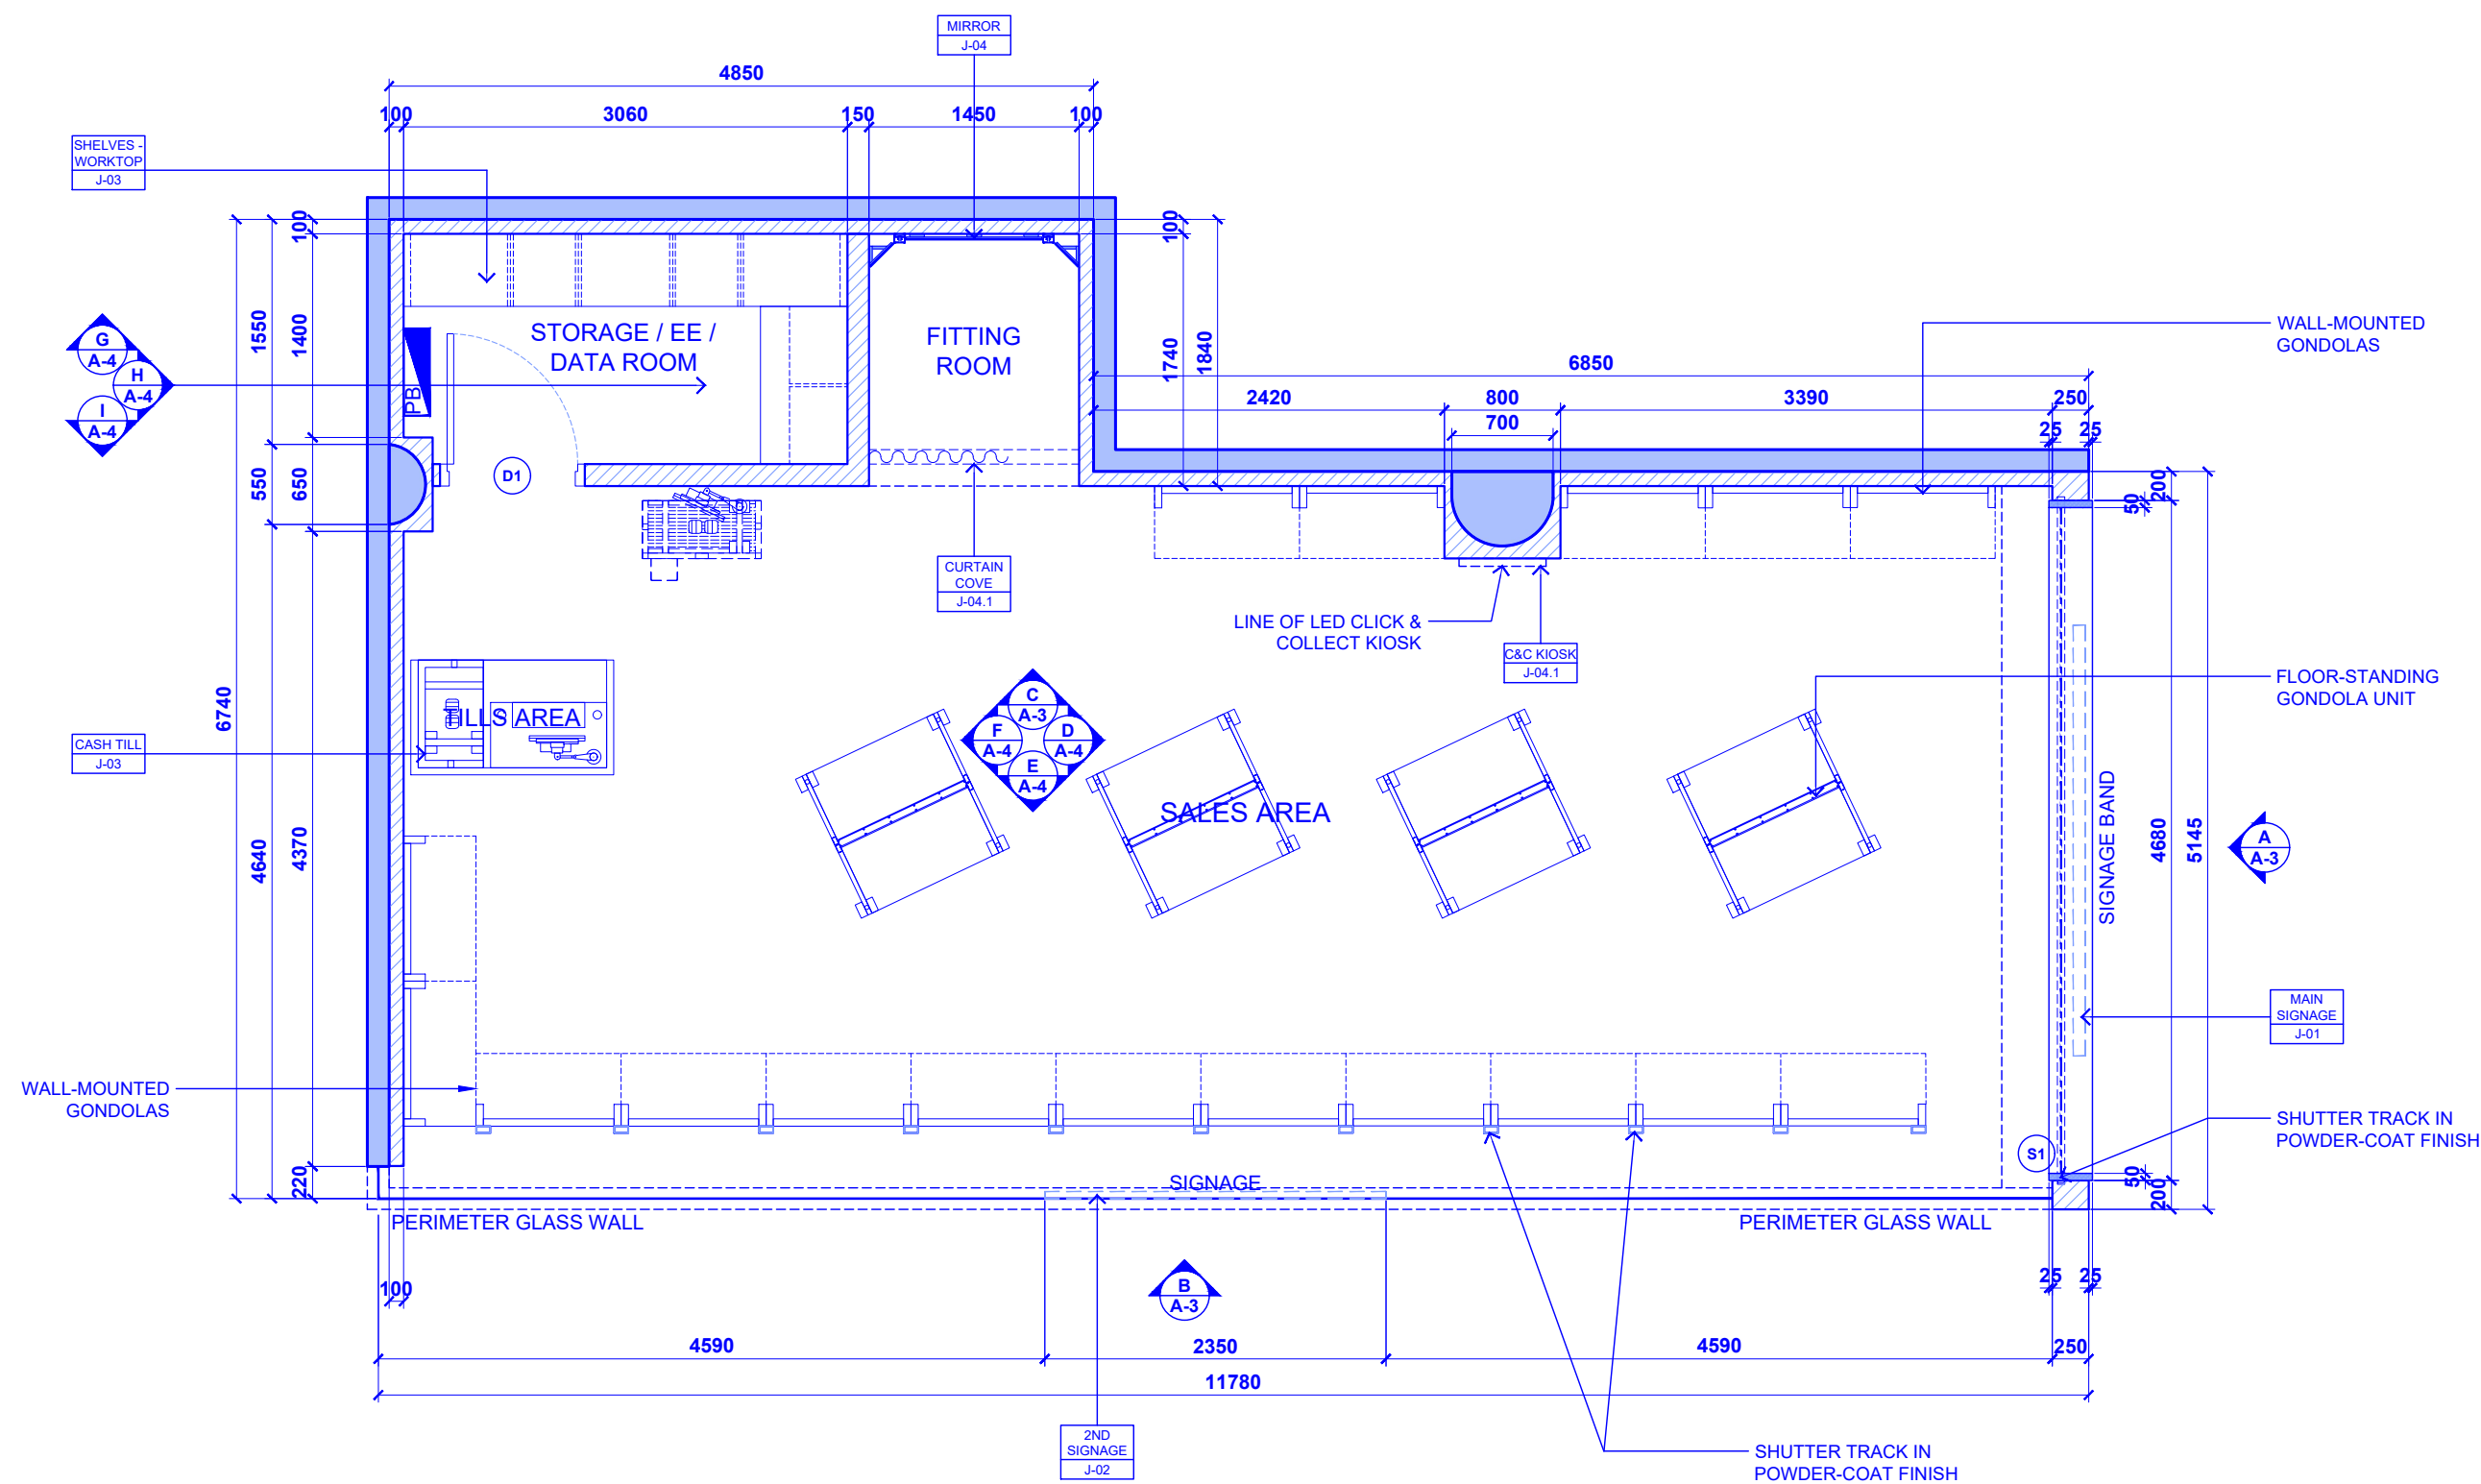


DECATHLON MARKET! MARKET! MALL
AS-BUILT FLOOR PLAN
SCALE 1:50 M

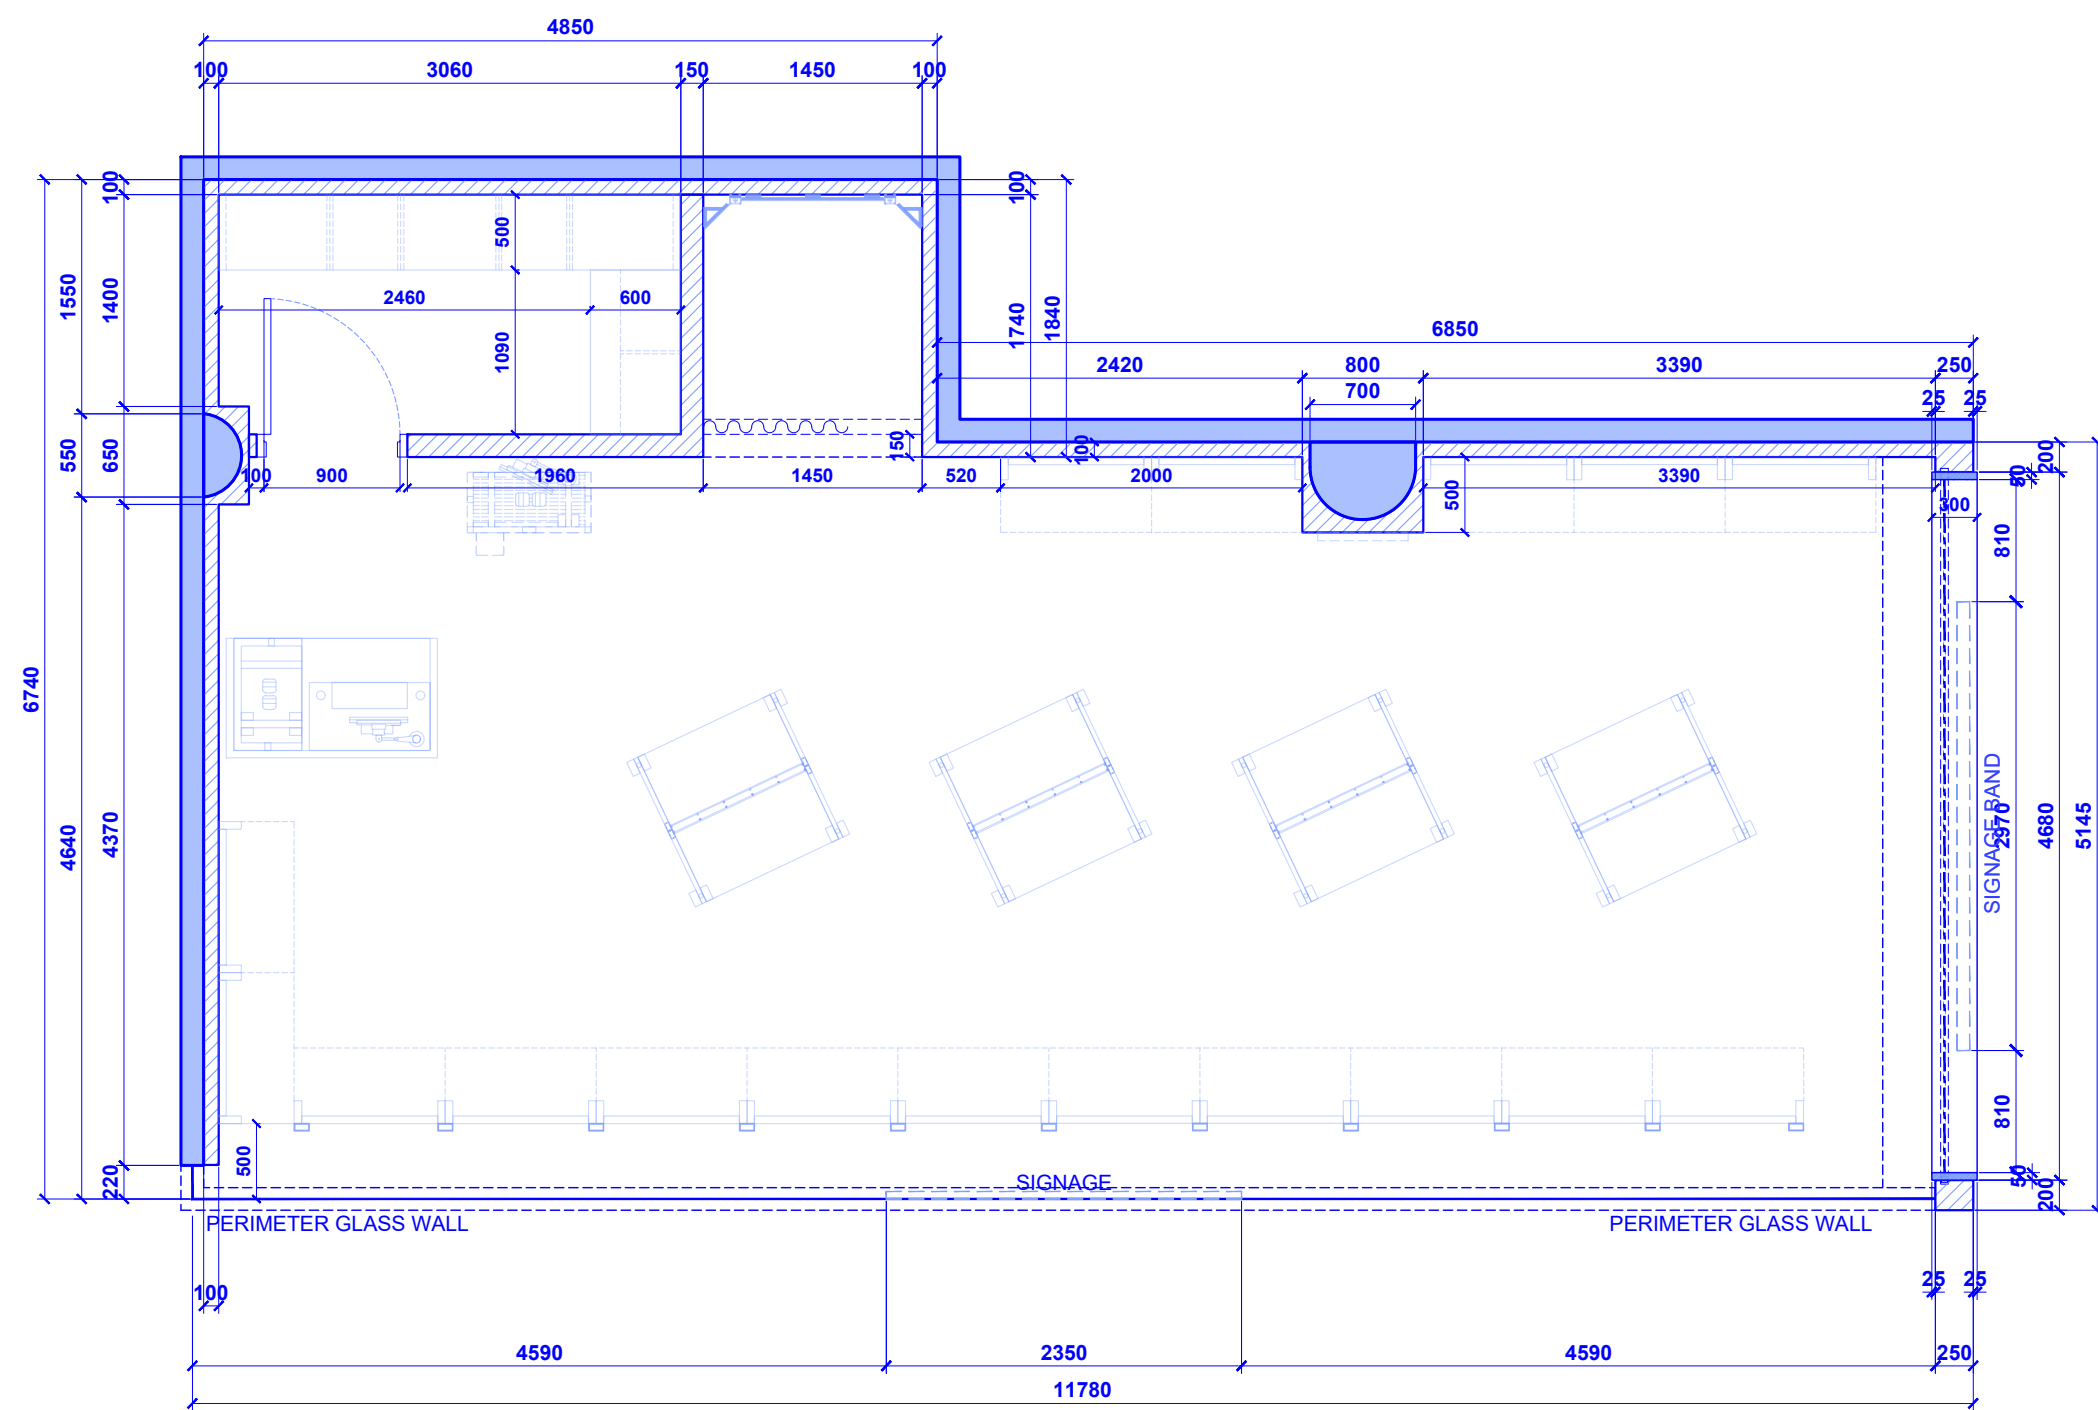

DECATHLON MARKET! MARKET! MALL
DIMENSIONAL PLAN
SCALE 1:50 M

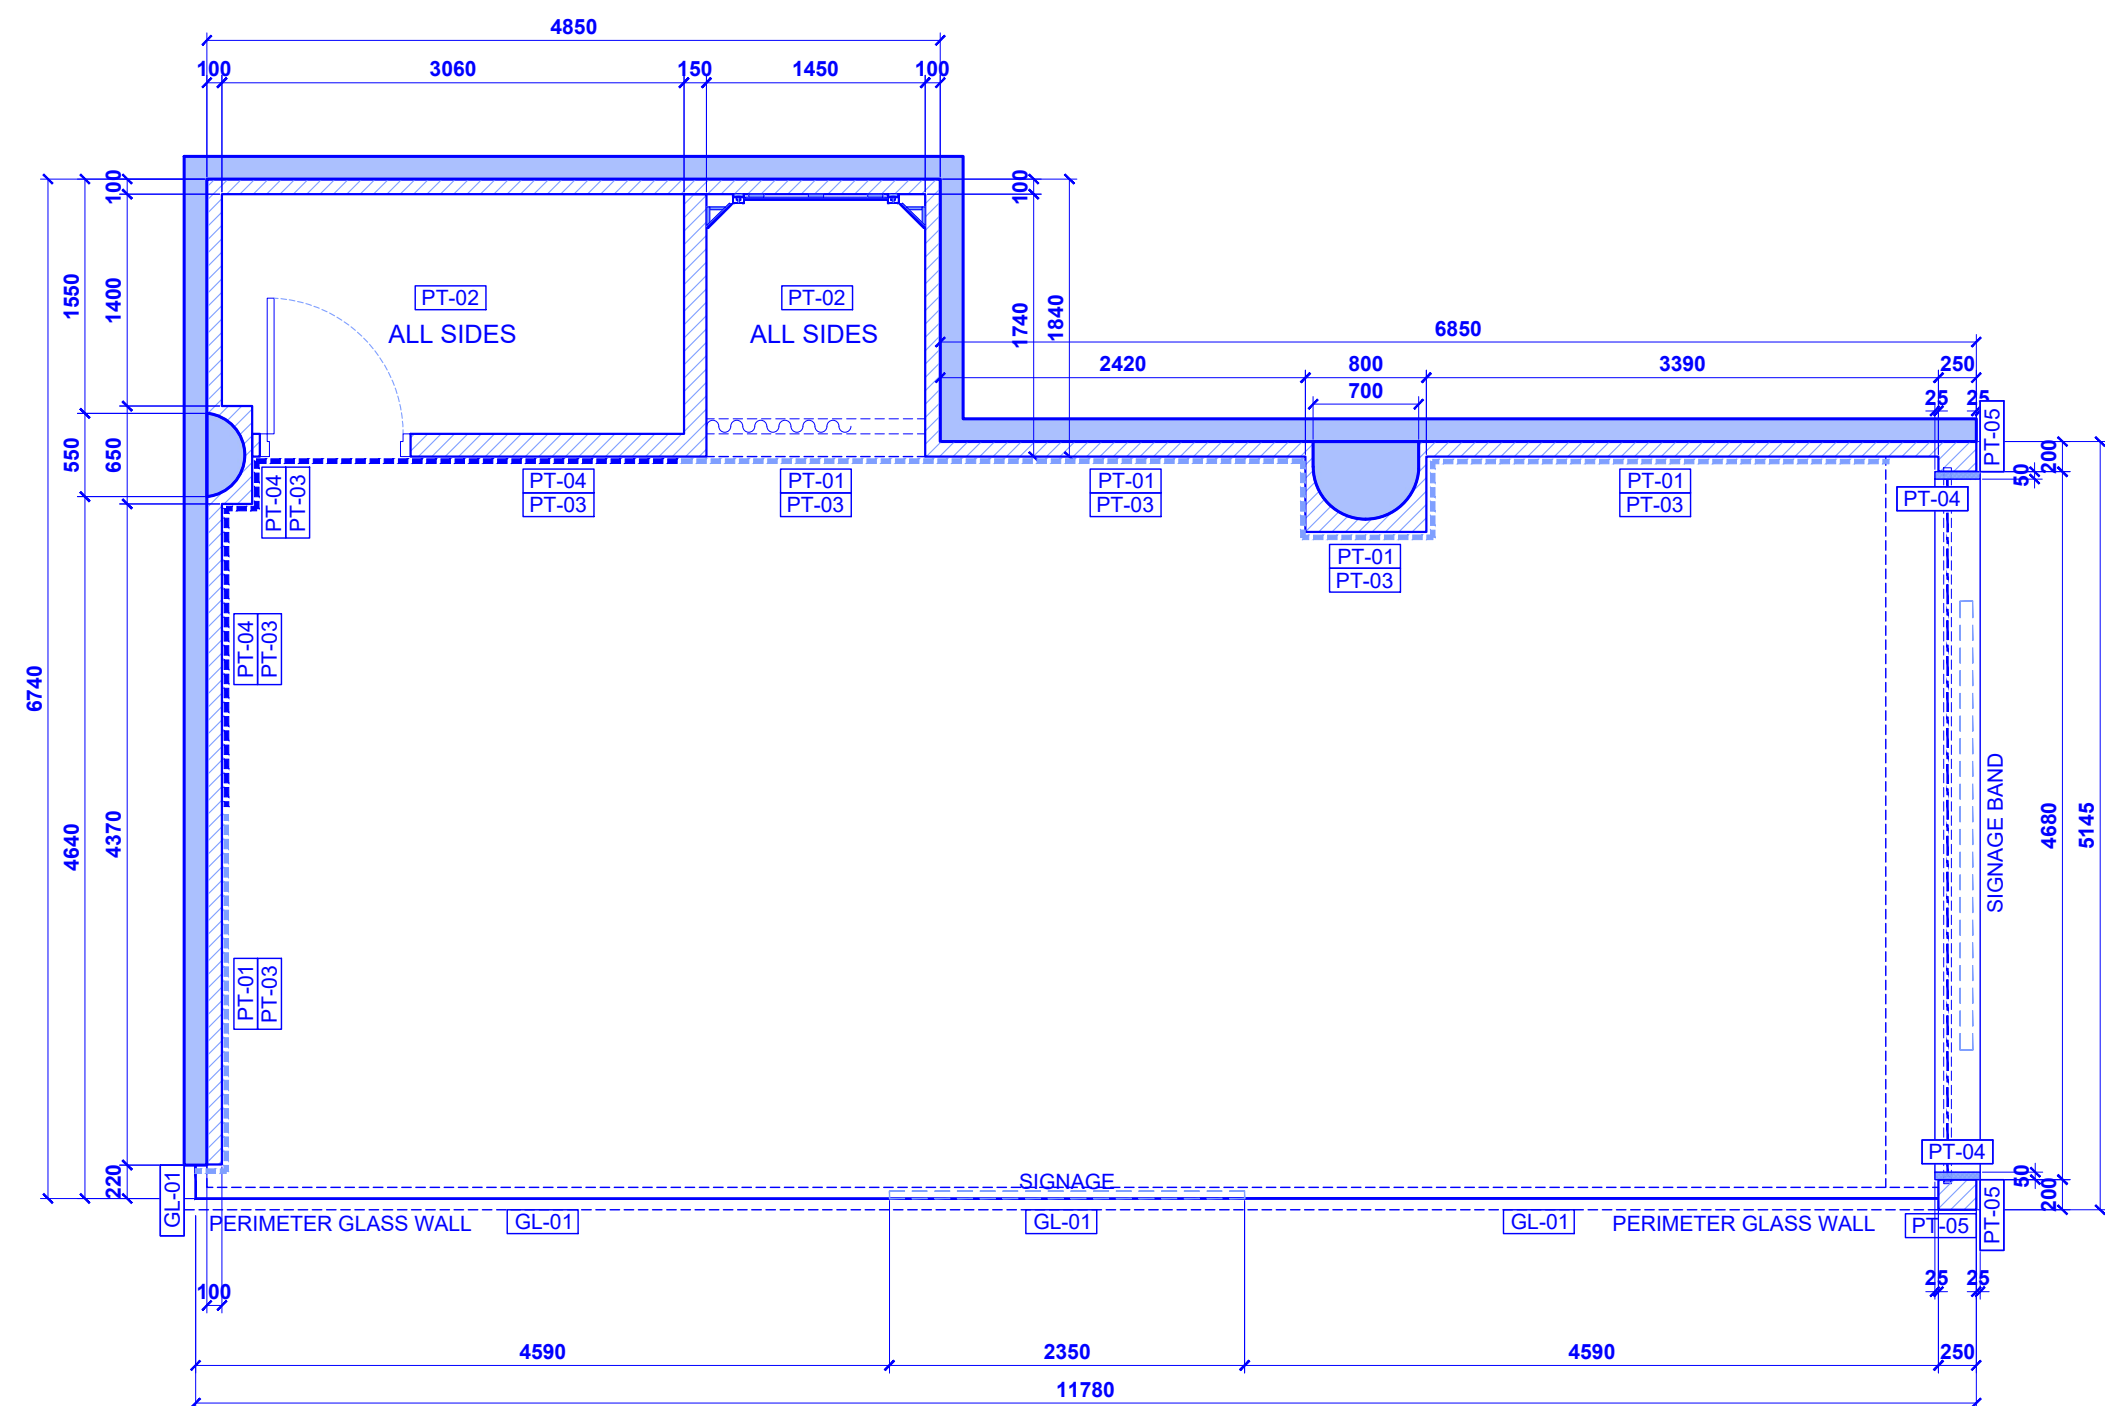

DECATHLON MARKET! MARKET! MALL
WALL FINISHING PLAN
SCALE 1:50 M

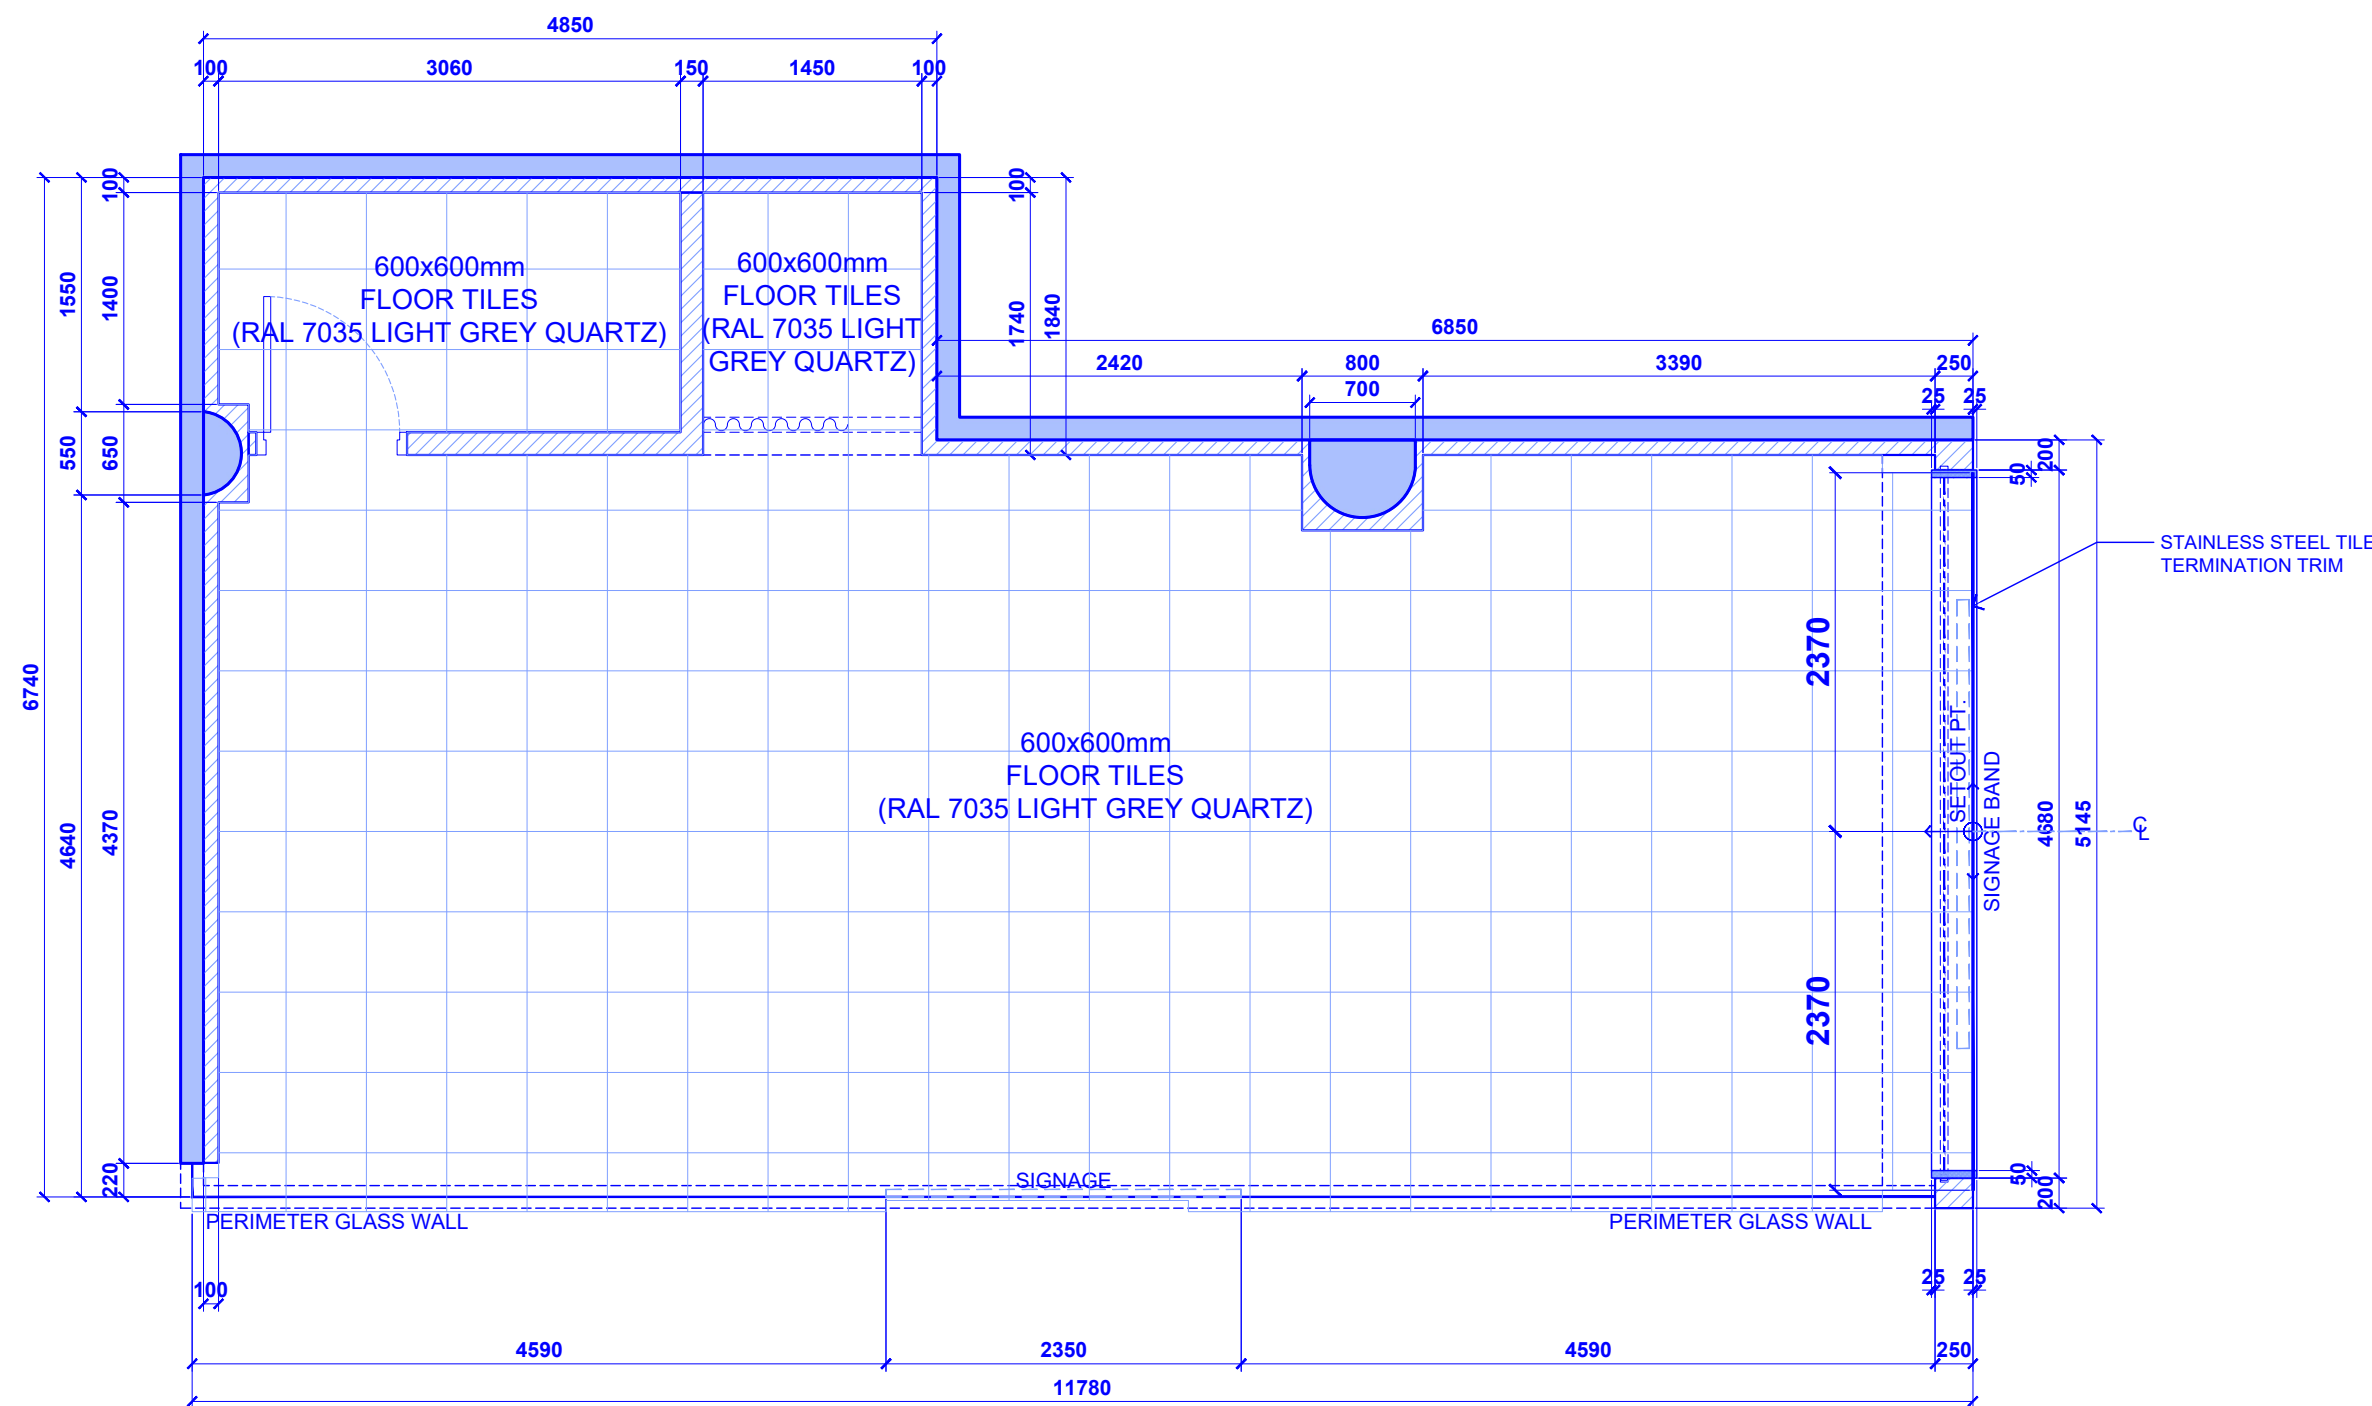

DECATHLON MARKET! MARKET! MALL
FLOOR PATTERN LAYOUT
SCALE 1:50 M

AS-BUILT PLAN



R.A.9266 Section 33

Drawing and specifications and other contract documents signed, stamped or sealed, as instruments of service, are the intellectual property and documents of the architect, whether the object for which they are made is executed or not, if shall be unlawful for any person to duplicate or to make copies of said documents for use in the repetition of and for other projects of building, whether executed partly in whole, without the written consent of architect or author of said documents.

ARCHITECT

PRC. NO.:	ISSUED :	VALID :
PTR NO. :	ISSUED :	PLACE :
TIN :		

SEAL

PROJECT TITLE

AS-BUILT OF
DECATHLON CONNECT
(71.95 SQM. INTERIOR RENOVATION)

LOCATION: Unit L1 224-225 Market! Market! McKinley Parkway, Bonifacio Global City, Taguig, Metro Manila

APPROVED BY

DECATHLON PHILIPPINES INC.
LAILA MONICA FLOR
OWNER

ADDRESS:

SHEET CONTENT

FLOOR PLAN
DIMENSIONAL PLAN
WALL FINISHING PLAN
FLOOR PATTERN LAYOUT

DESIGNED BY:

DRAFTED BY: SBMI

DATE ISSUED:

REVISIONS	DATE	REVISIONS	DATE
①		①	
②		②	
③		③	

THIS DRAWING IS ISSUED FOR :

☒ AS BUILT	☐ ESTIMATE
☐ BIDDING	☐ FABRICATION
☐ BUILDING PERMIT	☐ OWNER'S APPROVAL
☐ CONSTRUCTION	☐ PRESENTATION

SHEET NO.

A-2

02

07

ISSUANCE RECOMMENDED


SECTION HEAD: _____ **DATE** _____
ISSUED BY: _____

BUILDING OFFICIAL _____ **DATE** _____


LEGEND & SYMBOLS

	SYSTEM TRACKLIGHT (L01)
	DECATHLON ACCENT PERIMETER LIGHT UNIT
	LED FLAT PANEL LIGHT
	TRACK-LIGHT SYSTEM
	SURFACE MOUNTED DOWN LIGHT FIXTURE SUSPENDED TO SLAB
	EMERGENCY LIGHT
	EMERGENCY EXIT
	PANEL BOARD
	SWITCH BANK
	SMOKE DETECTOR
	CEILING MOUNTED SPEAKER
	CCTV - DOME CAMERA
	CCTV - 360° CAMERA
	DATA (IO PORT)
	VOICE/TELEPHONE (CAT 5e / CAT6)
	AMPLIFIER
	DIGITAL VIDEO RECORDER
	PENDENT SPRINKLER HEAD
	UPRIGHT SPRINKLER HEAD
	EXISTING SPRINKLER HEAD FROM MALL
	10lbs. CEILING MOUNTED HFC-236FA TYPE
	SUPPLY CEILING DIFFUSER 300mm x 300mm
	RETURN AIR GRILLE 300mm x 300mm
	EXHAUST FAN


AS-BUILT PLAN

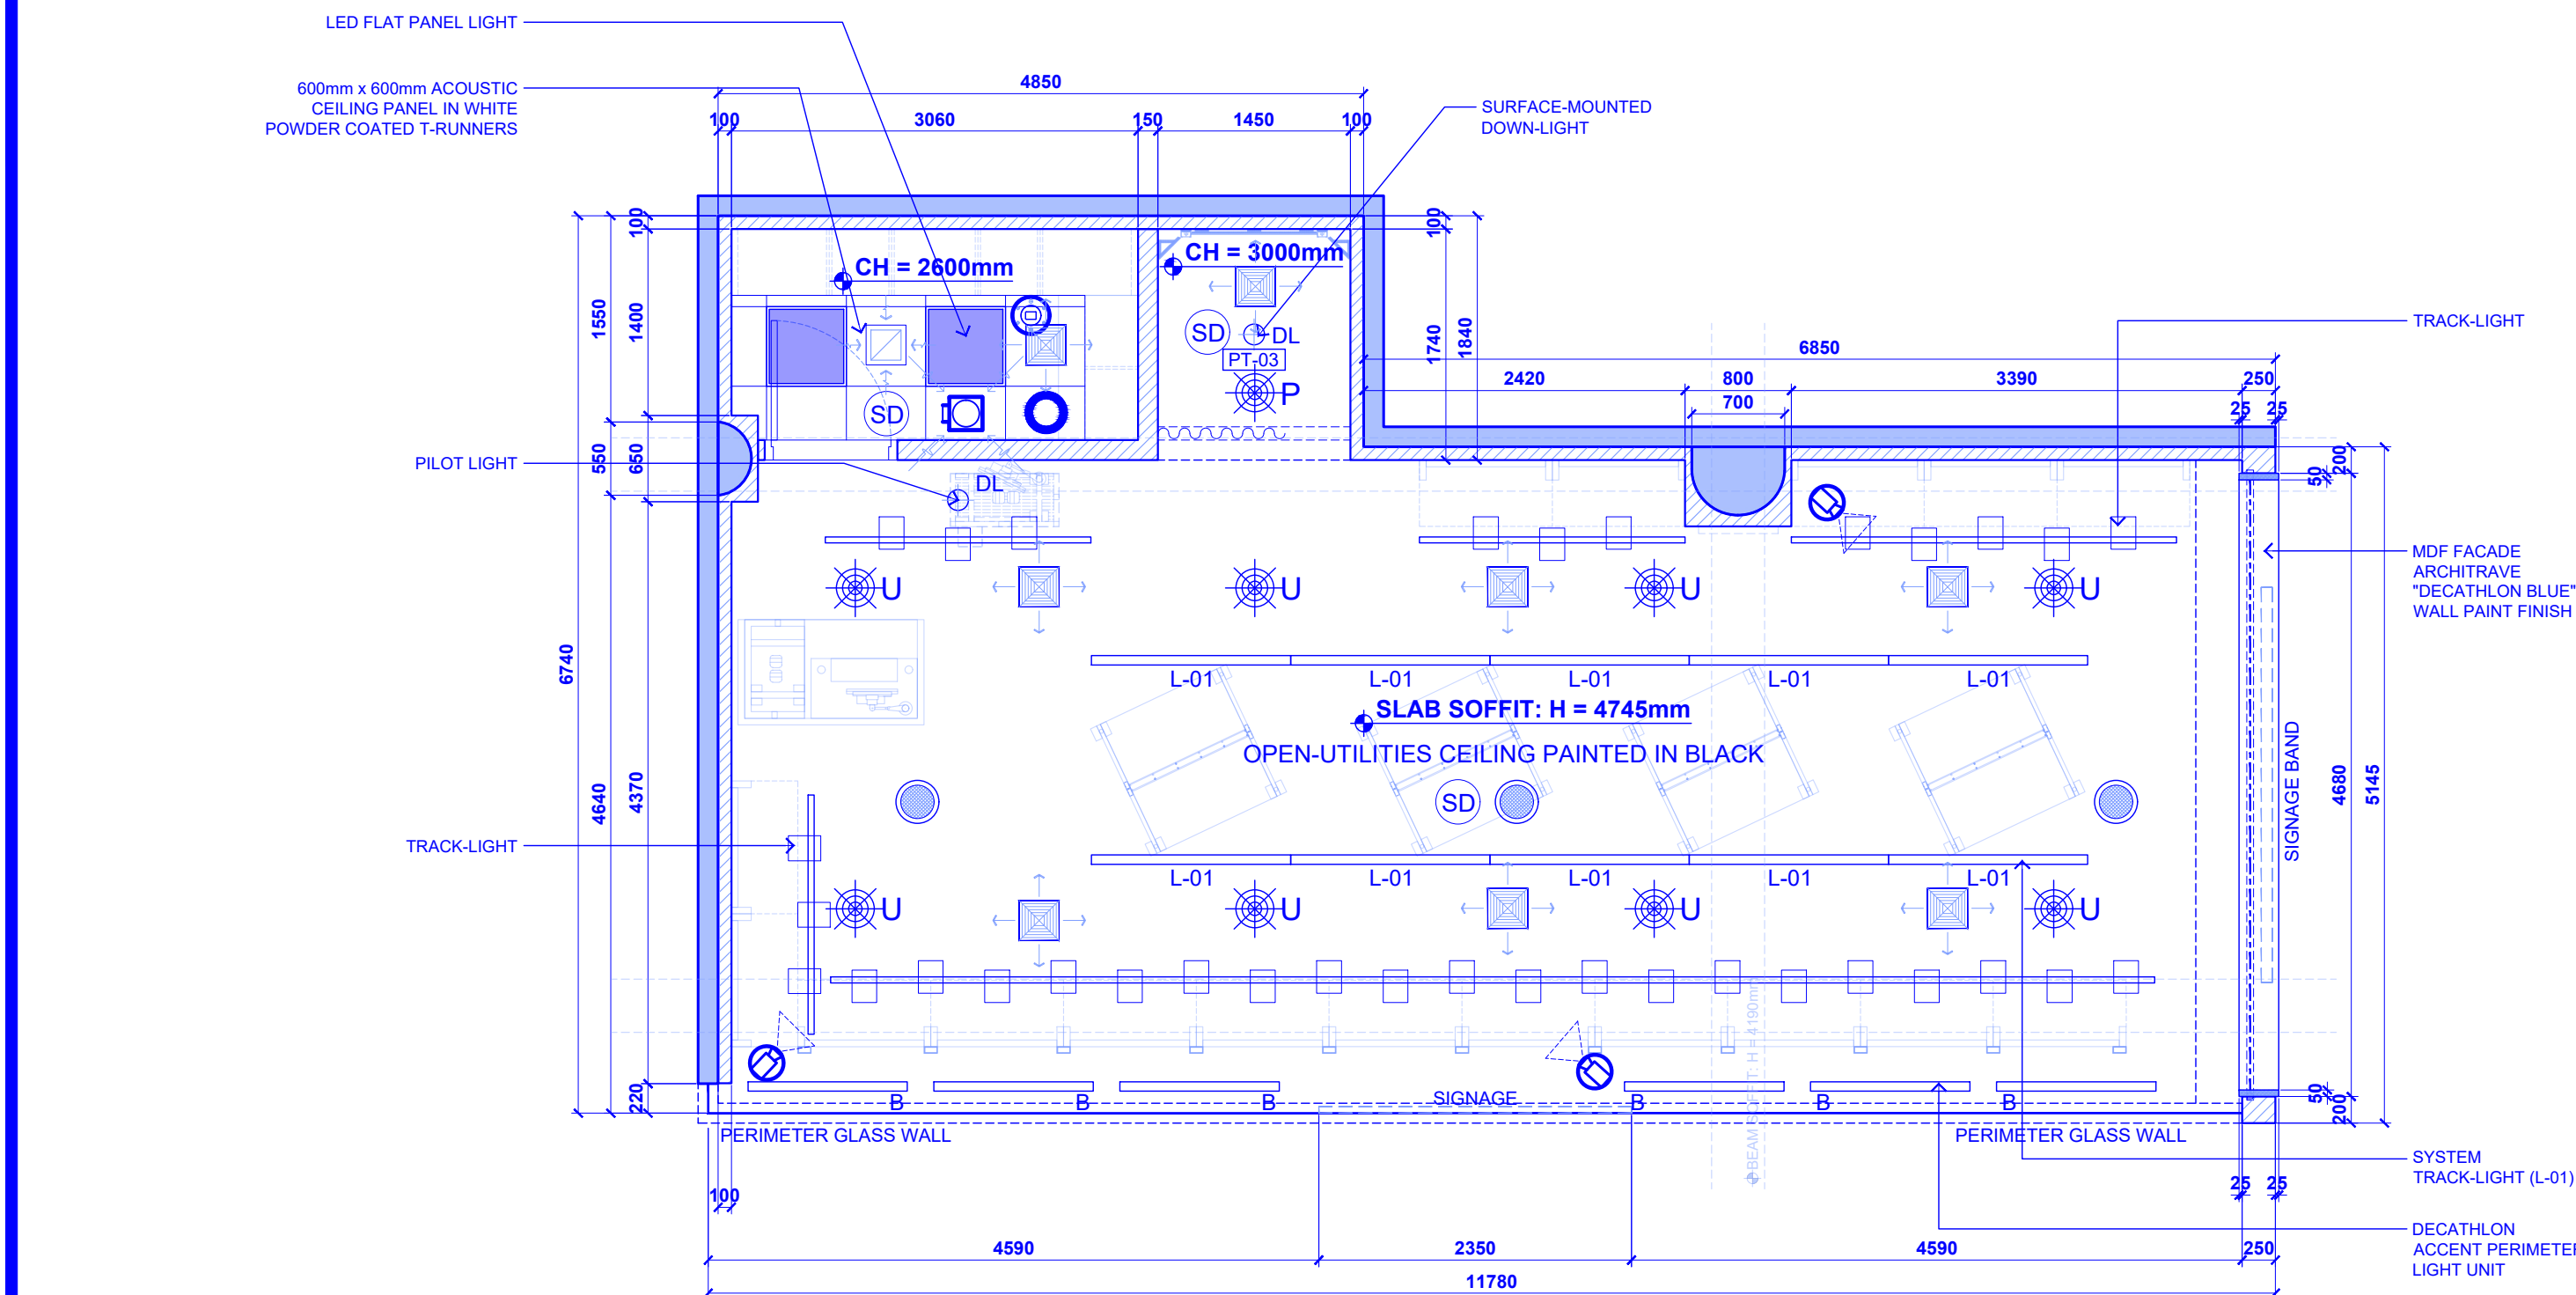


E REFLECTED CEILING PLAN
SCALE 1:50 M

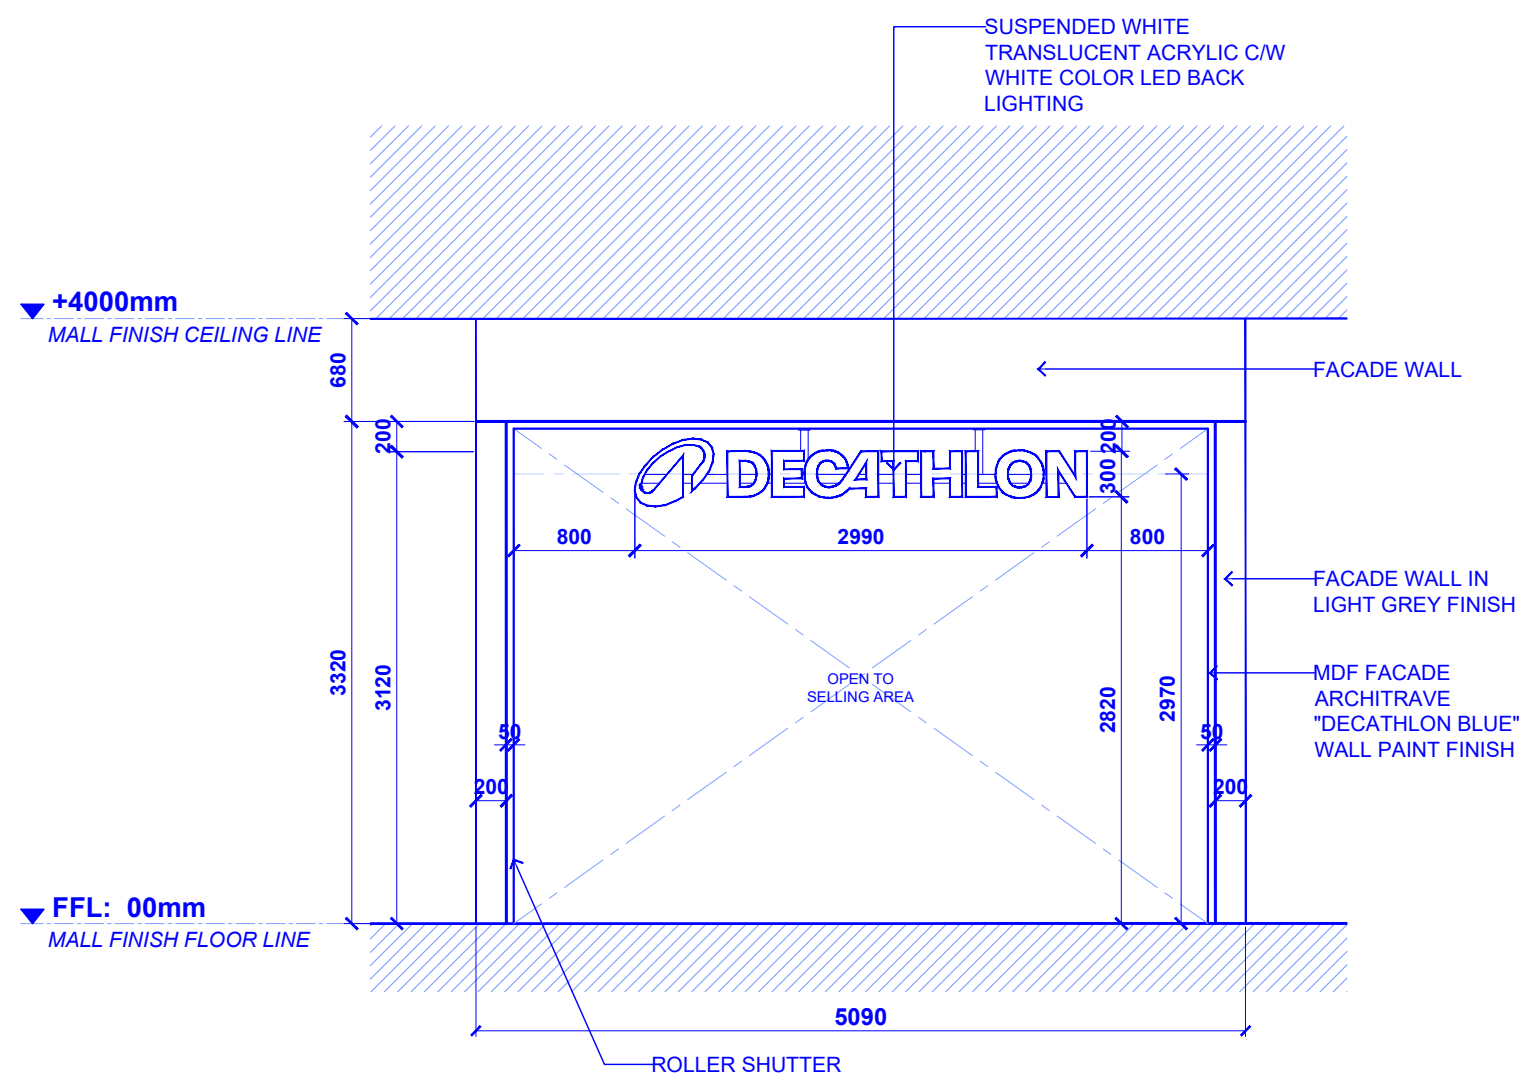

A STOREFRONT ELEVATION - A
SCALE 1:50 M

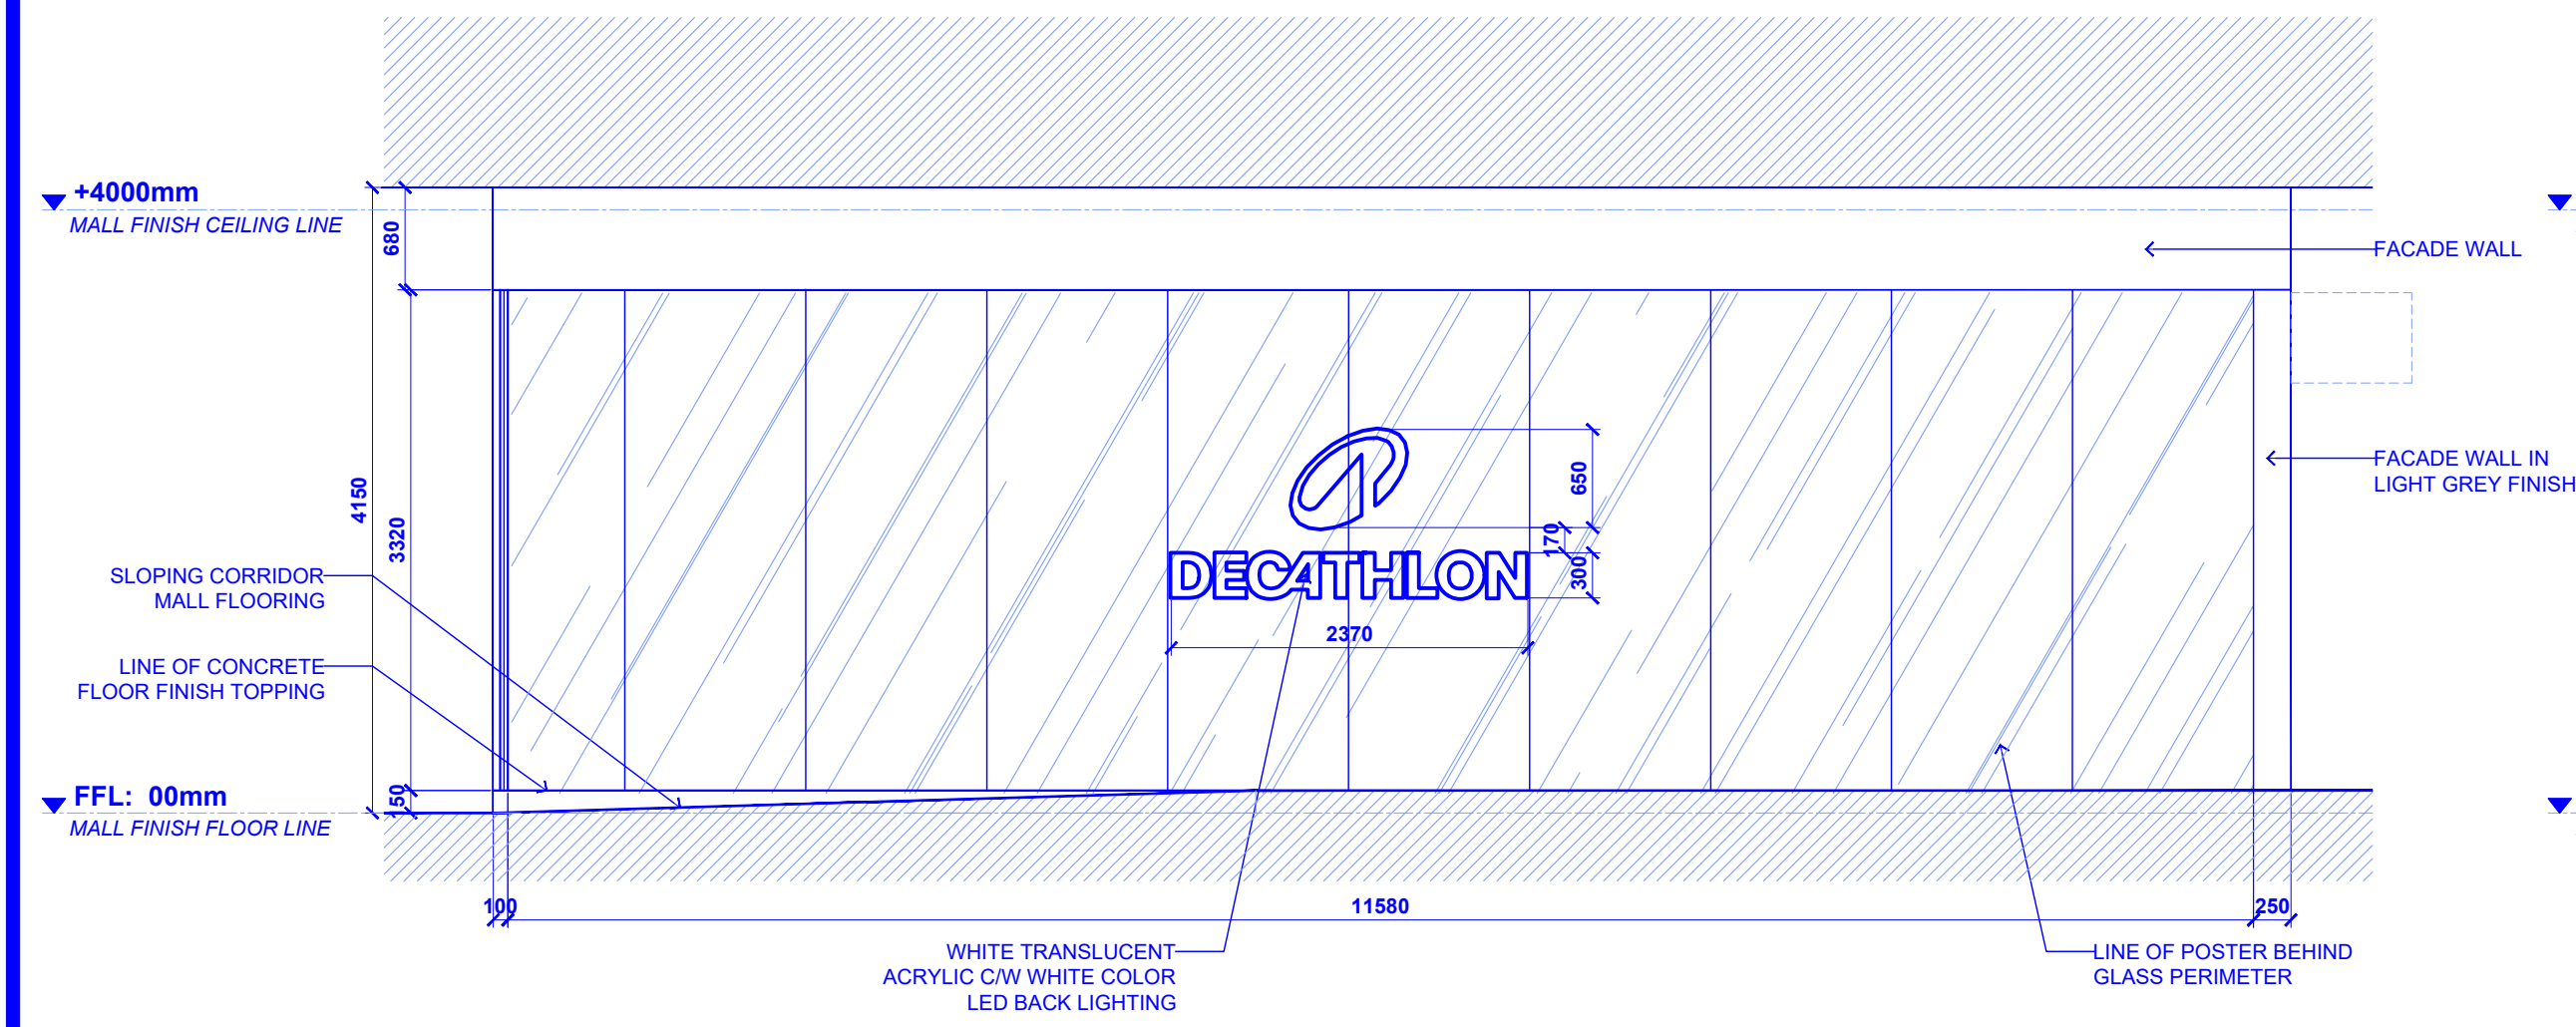

B INTERIOR ELEVATION - B
SCALE 1:50 M

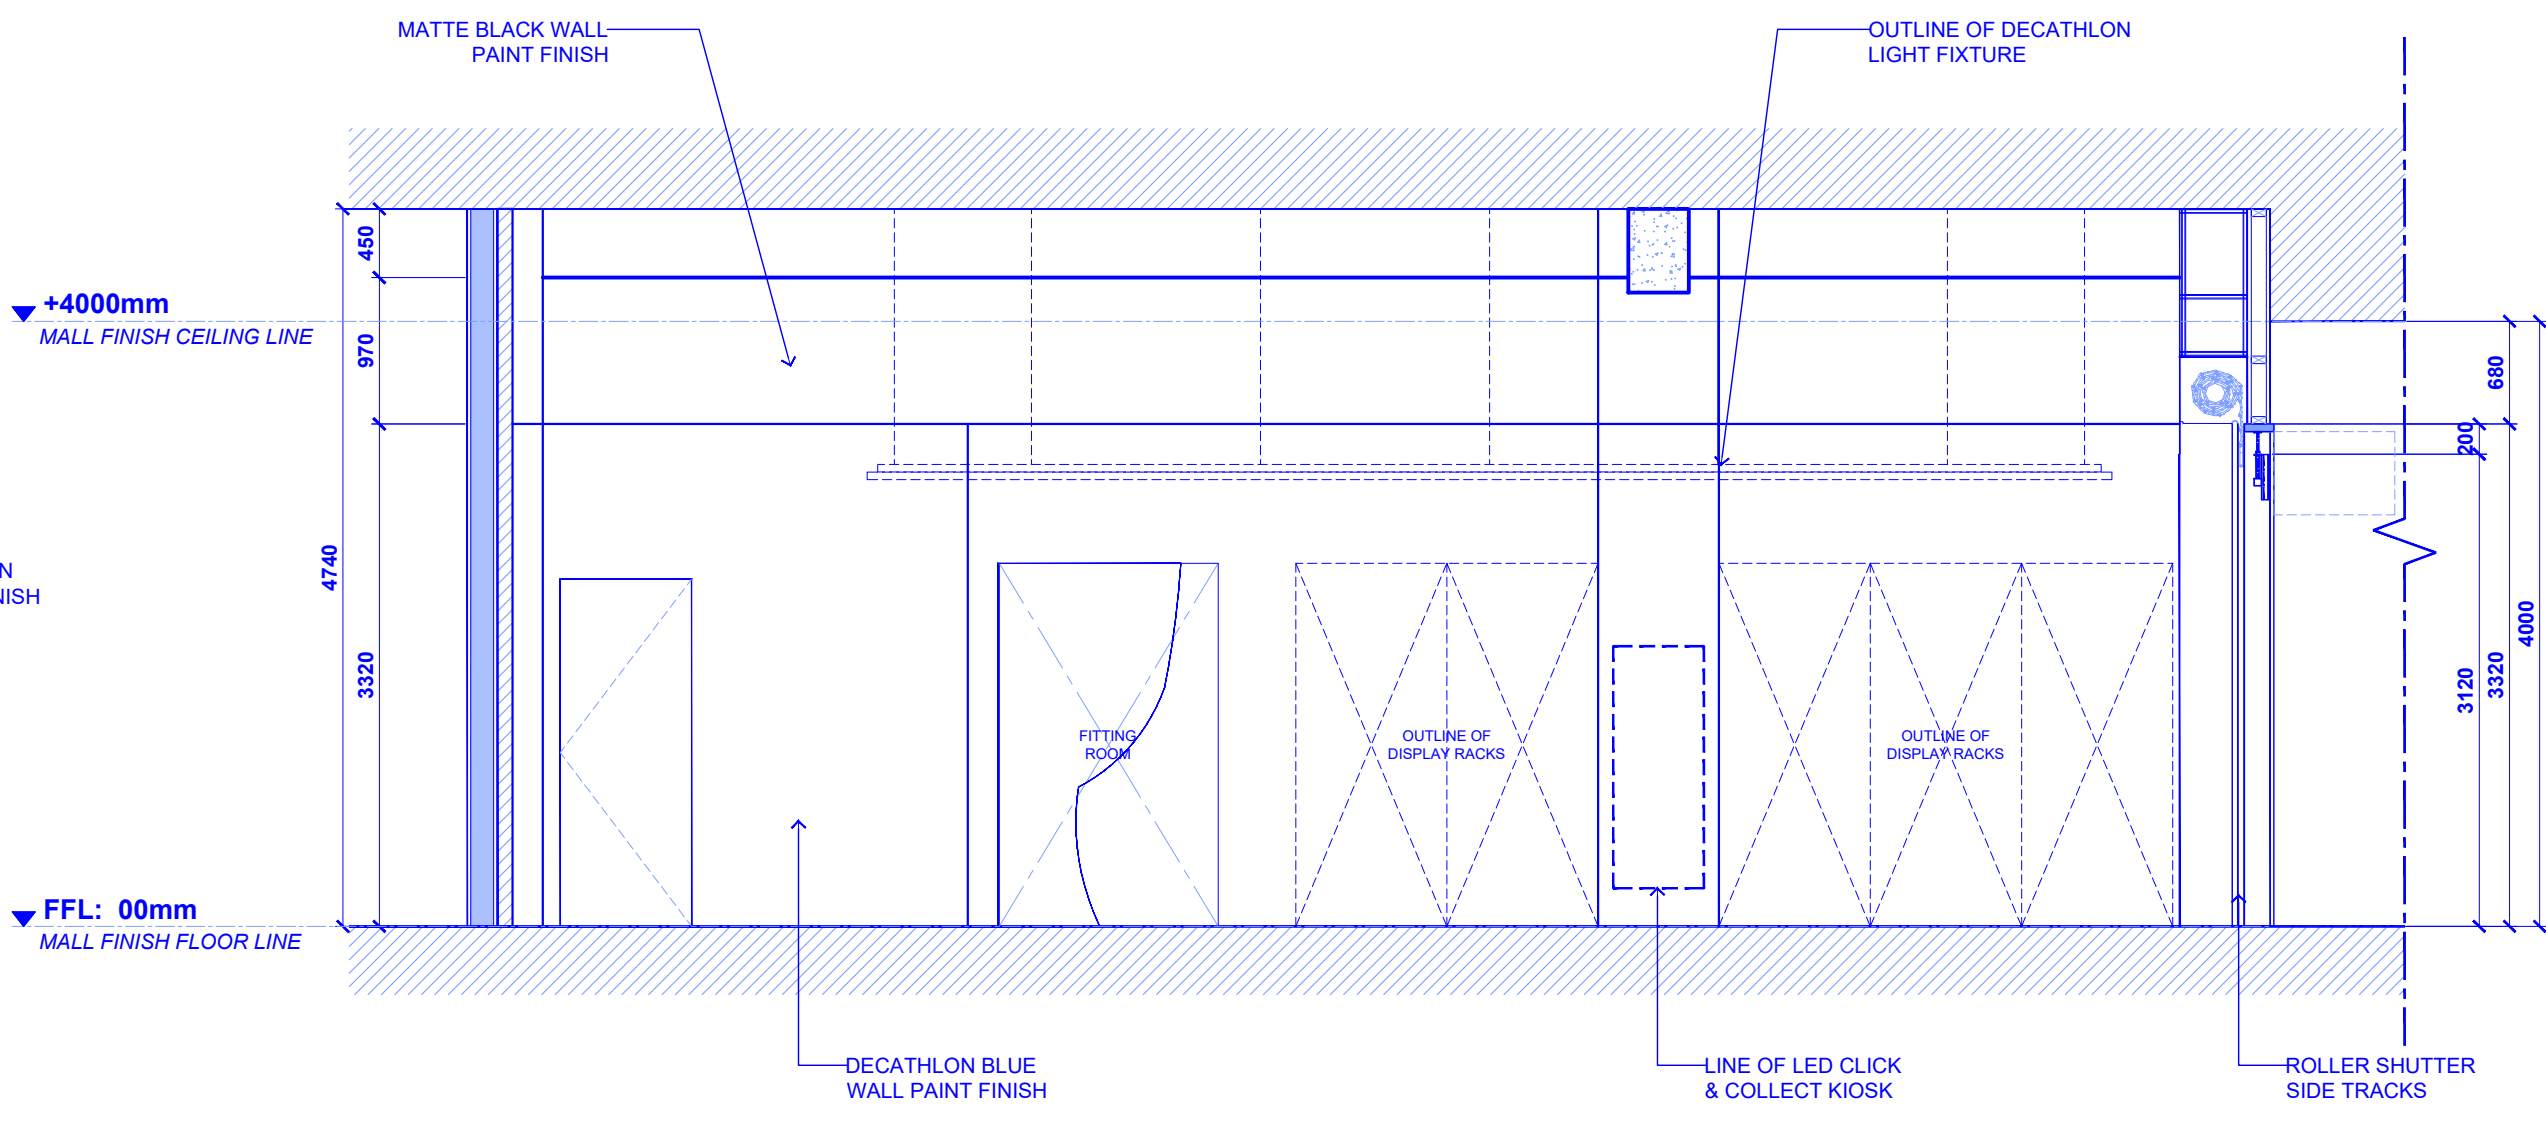

C INTERIOR ELEVATION - C
SCALE 1:75 M



R.A.9266 Section 33

Drawing and specifications and other contract documents signed, stamped or sealed, as instruments of service, are the intellectual property and documents of the architect, whether the object for which they are made is executed or not, if shall be unlawful for any person to duplicate or to make copies of said documents for use in the repetition of and for other projects of building, whether executed partly in whole, without the written consent of architect or author of said documents.

ARCHITECT

PRC. NO.:	ISSUED :	VALID :
PTR NO. :	ISSUED :	PLACE :
TIN :		

SEAL

PROJECT TITLE

AS-BUILT OF
DECATHLON CONNECT
(71.95 SQM. INTERIOR RENOVATION)

LOCATION: Unit L1 224-225 Market! Market! McKinley Parkway, Bonifacio Global City, Taguig, Metro Manila

APPROVED BY

DECATHLON PHILIPPINES INC.
LAILA MONICA FLOR
OWNER

ADDRESS:

SHEET CONTENT

REFLECTED CEILING PLAN
STOREFRONT ELEVATION - A
INTERIOR ELEVATION - B
INTERIOR ELEVATION - C

DESIGNED BY:

DRAFTED BY: SBMI

DATE ISSUED:

REVISIONS	DATE	REVISIONS	DATE
①		①	
②		②	
③		③	

THIS DRAWING IS ISSUED FOR :


☒ AS BUILT	☐ ESTIMATE
☐ BIDDING	☐ FABRICATION
☐ BUILDING PERMIT	☐ OWNER'S APPROVAL
☐ CONSTRUCTION	☐ PRESENTATION

SHEET NO.


A-3

03


07

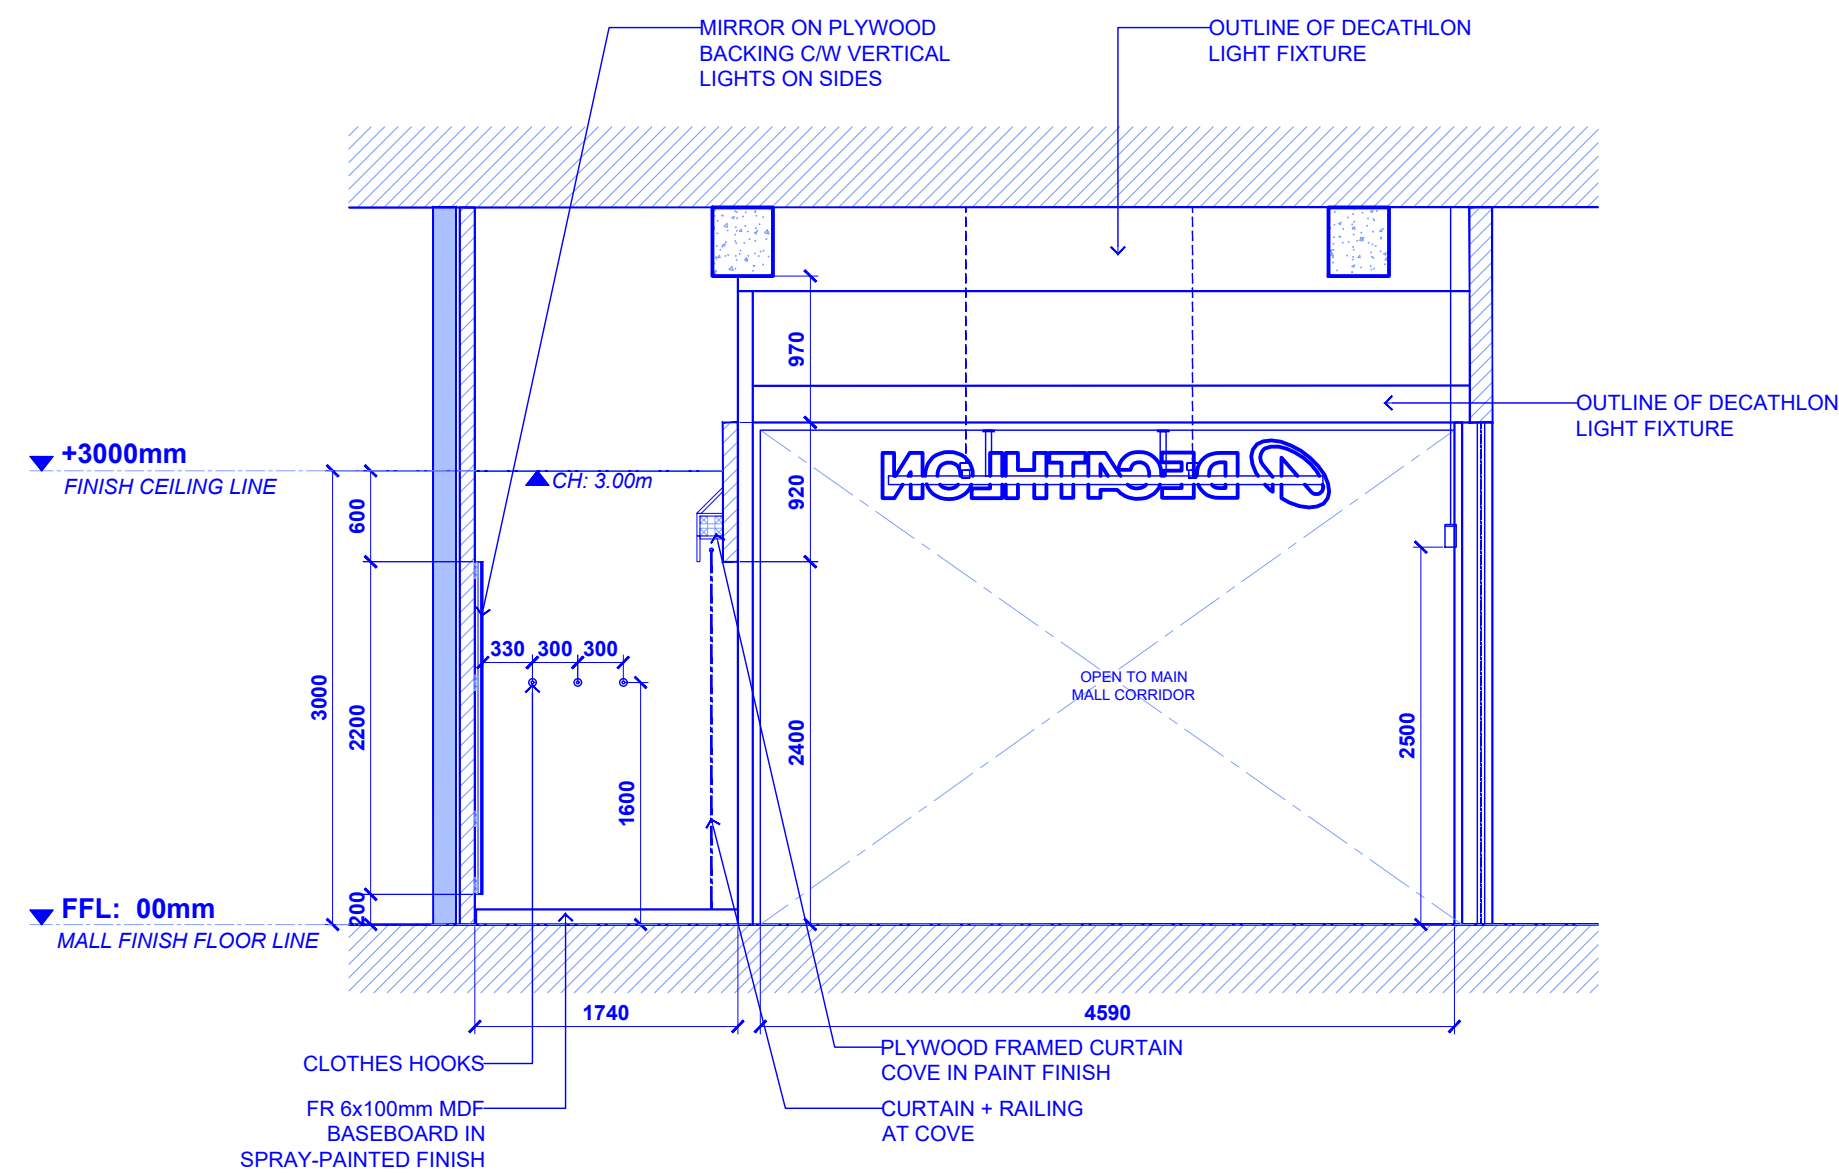


D
A-4 SCALE 1:50 M
INTERIOR ELEVATION - D

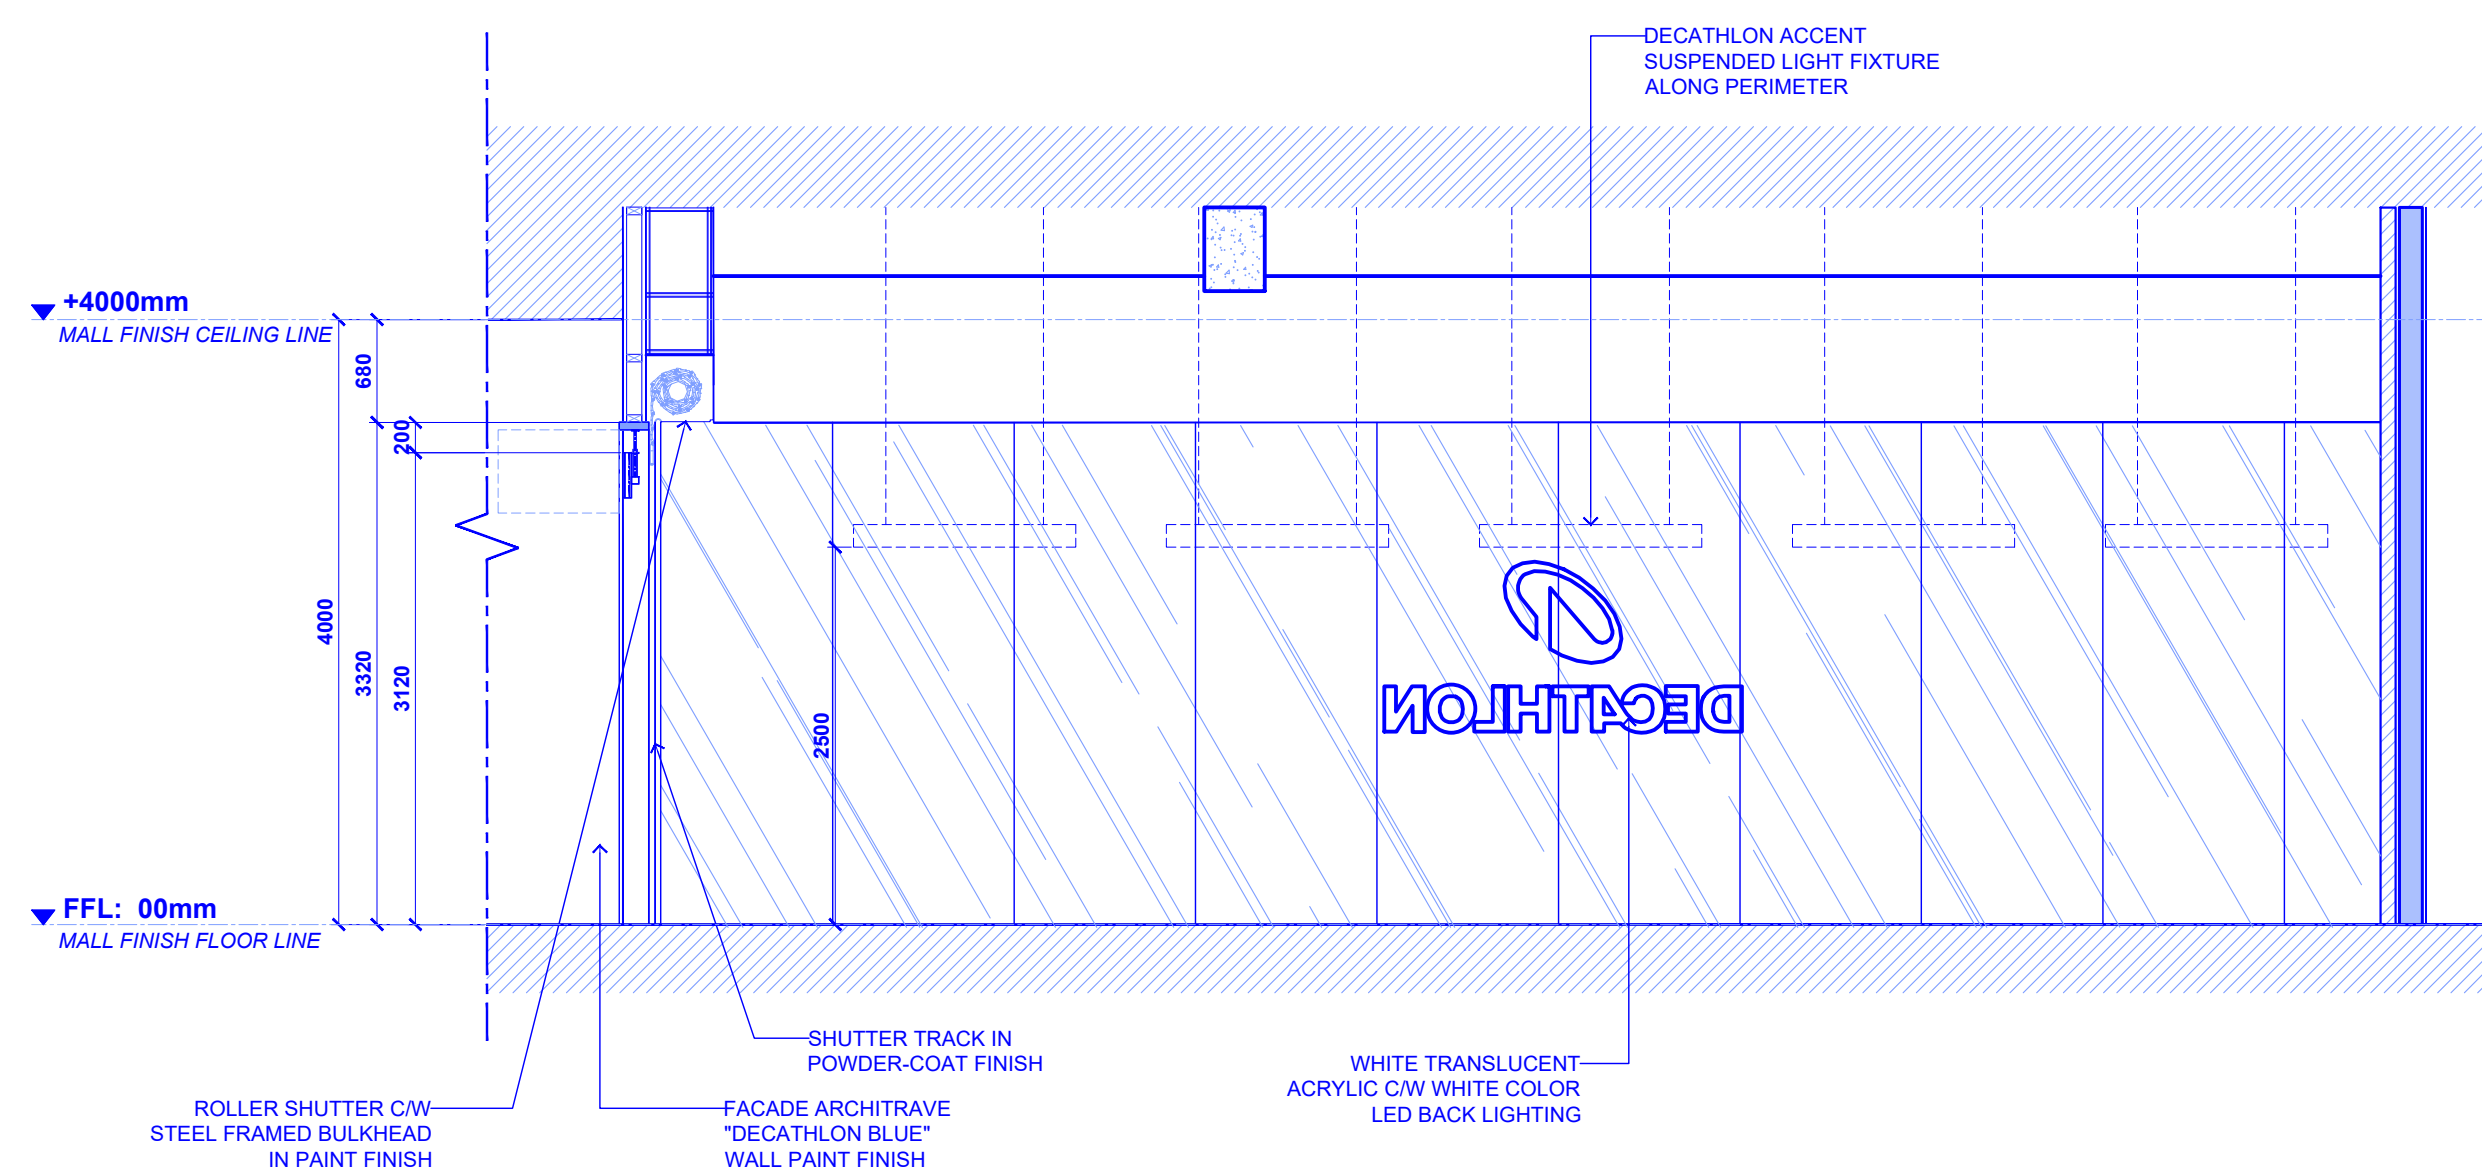


E
A-4 SCALE 1:50 M
INTERIOR ELEVATION - E

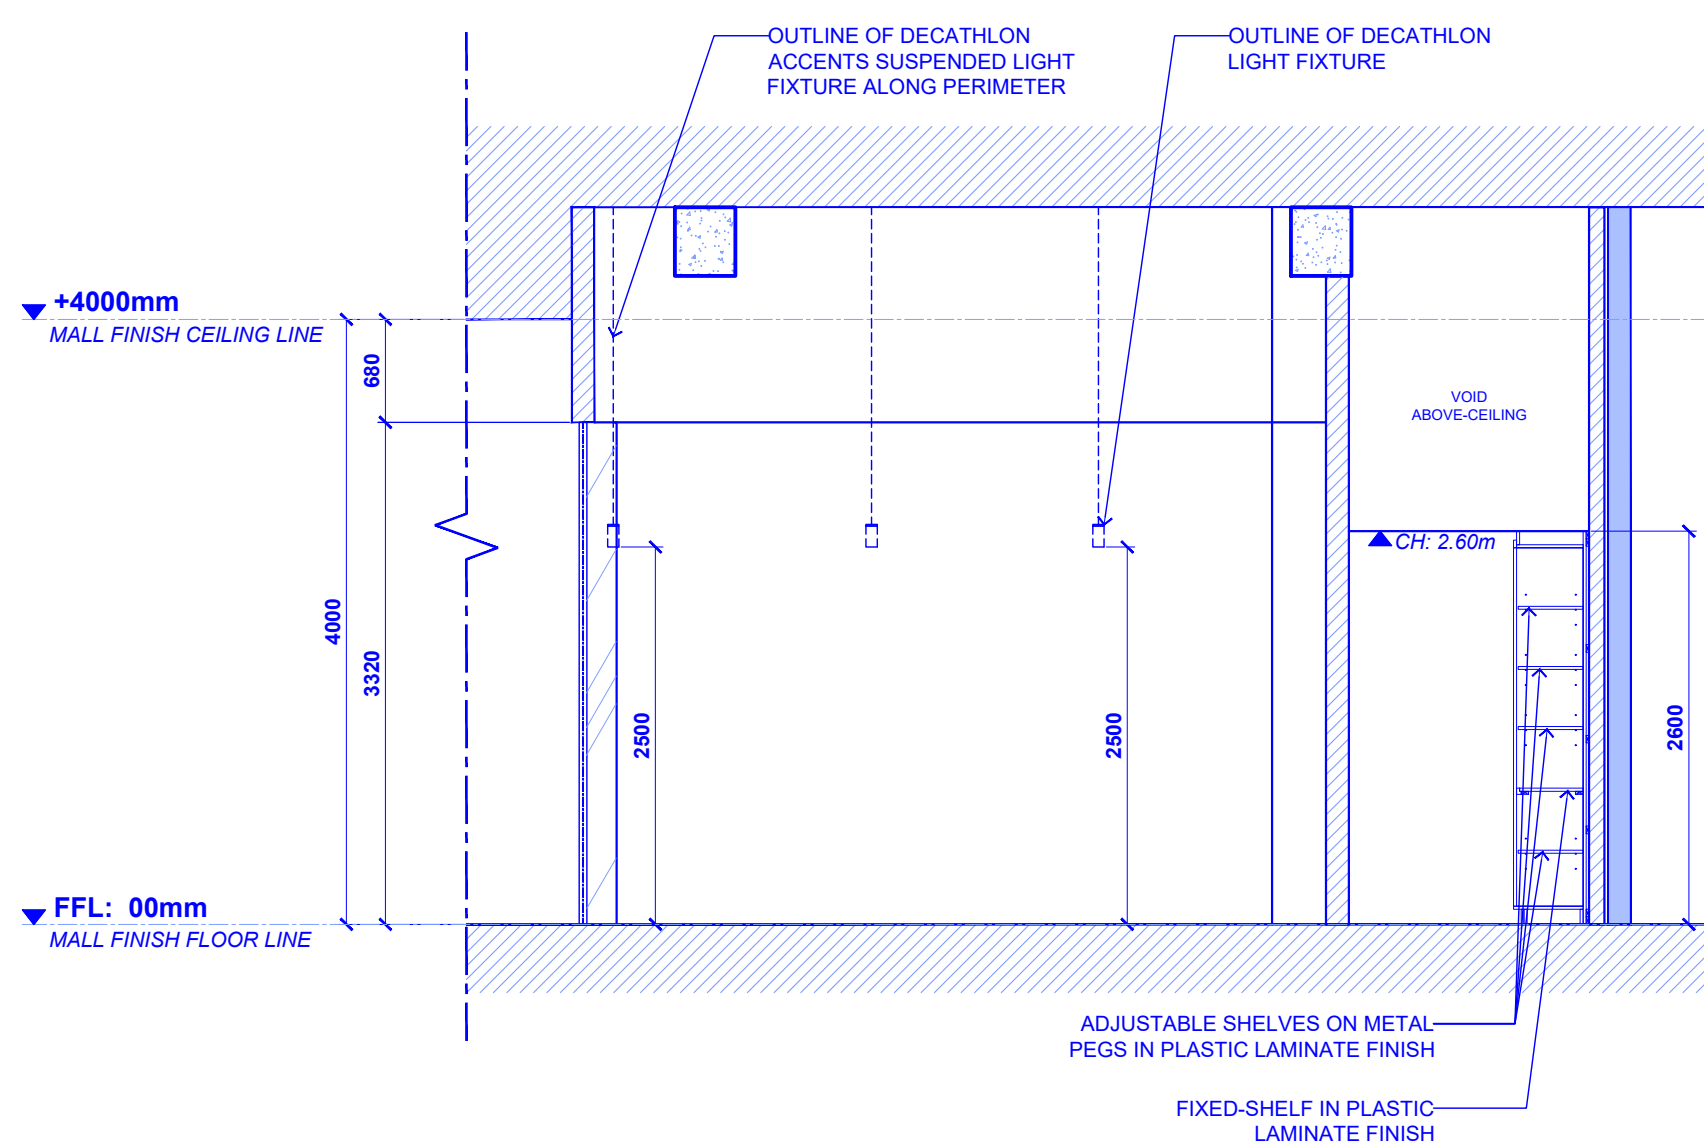

F
A-4 SCALE 1:50 M
INTERIOR ELEVATION - F

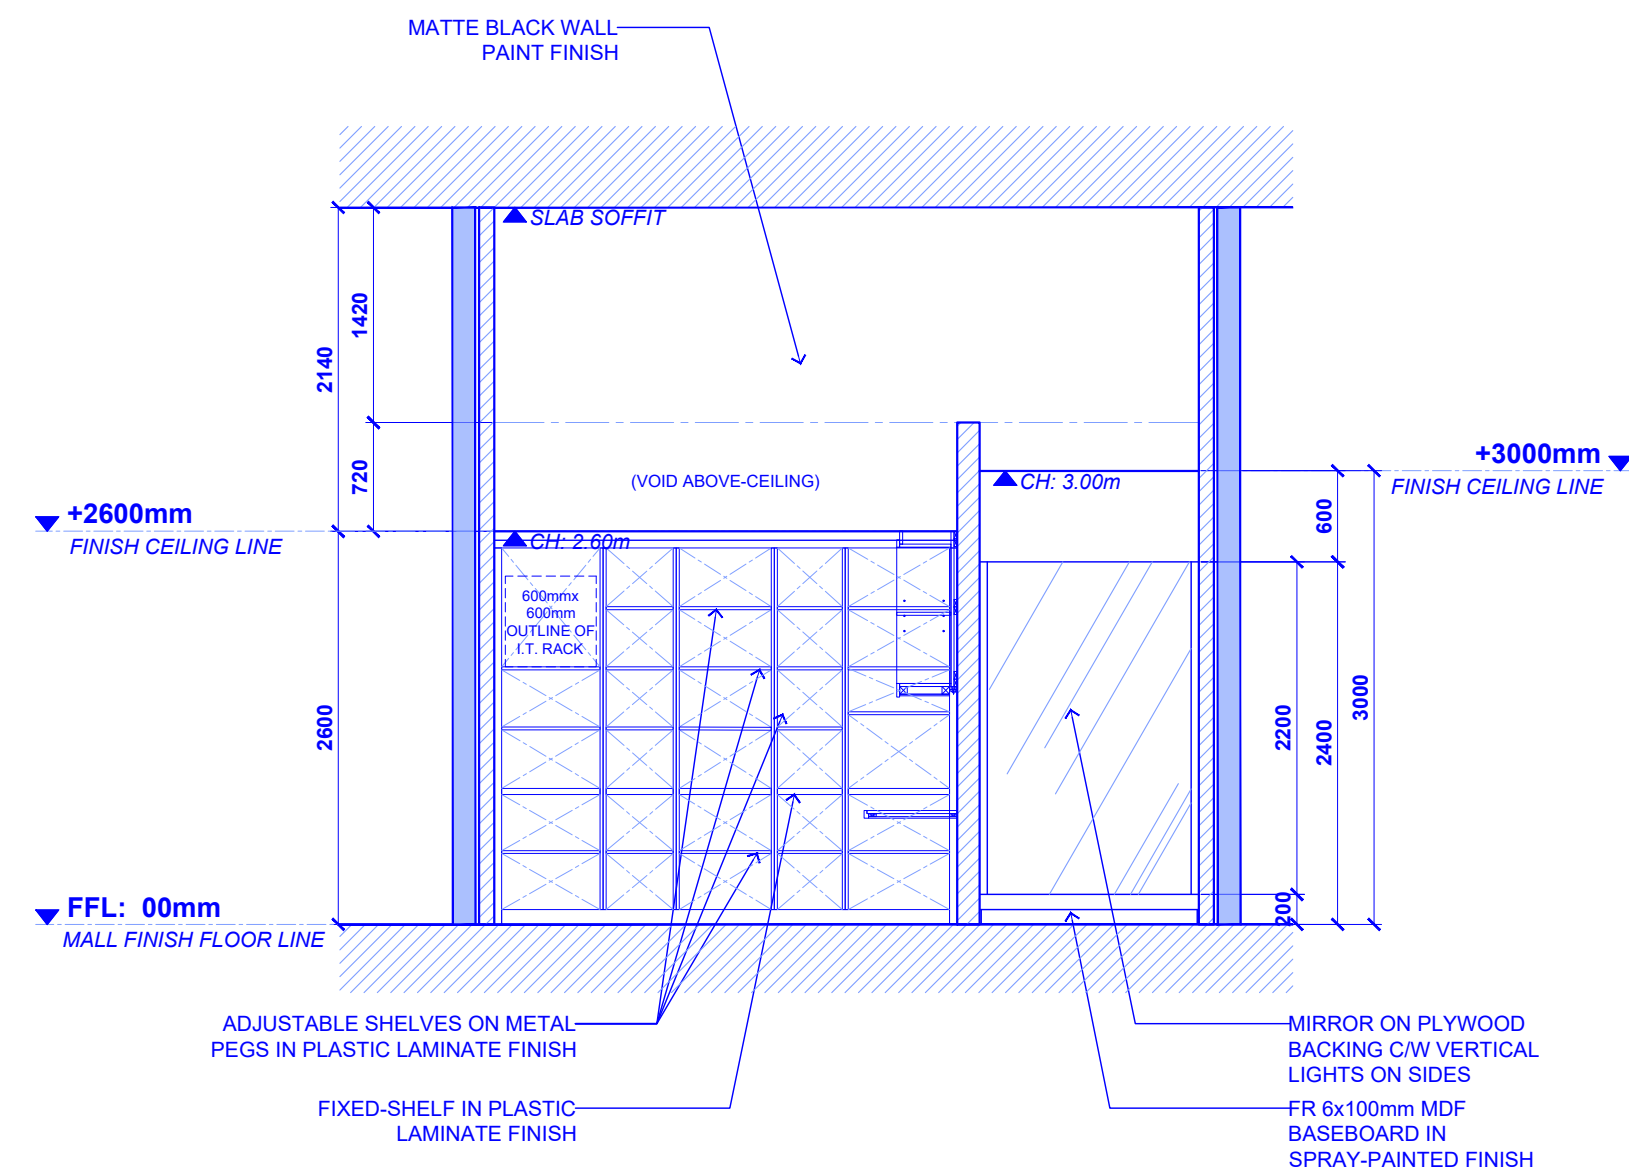

G
A-4 SCALE 1:50 M
INTERIOR ELEVATION - G

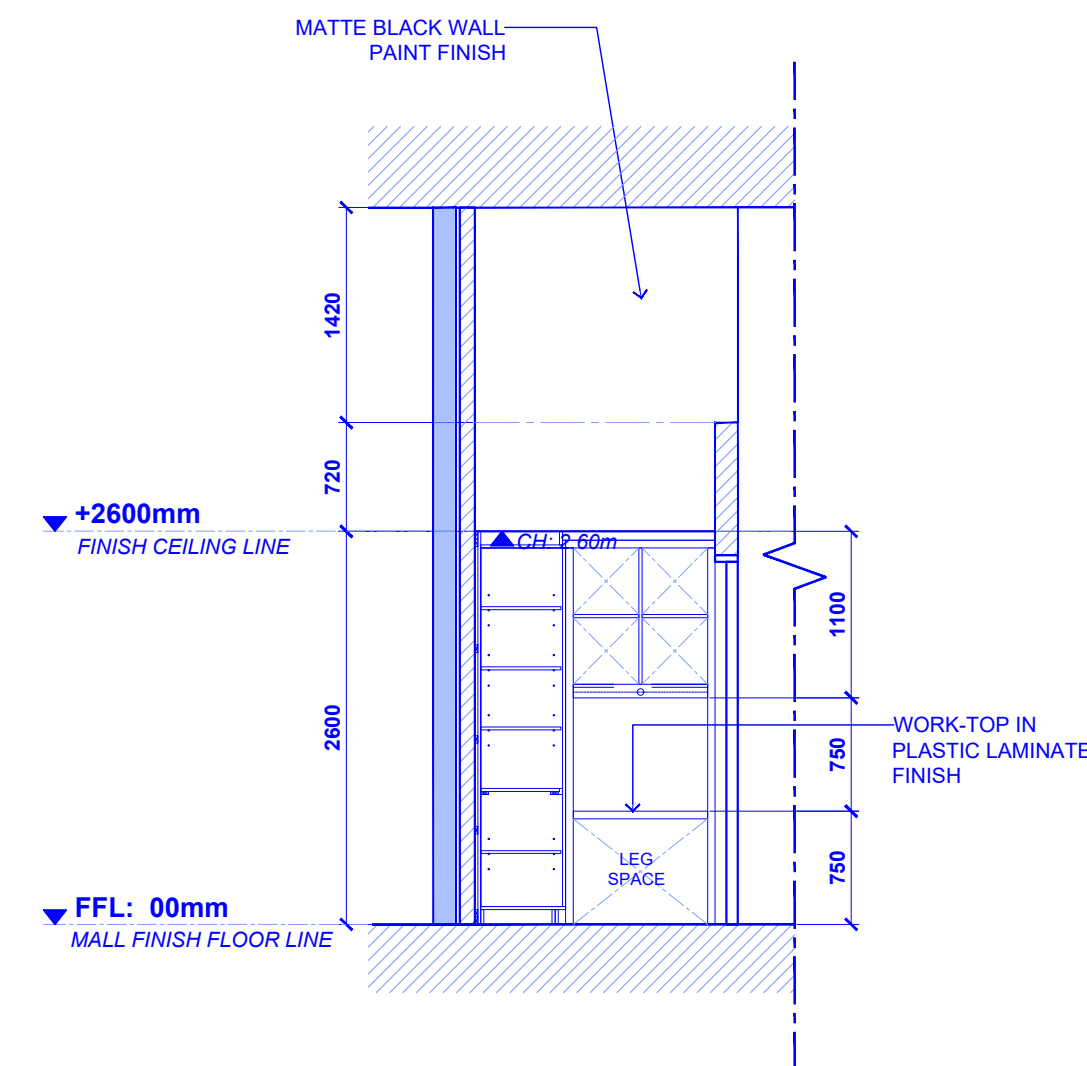

H
A-4 SCALE 1:50 M
INTERIOR ELEVATION - H

AS-BUILT PLAN



R.A.9266 Section 33

Drawing and specifications and other contract documents signed, stamped or sealed, as instruments of service, are the intellectual property and documents of the architect, whether the object for which they are made is executed or not, if shall be unlawful for any person to duplicate or to make copies of said documents for use in the repetition of and for other projects of building, whether executed partly in whole, without the written consent of architect or author of said documents.

ARCHITECT

PRC. NO.:	ISSUED :	VALID :
PTR NO. :	ISSUED :	PLACE :
TIN :		

SEAL

PROJECT TITLE

AS-BUILT OF
DECATHLON CONNECT
(71.95 SQM. INTERIOR RENOVATION)

LOCATION: Unit L1 224-225 Market! Market! McKinley Parkway, Bonifacio Global City, Taguig, Metro Manila

APPROVED BY

DECATHLON PHILIPPINES INC.
LAILA MONICA FLOR
OWNER

ADDRESS:

SHEET CONTENT

-INTERIOR ELEVATION - D
-INTERIOR ELEVATION - E
-INTERIOR ELEVATION - F
-INTERIOR ELEVATION - G
-INTERIOR ELEVATION - H

DESIGNED BY:

DRAFTED BY: SBMI

DATE ISSUED:

REVISIONS	DATE	REVISIONS	DATE
①		①	
②		②	
③		③	

THIS DRAWING IS ISSUED FOR :









☒ AS BUILT	☐ ESTIMATE
☐ BIDDING	☐ FABRICATION
☐ BUILDING PERMIT	☐ OWNER'S APPROVAL
☐ CONSTRUCTION	☐ PRESENTATION

SHEET NO.

A-4

04

07

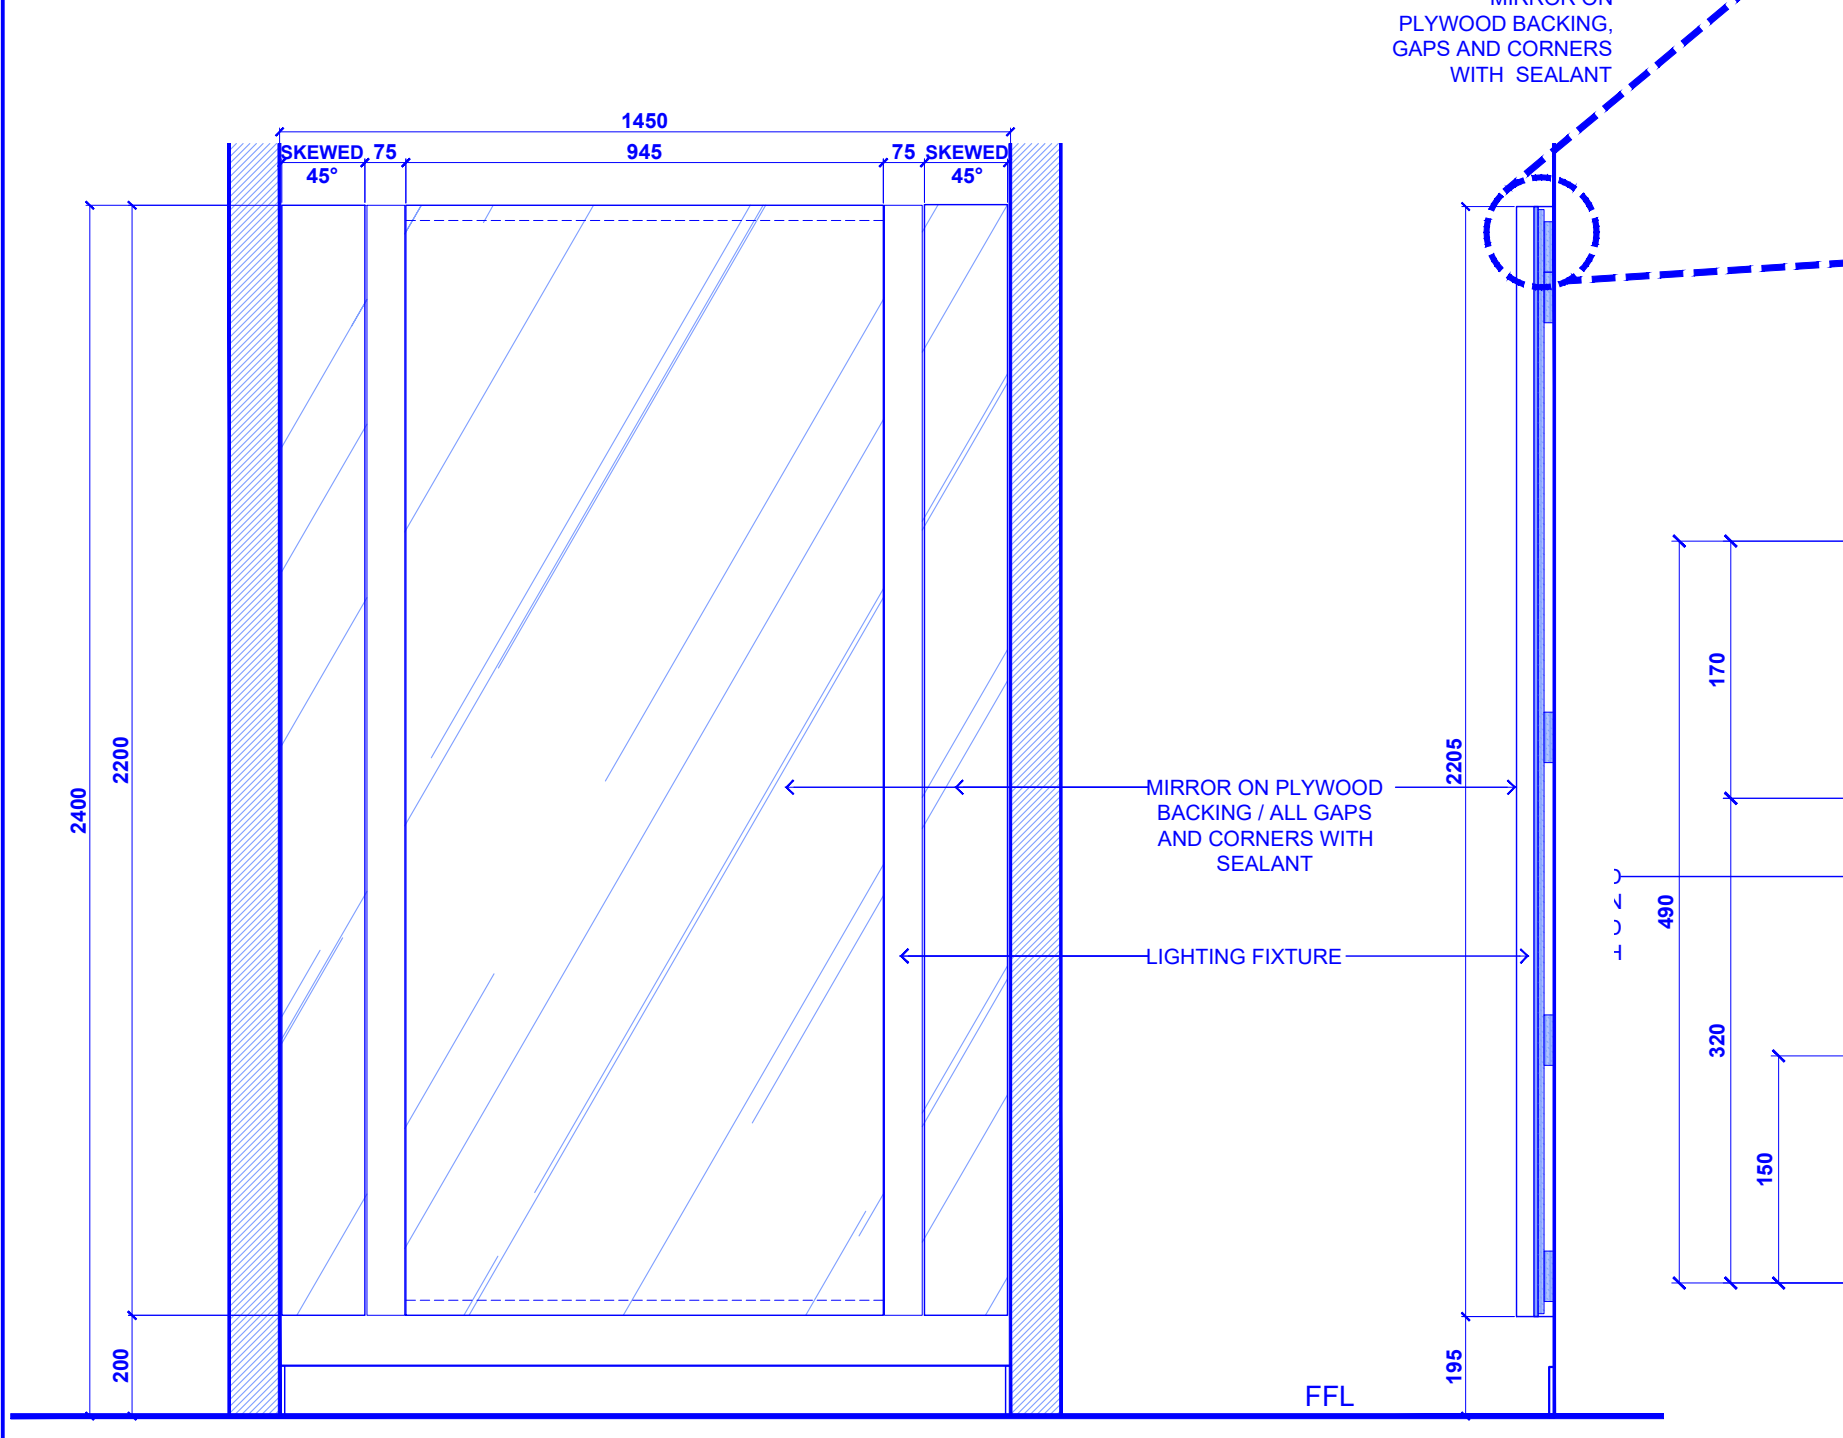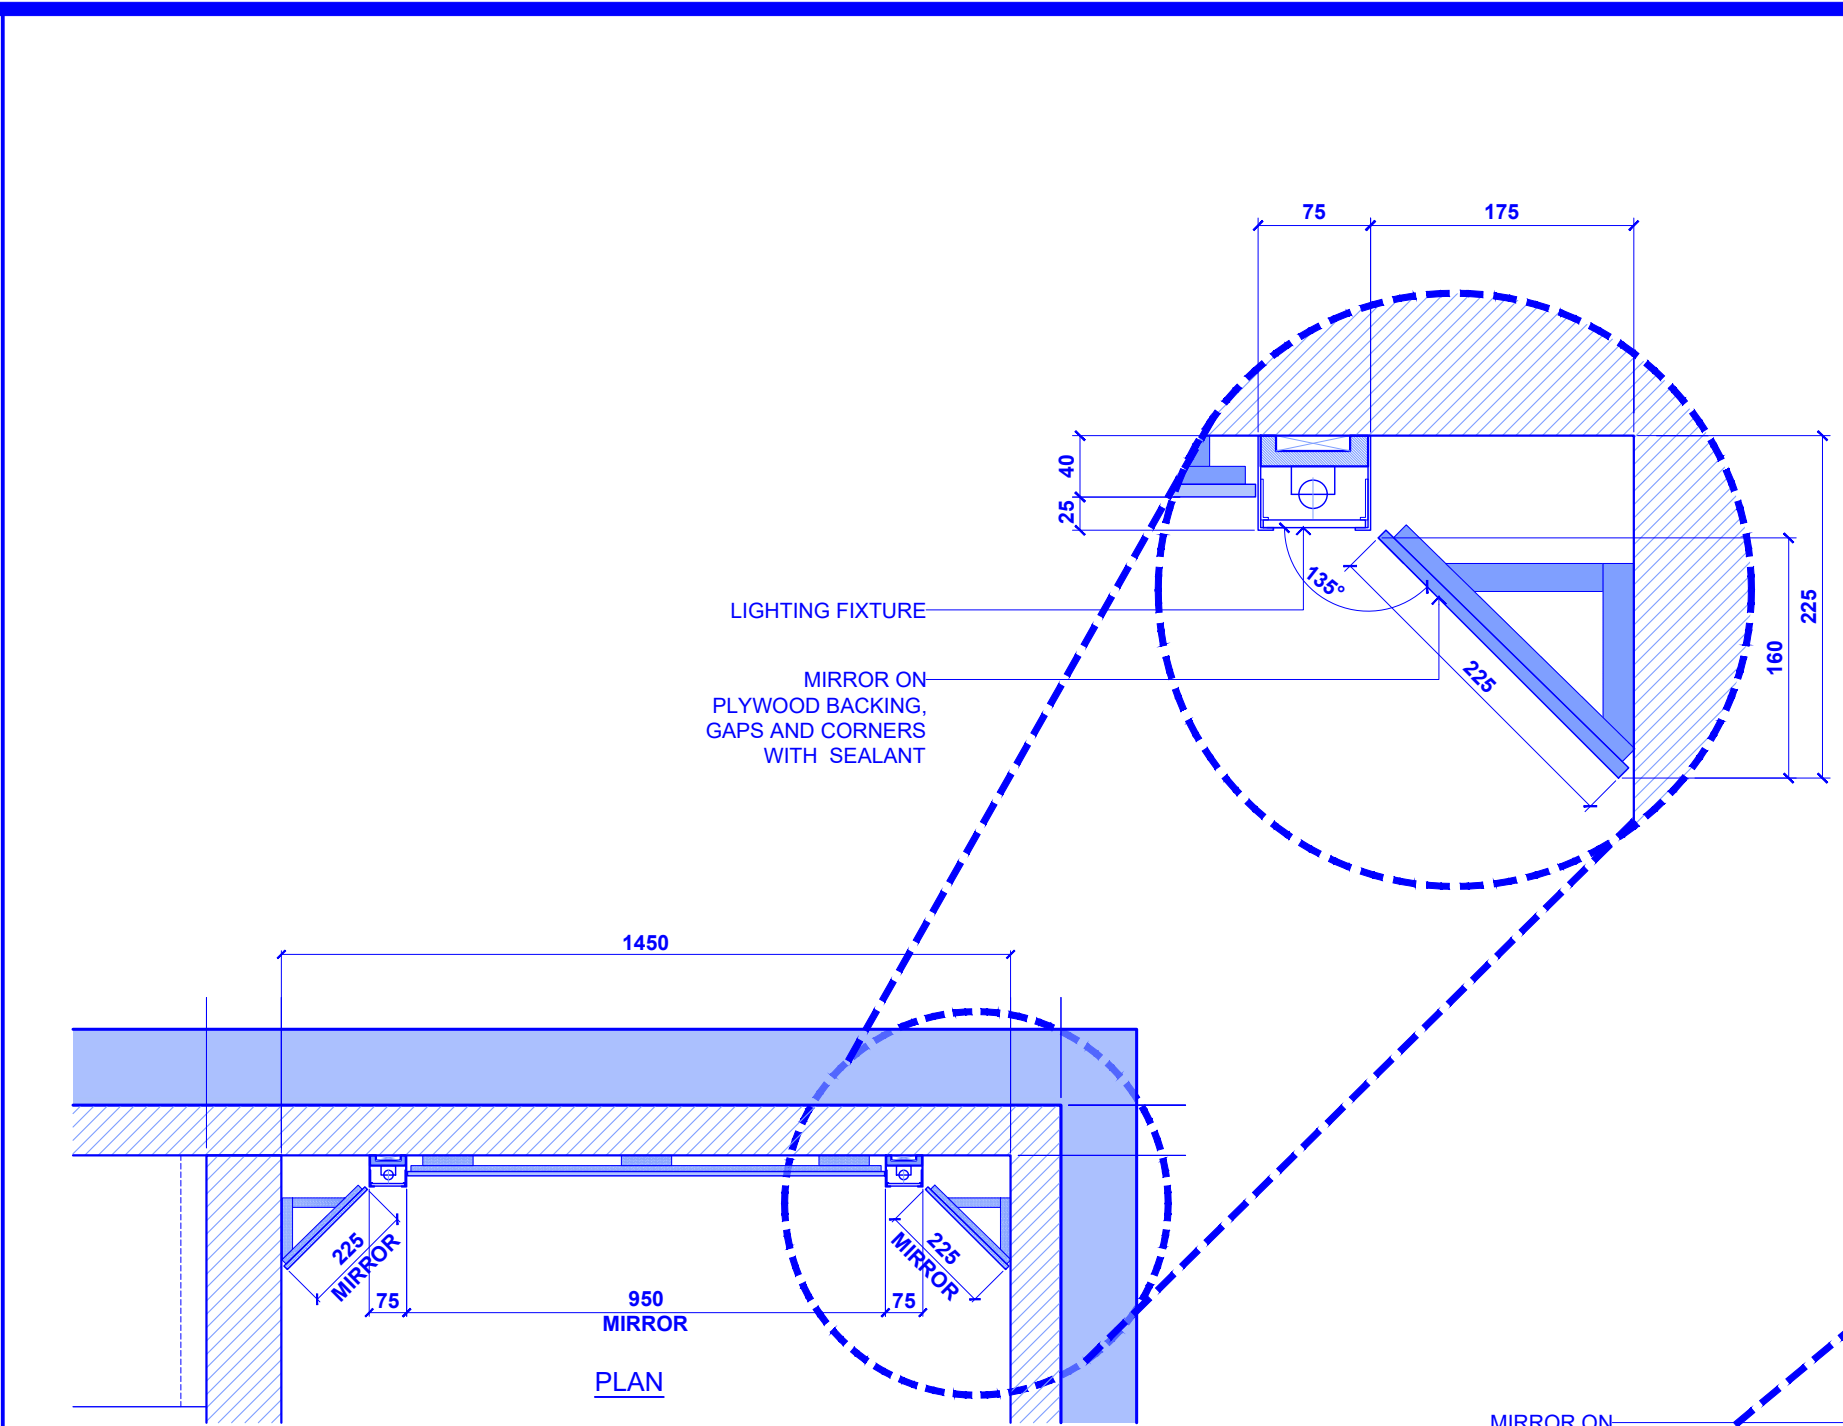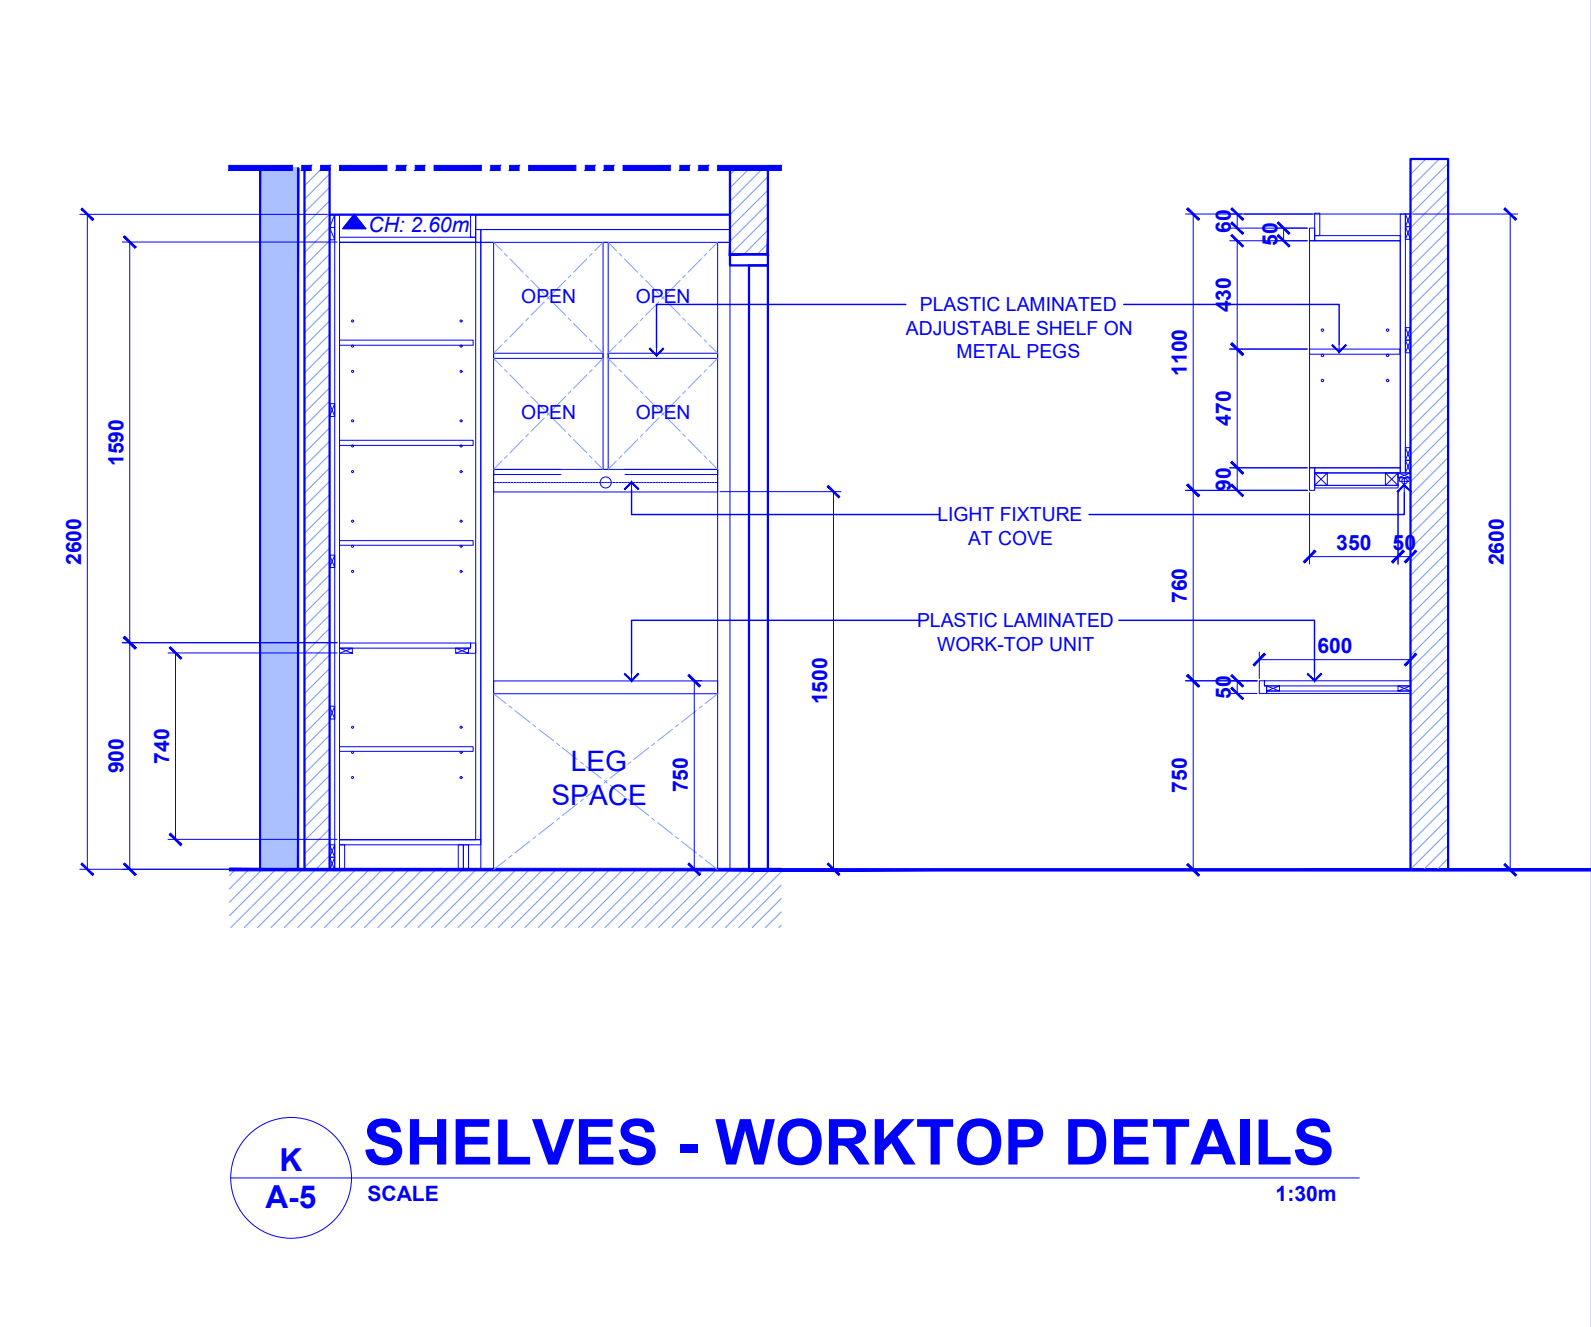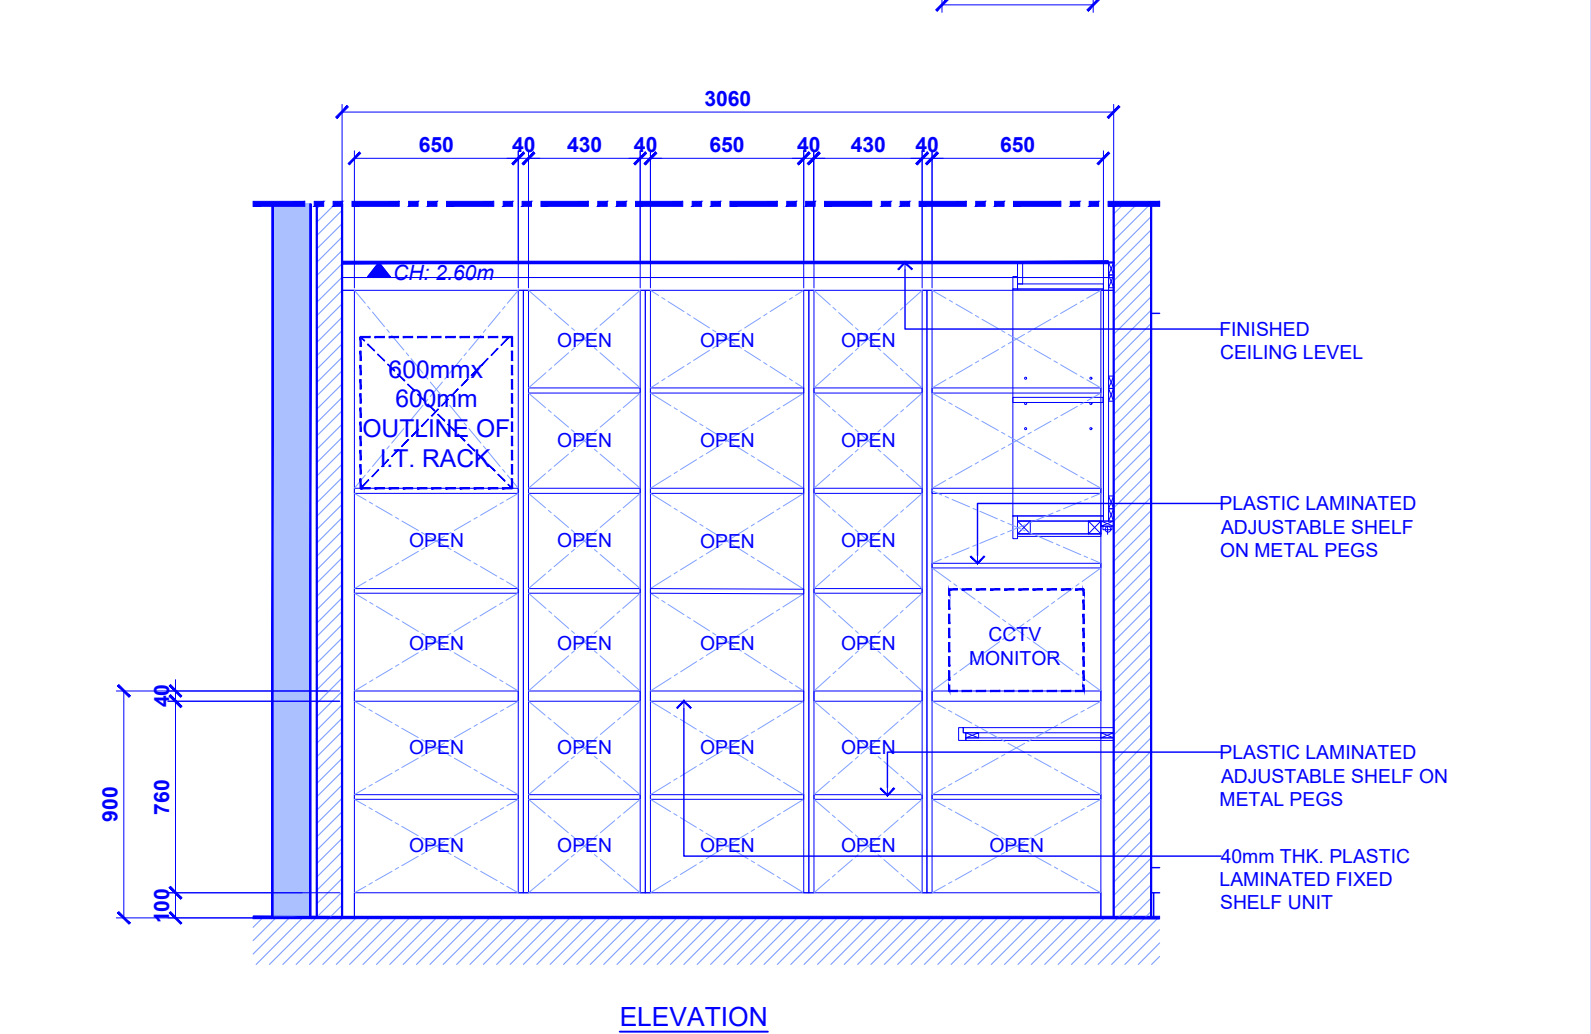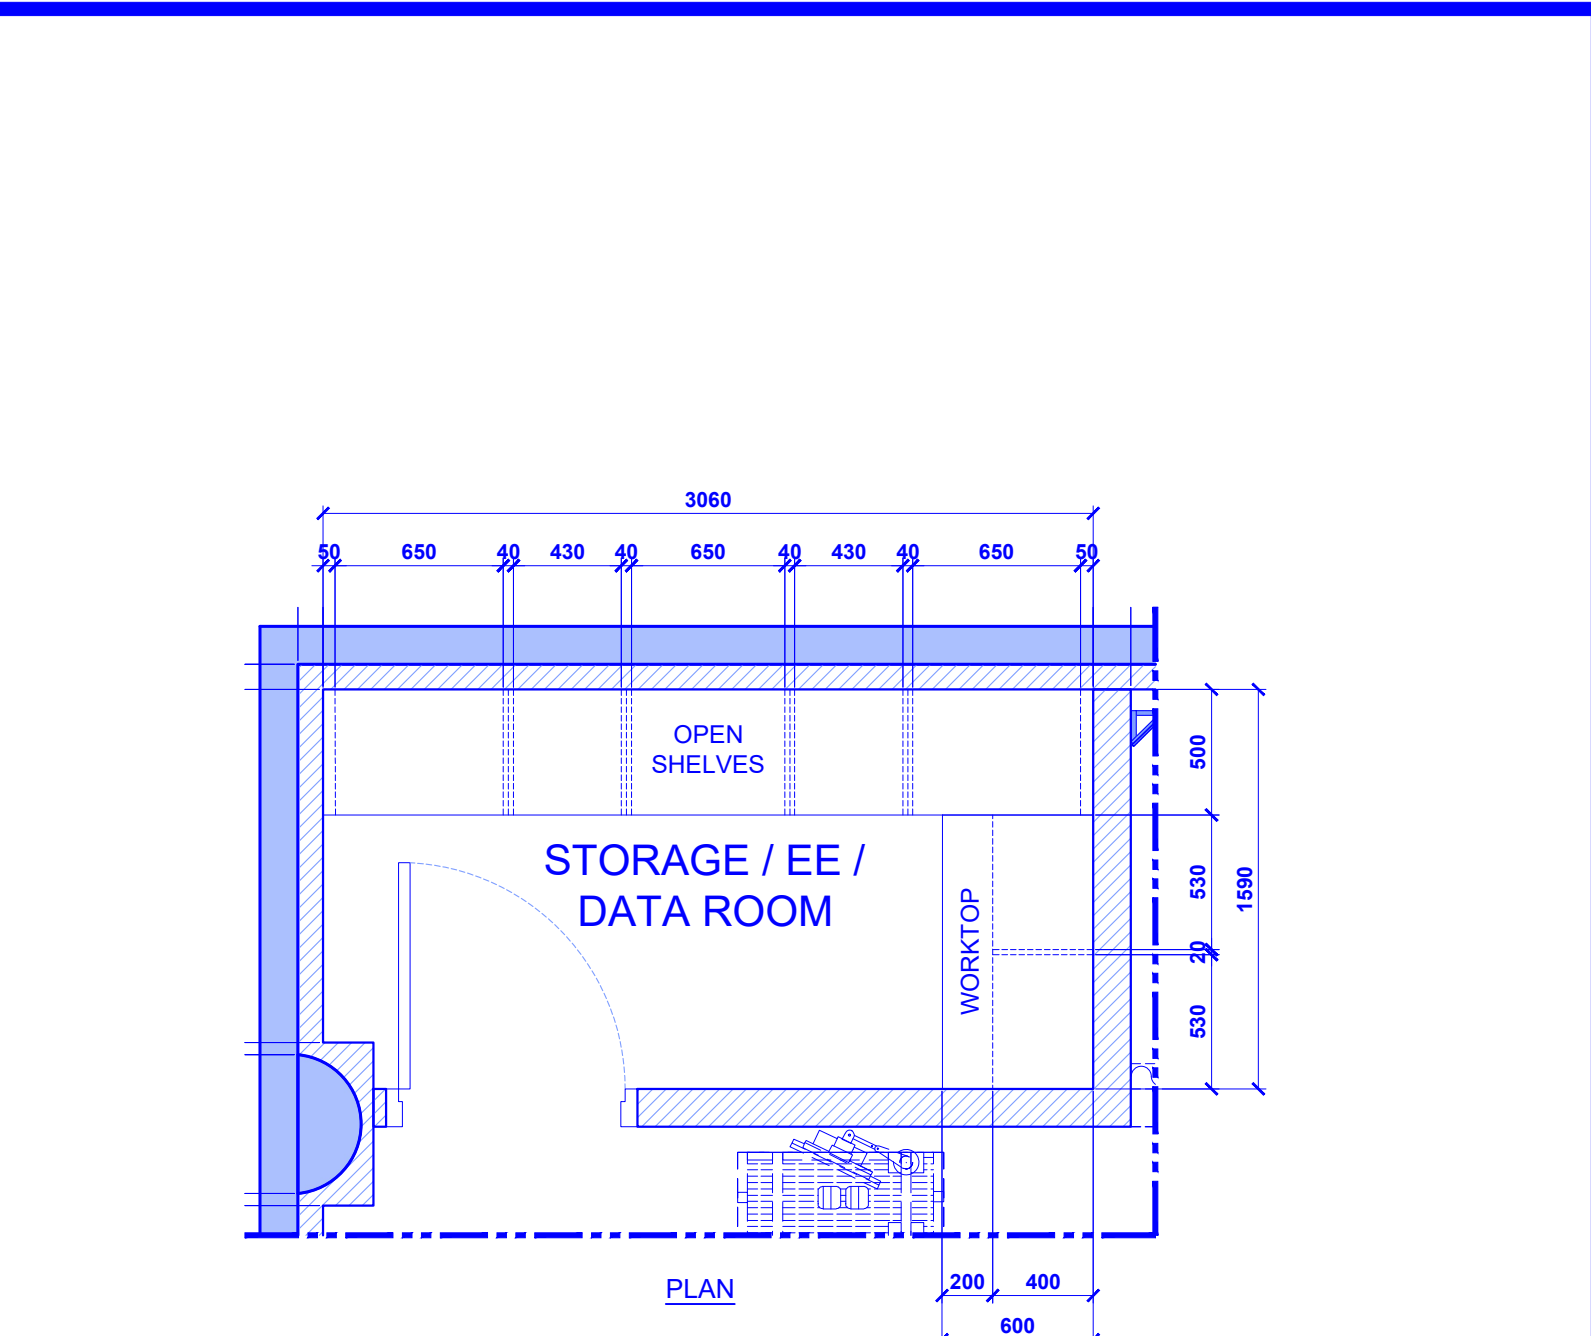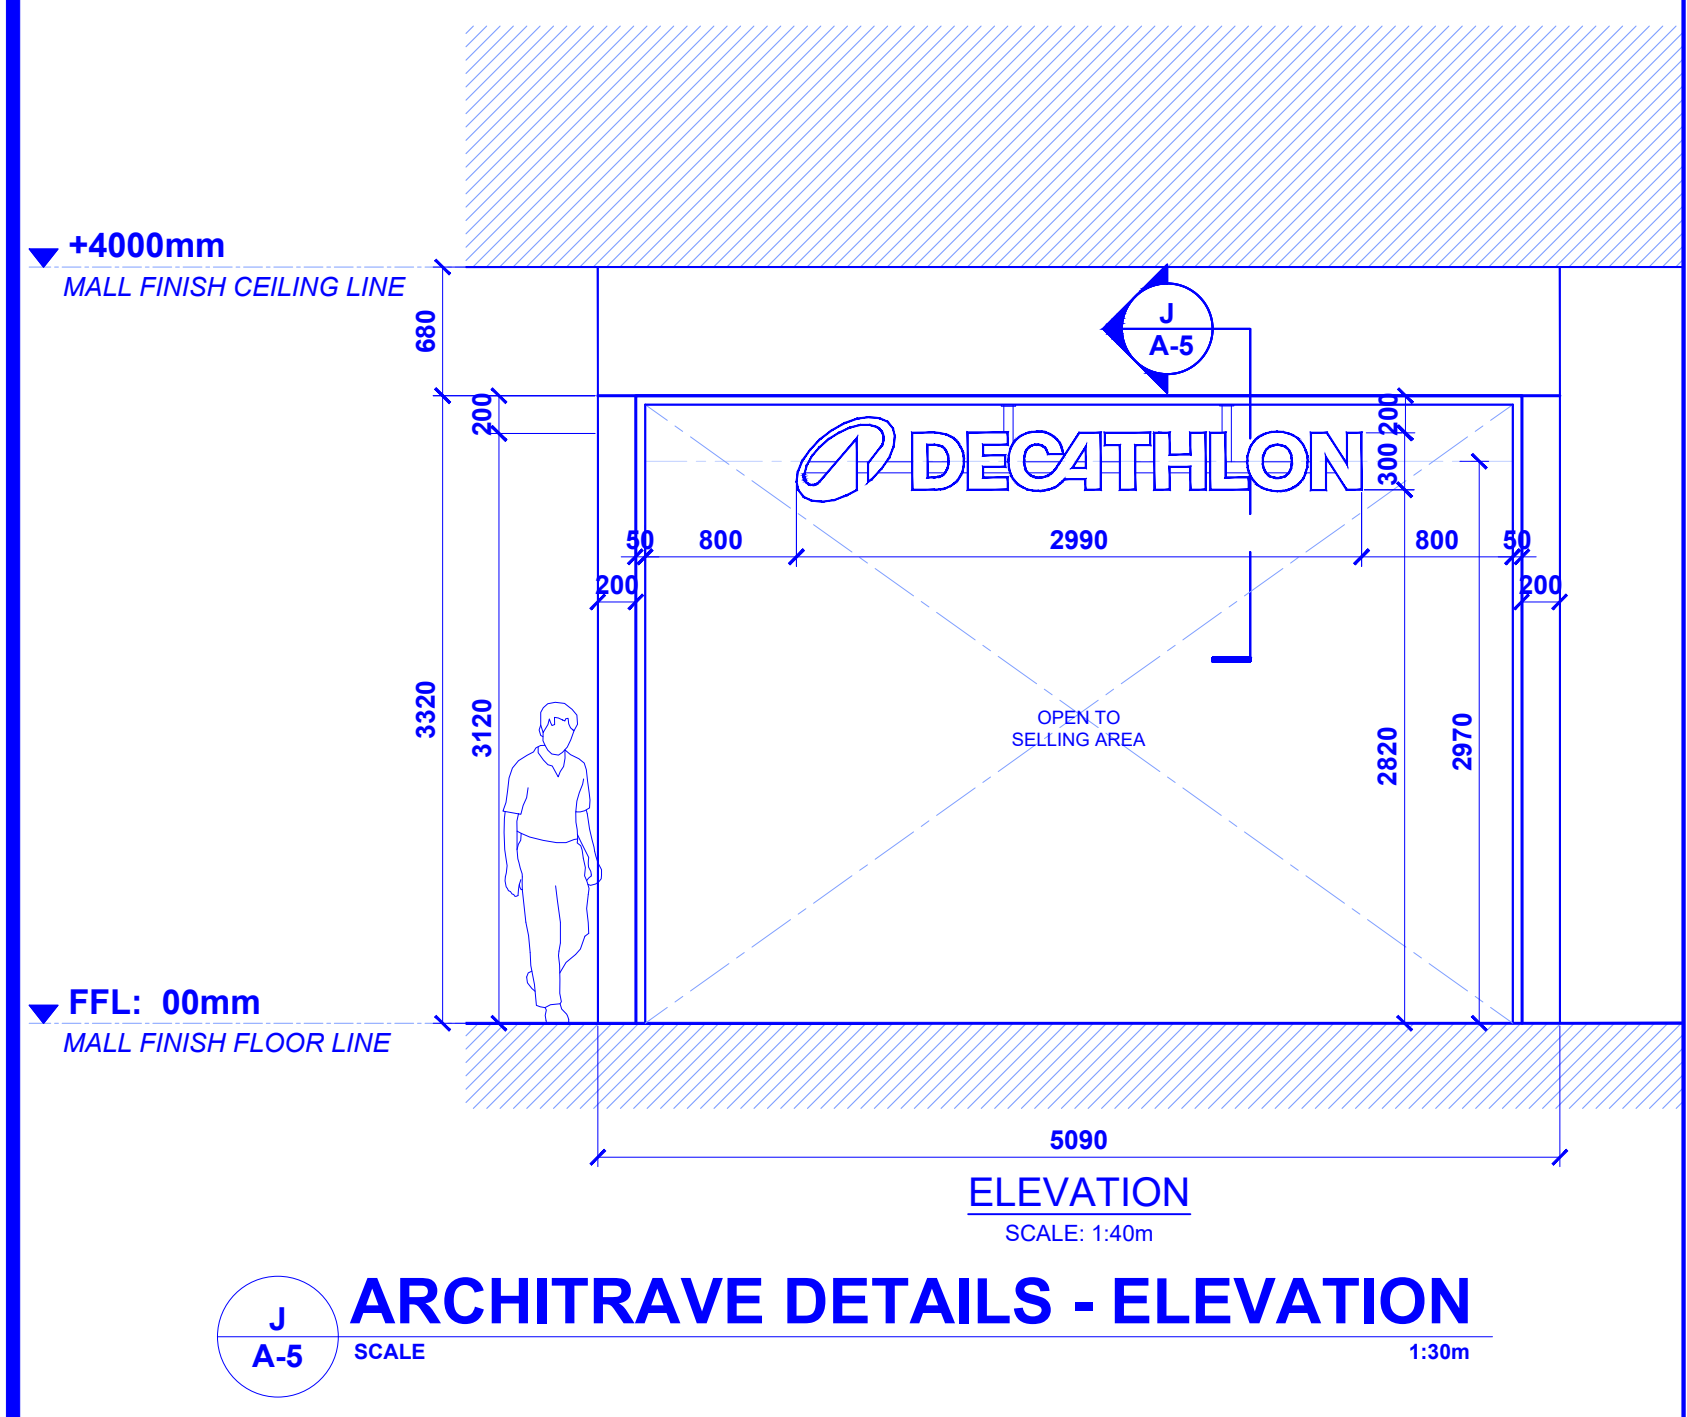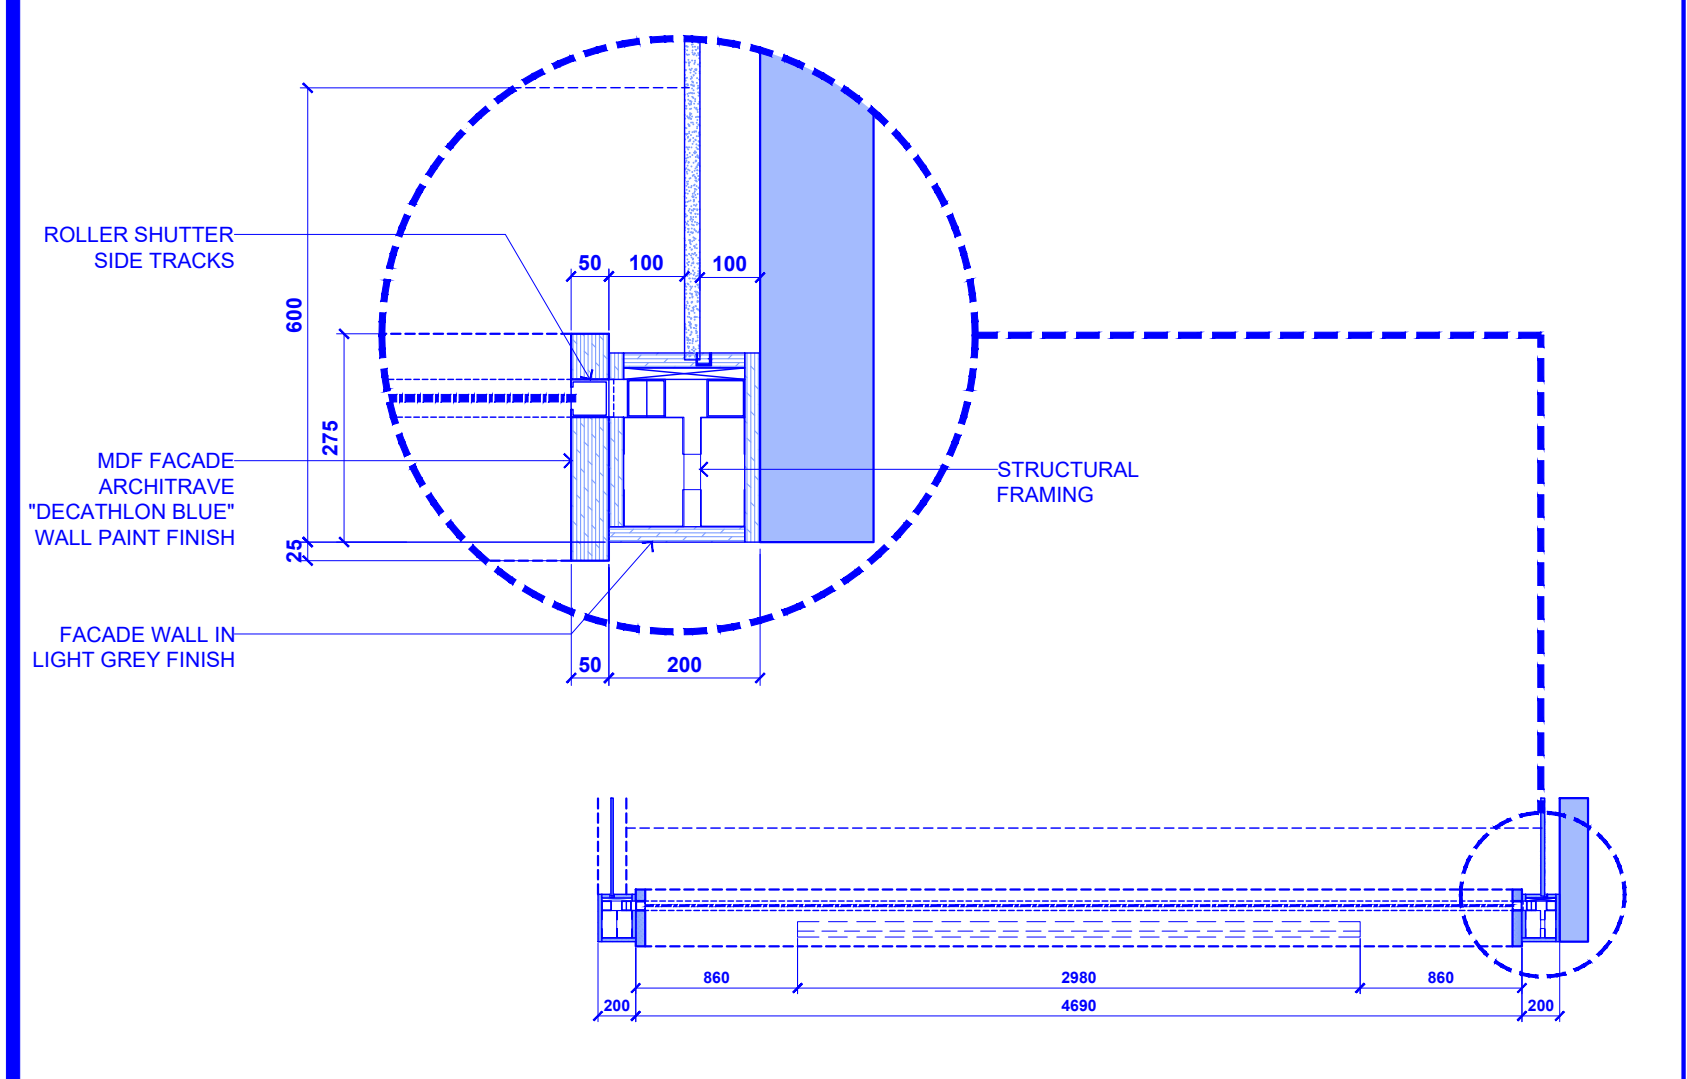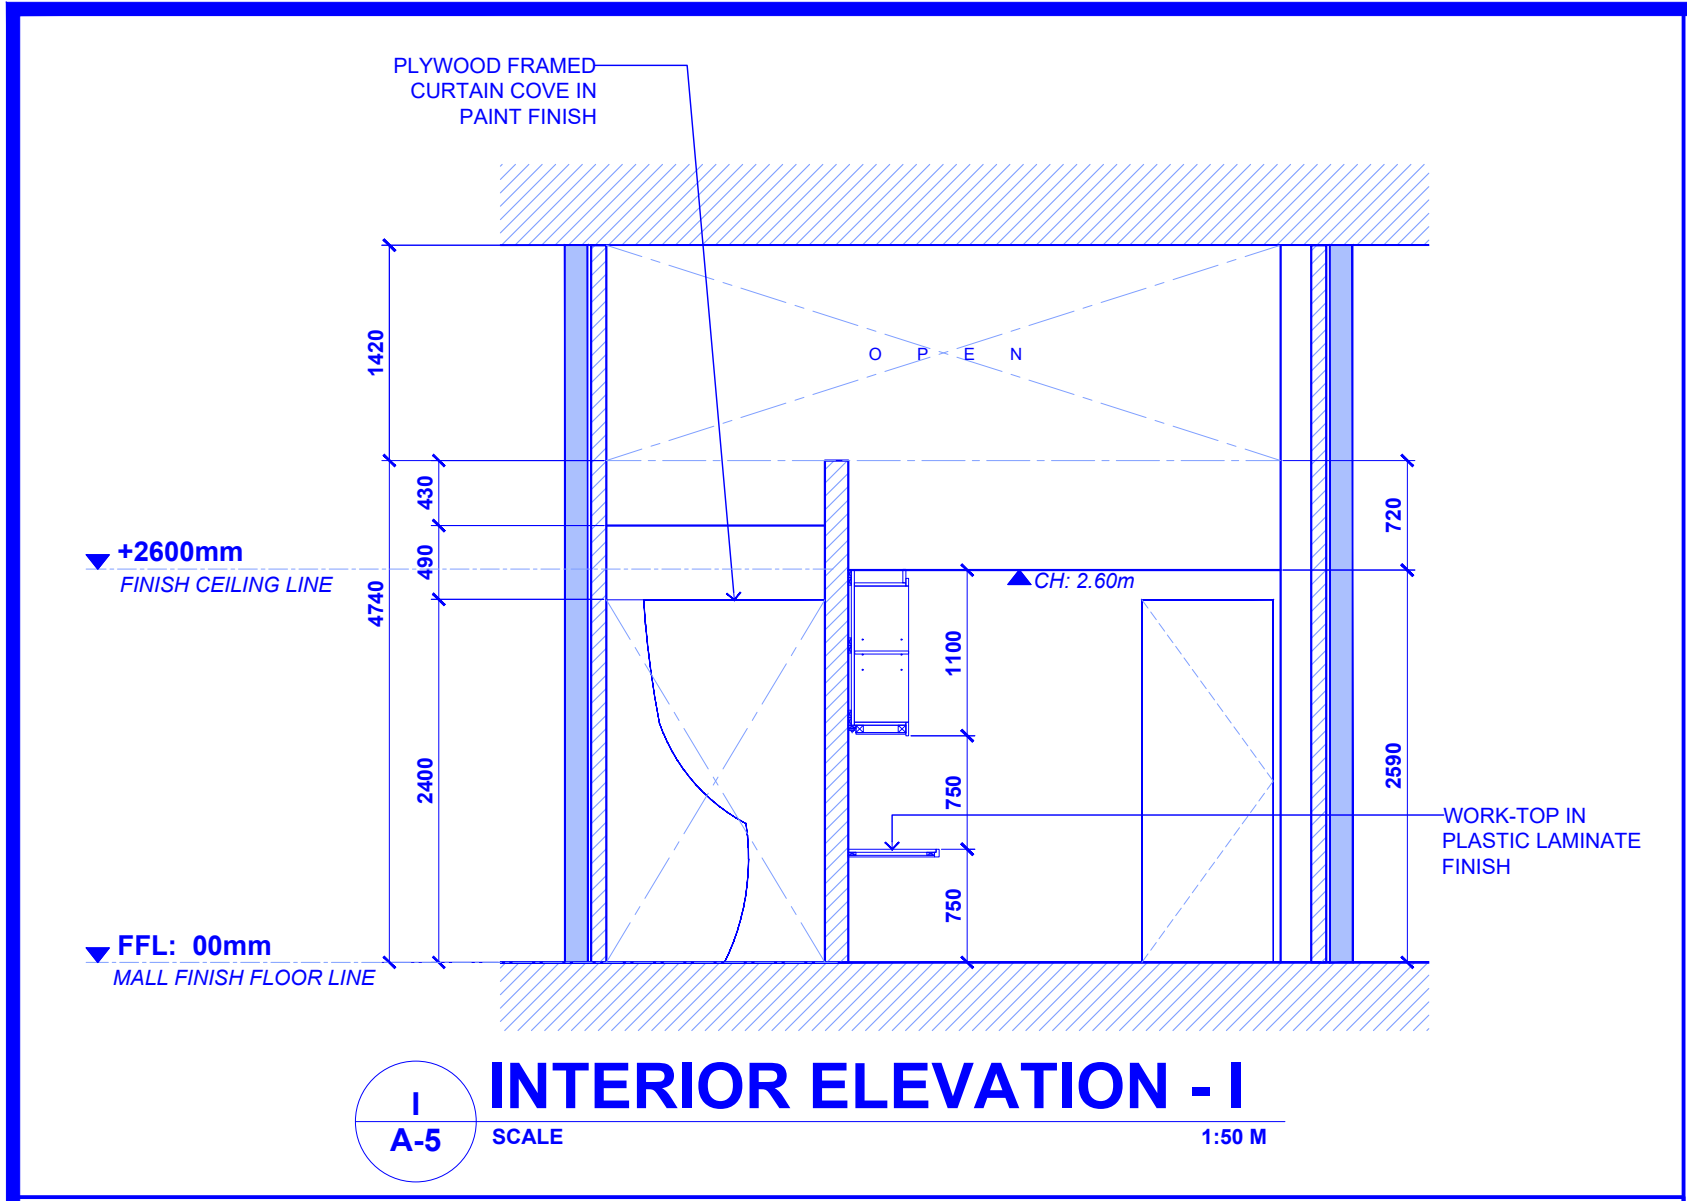

REPUBLIC OF THE PHILIPPINES
DEPARTMENT OF
PUBLIC WORKS & HIGHWAYS


OFFICE OF THE BUILDING OFFICIAL
CITY OF TAGUIG

ISSUANCE RECOMMENDED



SECTION HEAD: DATE

ISSUED BY: DATE


BUILDING OFFICIAL DATE

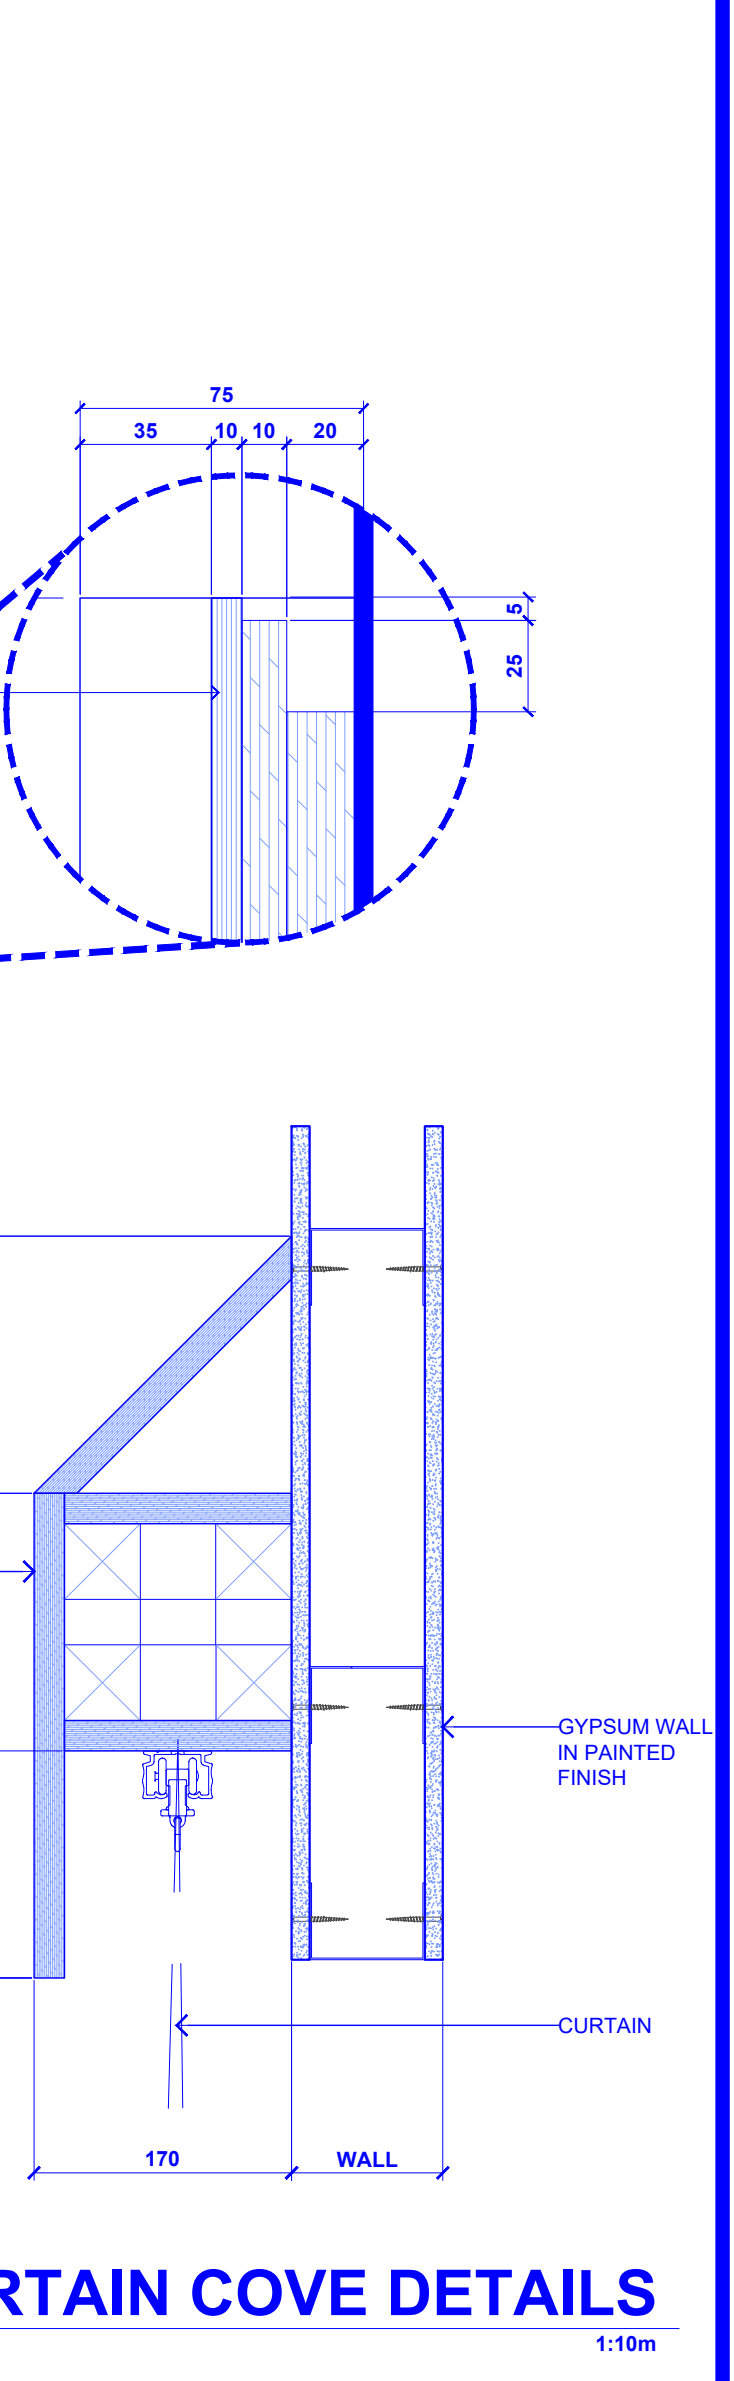


	R.A.9266 Section 33			SEAL	PROJECT TITLE AS-BUILT OF DECATHLON CONNECT (71.95 SQM. INTERIOR RENOVATION)	APPROVED BY DECATHLON PHILIPPINES INC. LAILA MONICA FLOR OWNER	SHEET CONTENT -INTERIOR ELEVATION - I -ARCHITRAVE DETAILS -SHELVES - WORKTOP DETAILS -FITTING ROOM MIRROR DETAILS -CURTAIN COVE DETAILS	DESIGNED BY:		THIS DRAWING IS ISSUED FOR :				SHEET NO.	
	DRAFTED BY: SBMM		☐ AS BUILT					☐ ESTIMATE							
	DATE ISSUED:		☐ BIDDING					☐ FABRICATION							
			☐ BUILDING PERMIT					☐ OWNER'S APPROVAL							
			☐ CONSTRUCTION					☐ PRESENTATION							
REVISONS		DATE		REVISONS		DATE		05 07							
①		④		④											
②		⑤		⑤											
③		⑥		⑥											

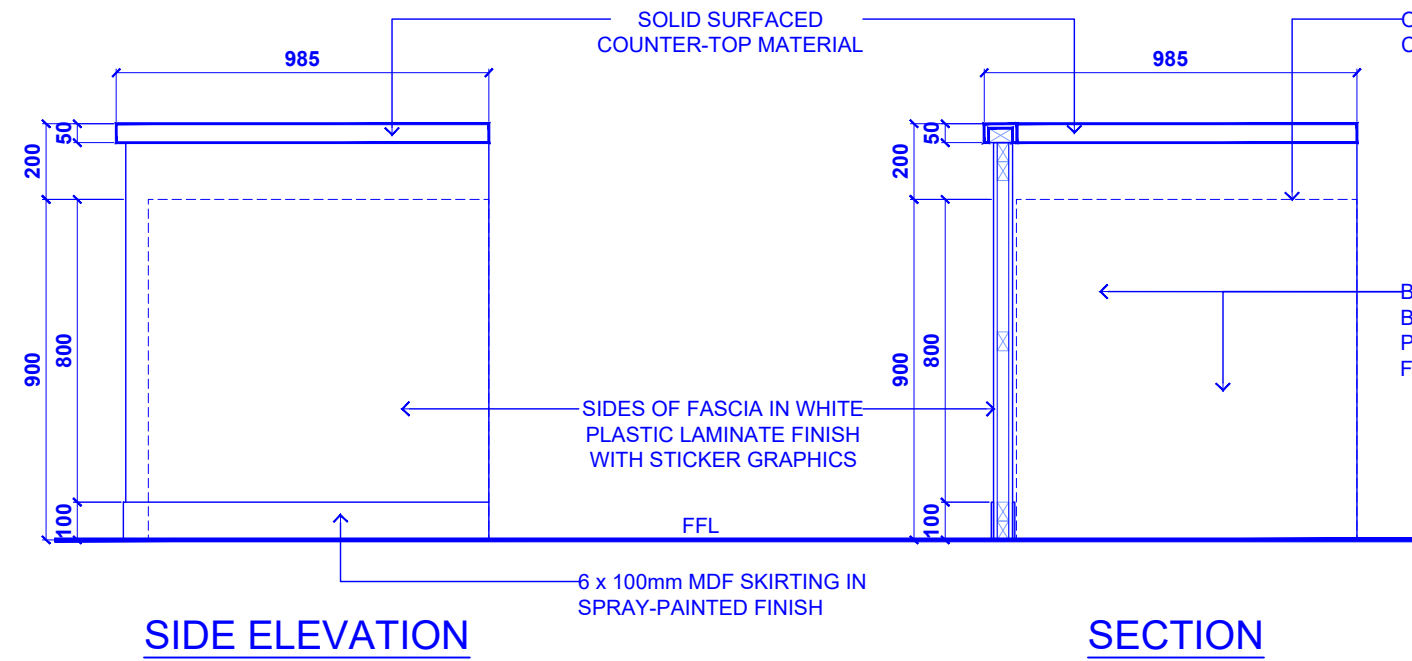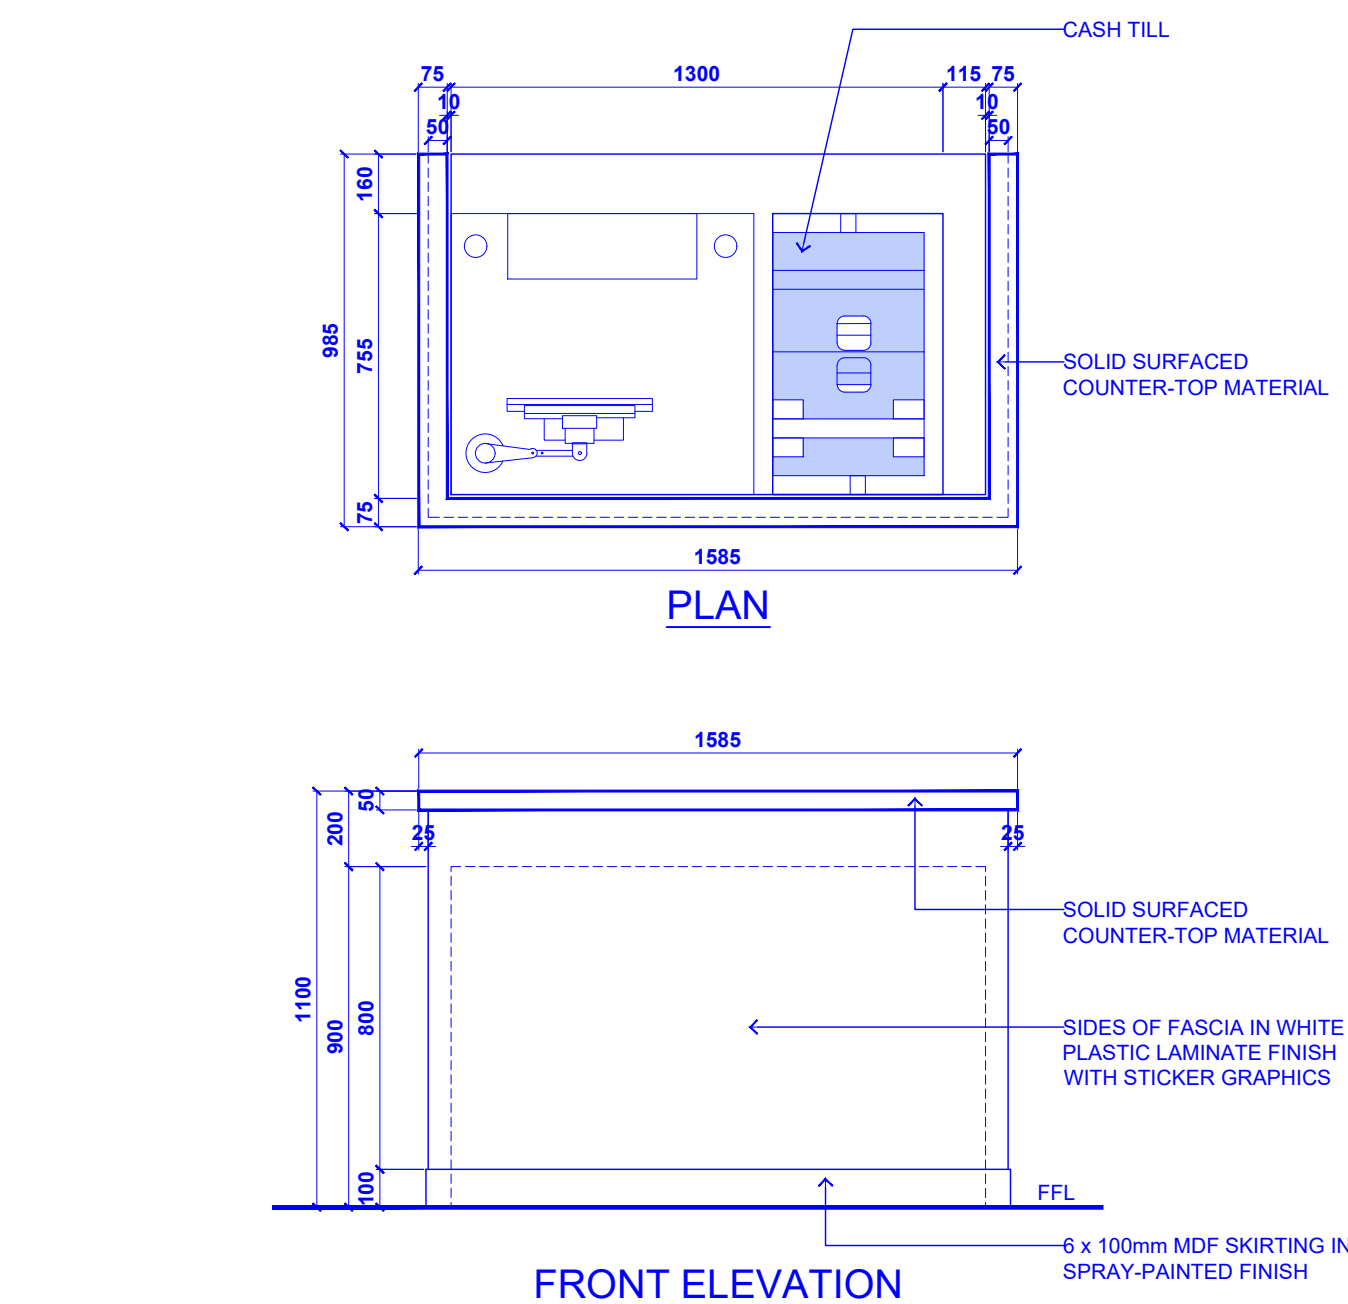


A
A-6 SCALE 1:20m
CASH TILL COUNTER DETAILS

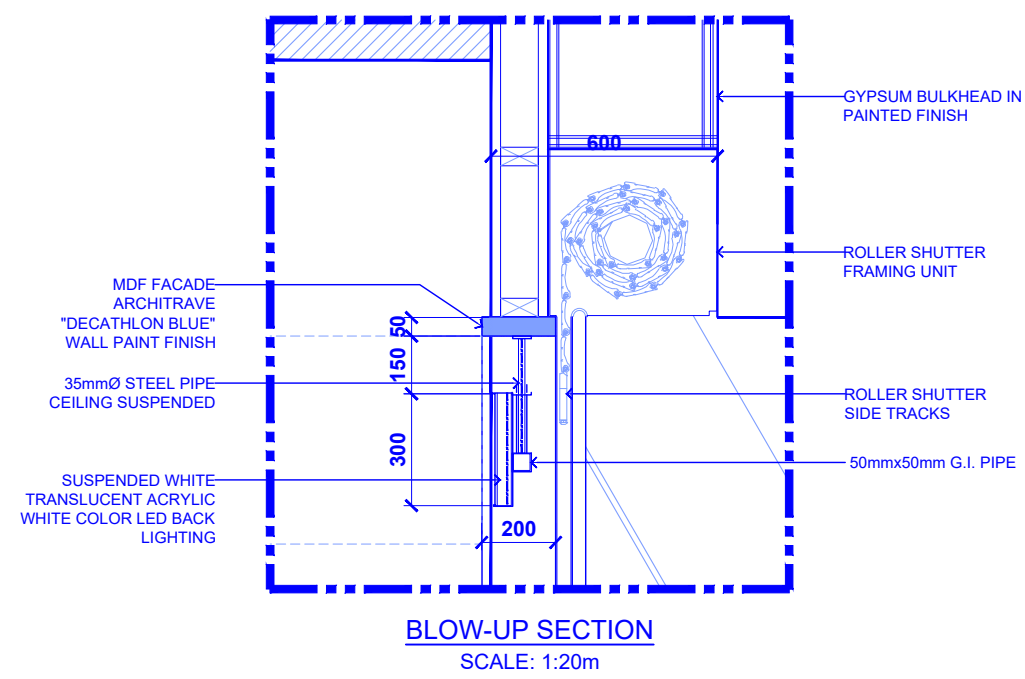

B
A-6 SCALE
SIGNAGE - 1 DETAILS

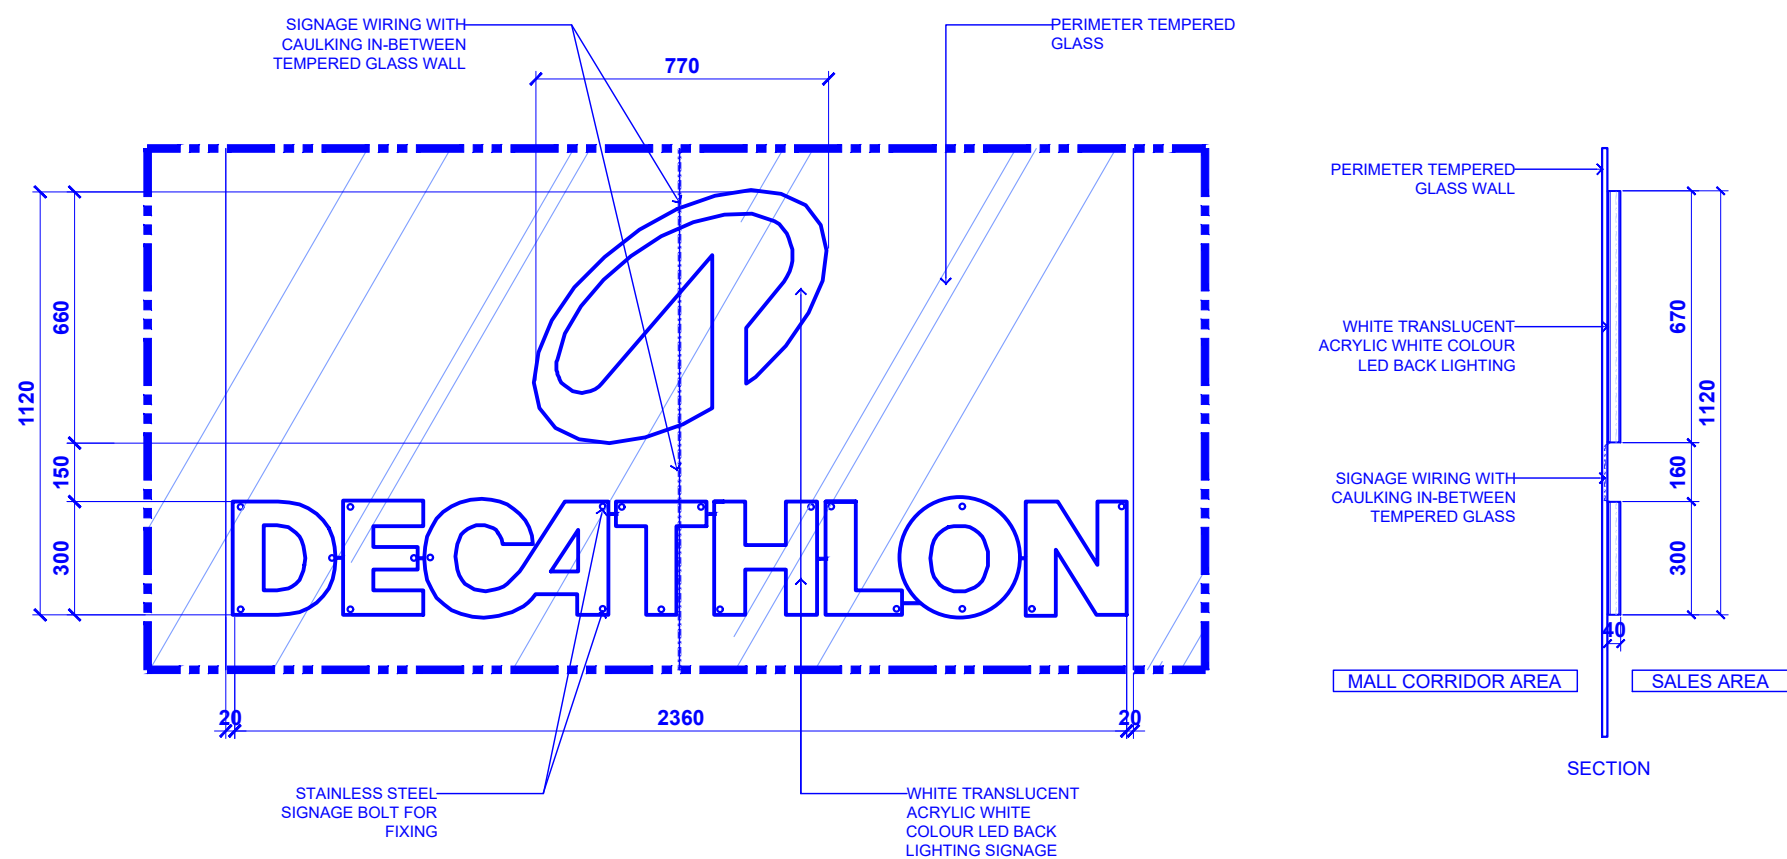

C
A-6 SCALE
SIGNAGE - 2 DETAILS

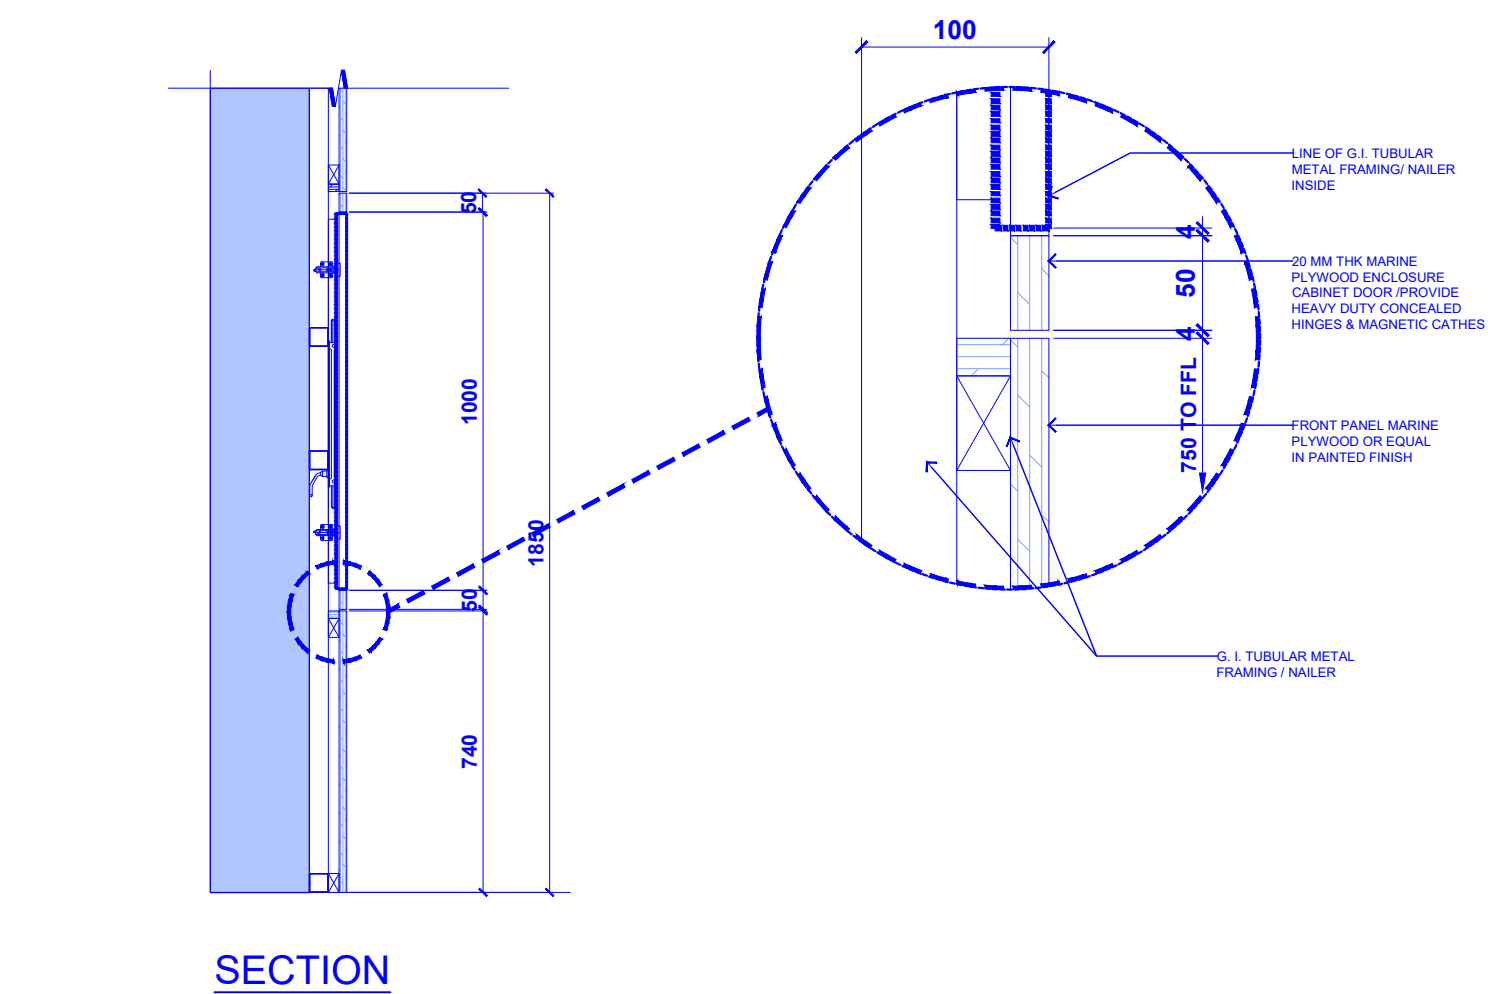

D
A-6 SCALE
CLICK & COLLECT KIOSK ENCLOSURE DETAILS

AS-BUILT PLAN



R.A.9266 Section 33
Drawing and specifications and other contract documents signed, stamped or sealed, as instruments of service, are the intellectual property and documents of the architect, whether the object for which they are made is executed or not, if shall be unlawful for any person to duplicate or to make copies of said documents for use in the repetition of and for other projects of building, whether executed partly in whole, without the written consent of architect or author of said documents.

ARCHITECT		
PRC. NO.:	ISSUED :	VALID :
PTR NO. :	ISSUED :	PLACE :
TIN :		


SEAL	PROJECT TITLE
	AS-BUILT OF DECATHLON CONNECT (71.95 SQM. INTERIOR RENOVATION)
	LOCATION: Unit L1 224-225 Market! Market! McKinley Parkway, Bonifacio Global City, Taguig, Metro Manila

APPROVED BY
DECATHLON PHILIPPINES INC. LAILA MONICA FLOR
OWNER
ADDRESS:

SHEET CONTENT
-CASH TILL COUNTER DETAILS -SIGNAGE DETAILS -CLICK & COLLECT ENCLOSURE DETAILS

DESIGNED BY:	THIS DRAWING IS ISSUED FOR :
DRAFTED BY: SBMI	☒ AS BUILT ☐ ESTIMATE
DATE ISSUED:	☐ BIDDING ☐ FABRICATION
	☐ BUILDING PERMIT ☐ OWNER'S APPROVAL
	☐ CONSTRUCTION ☐ PRESENTATION
REVISIONS	DATE
①	①
②	②
③	③


SHEET NO.
A-6
06 07

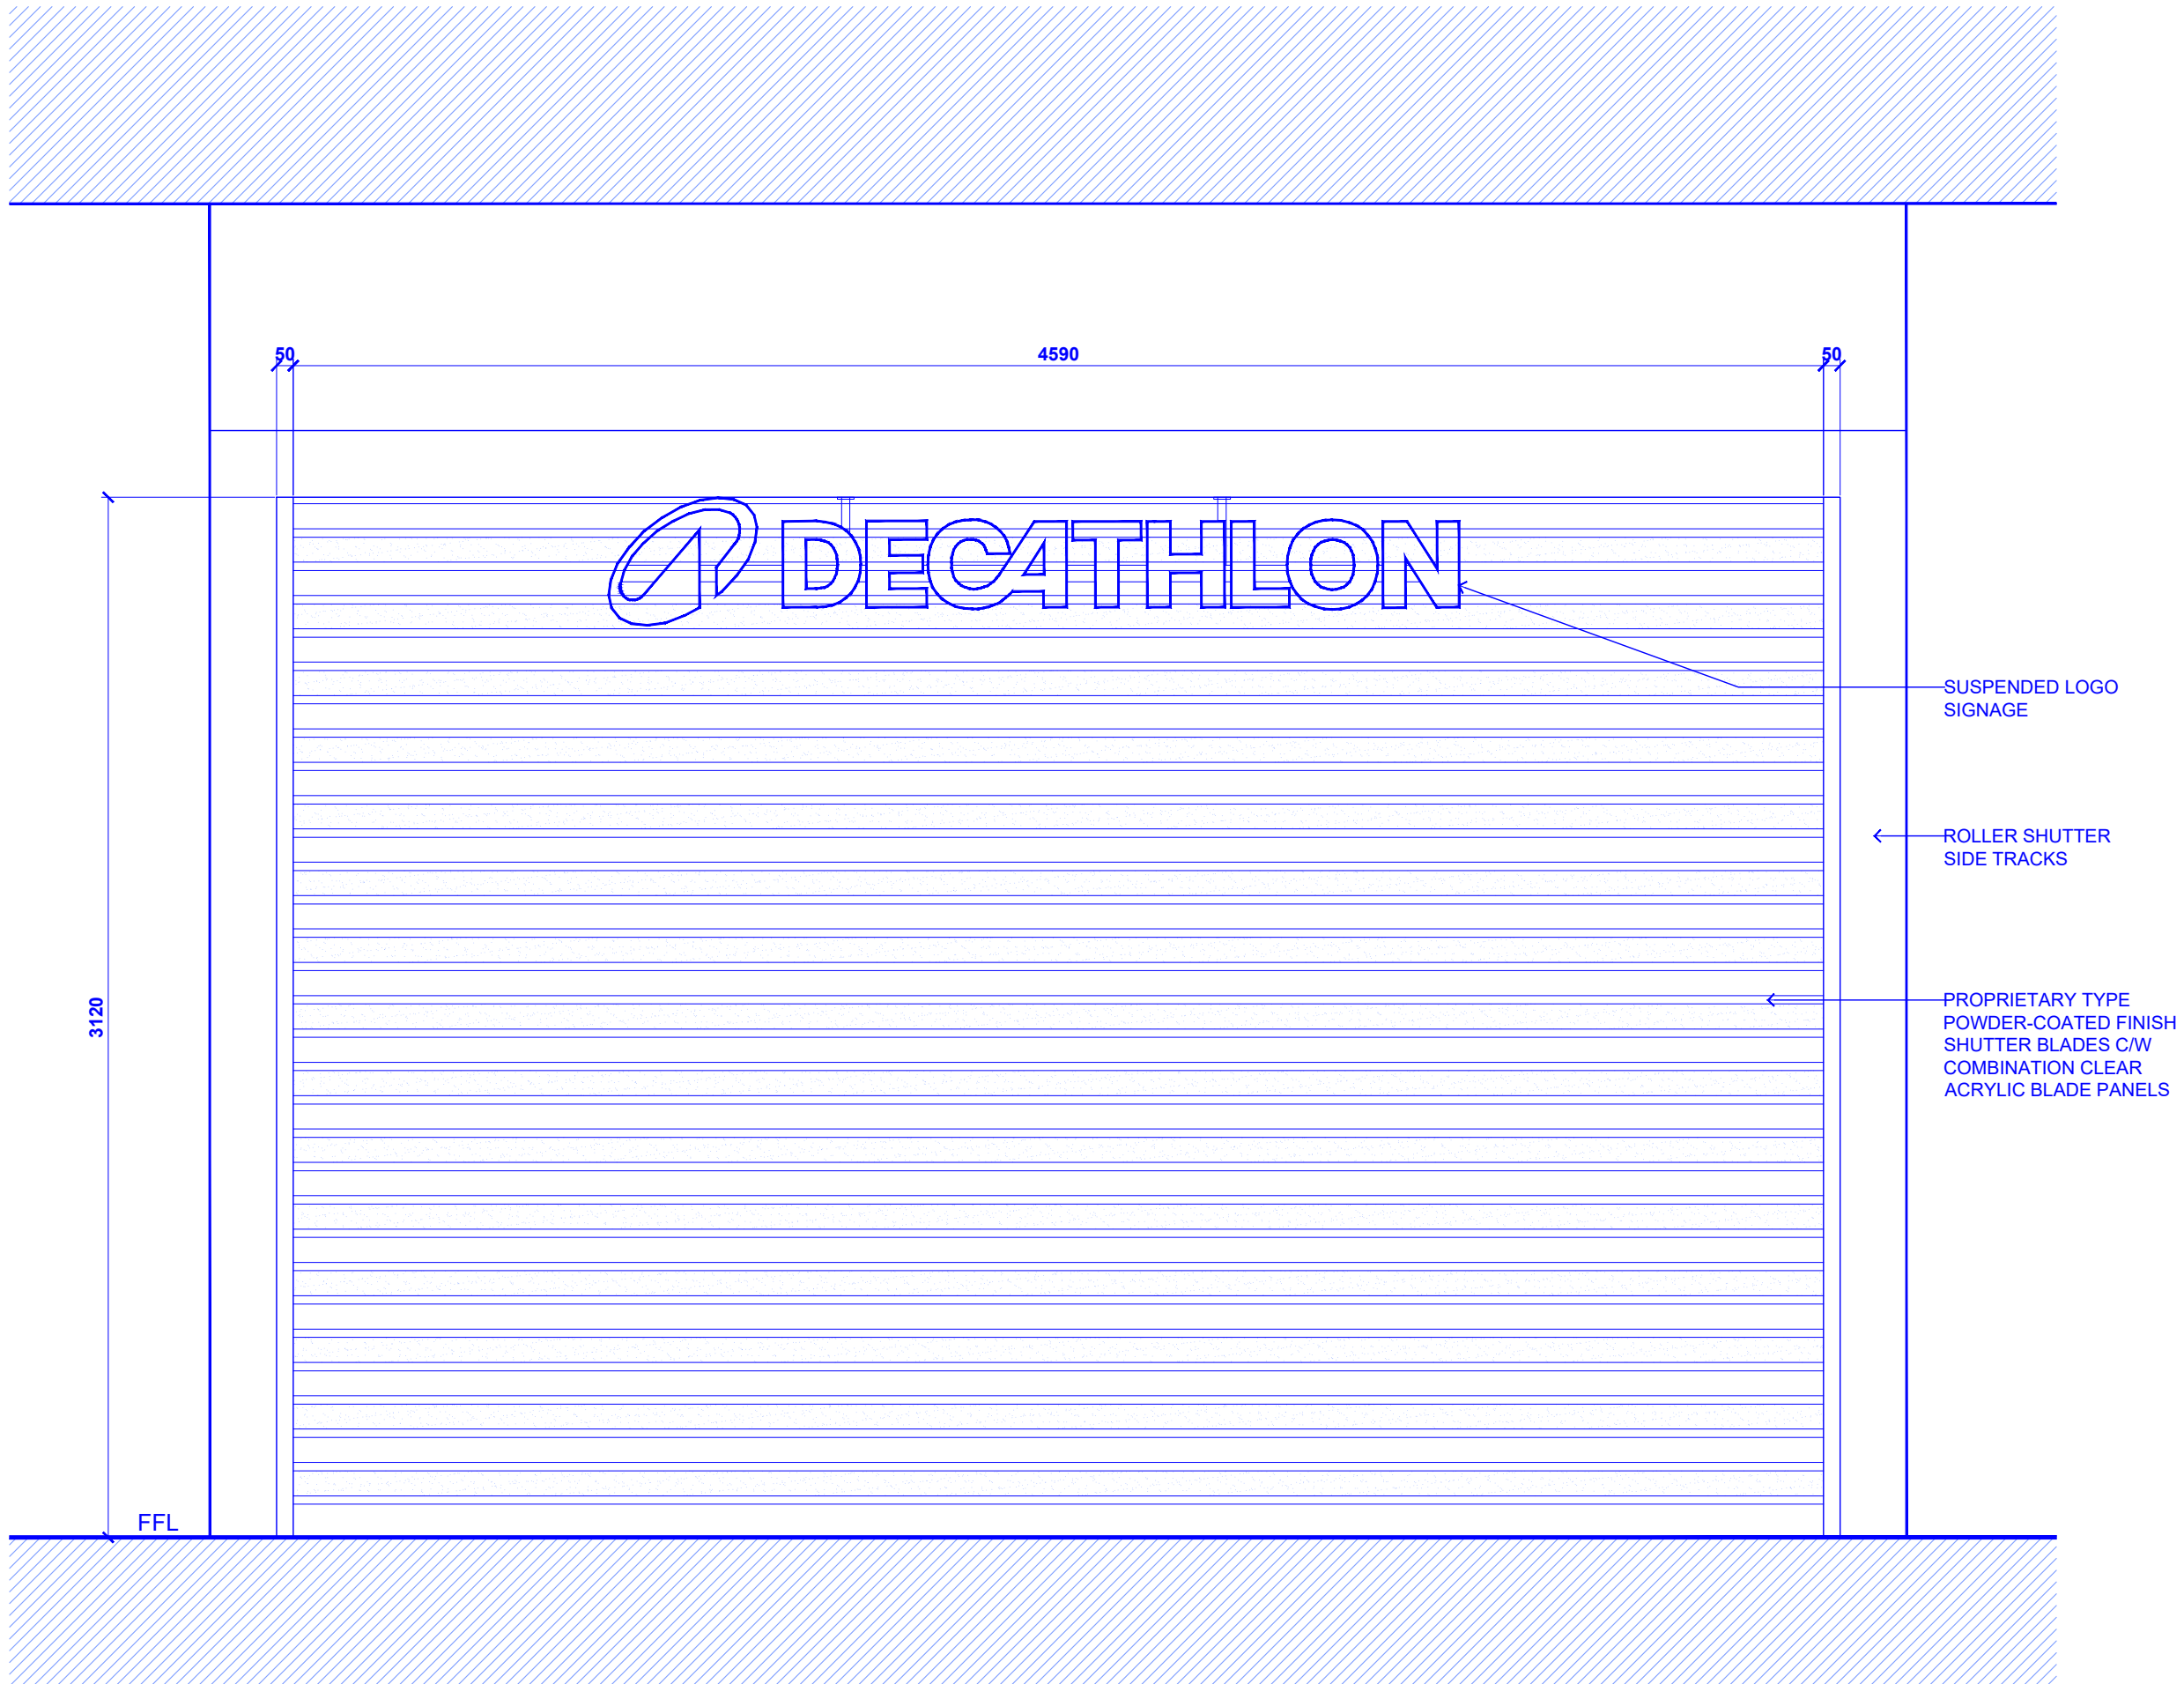

DESCRIPTION: POWDER-COATED SHUTTER BLADES
C/W COMBINATION CLEAR ACRYLIC VIEW WITH
PANEL SHUTTER BLADES

HARDWARES: PROPRIETARY TYPE MECHANISM +
ELECTRIC MOTOR UNIT


A
A-7 SCALE 1:20m **ENTRANCE SHUTTER**

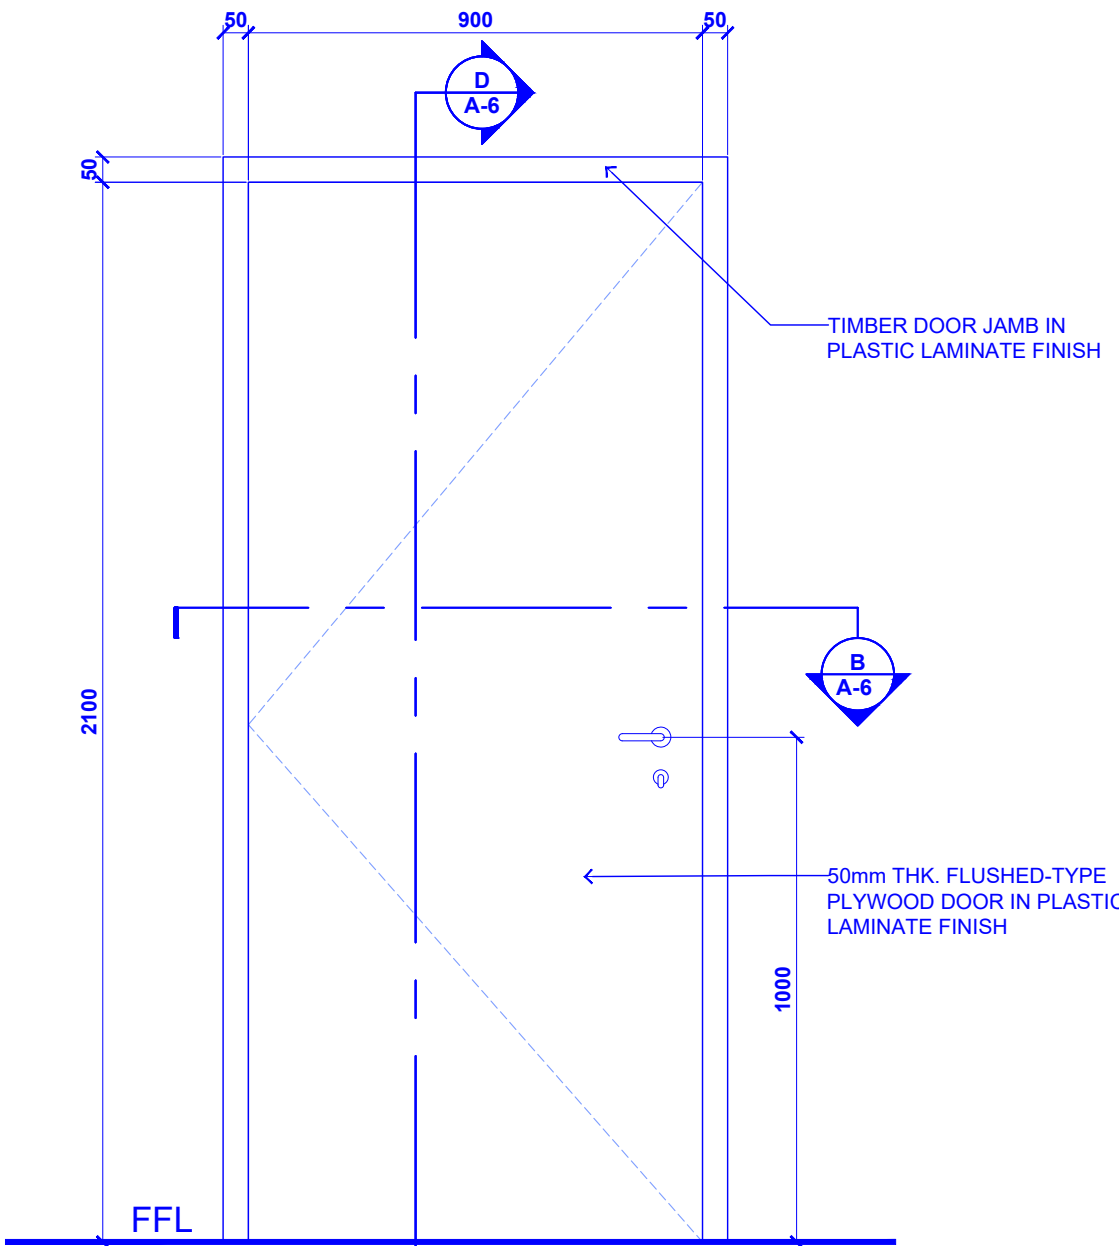


DESCRIPTION: FLUSHED-TYPE TIMBER DOOR IN PLASTIC LAMINATE
FINISH C/W HEAVY-DUTY TYPE HARDWARES AND ACCESSORIES

HARDWARES: DOOR LOCKSET / LEVER-TYPE HANDLE / HEAVY /
HEAVY-DUTY PROPRIETARY HINGES / CYLINDRICAL DOOR
STOPPER / HEAVY-DUTY TYPE PROPRIETARY SURFACE-MOUNTED
DOOR CLOSER

C
A-7 SCALE 1:15M **STORAGE / EE / DATA ROOM DOOR - ELEVATION**

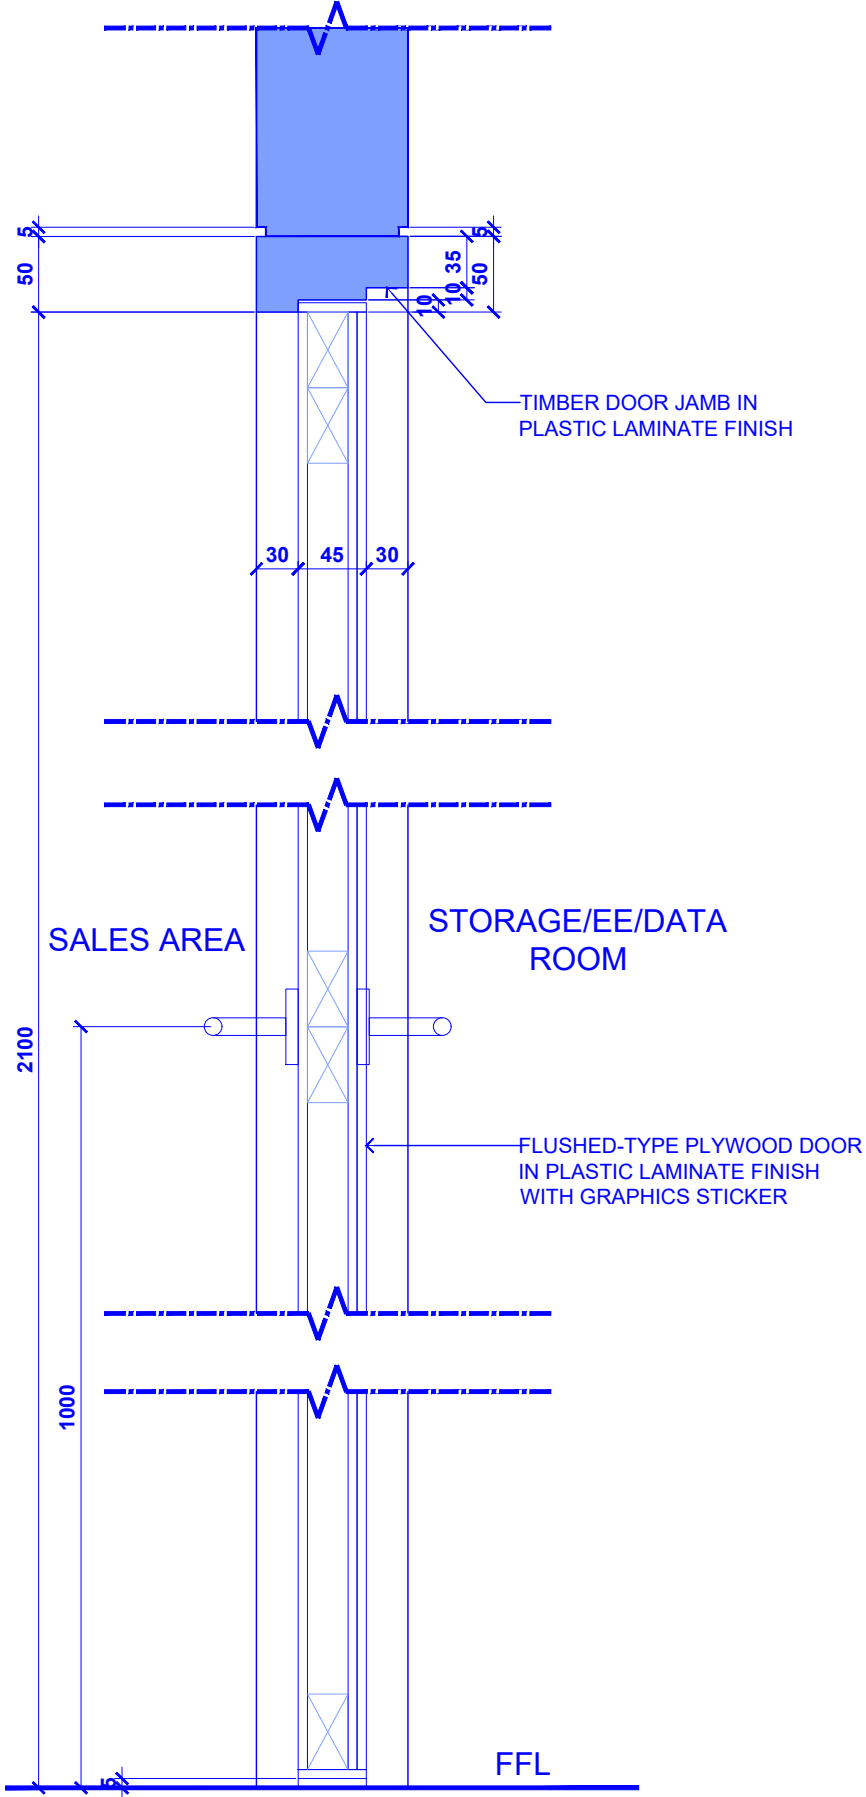

D
A-7 SCALE 1:5M **STORAGE / EE / DATA ROOM DOOR - SECTION**

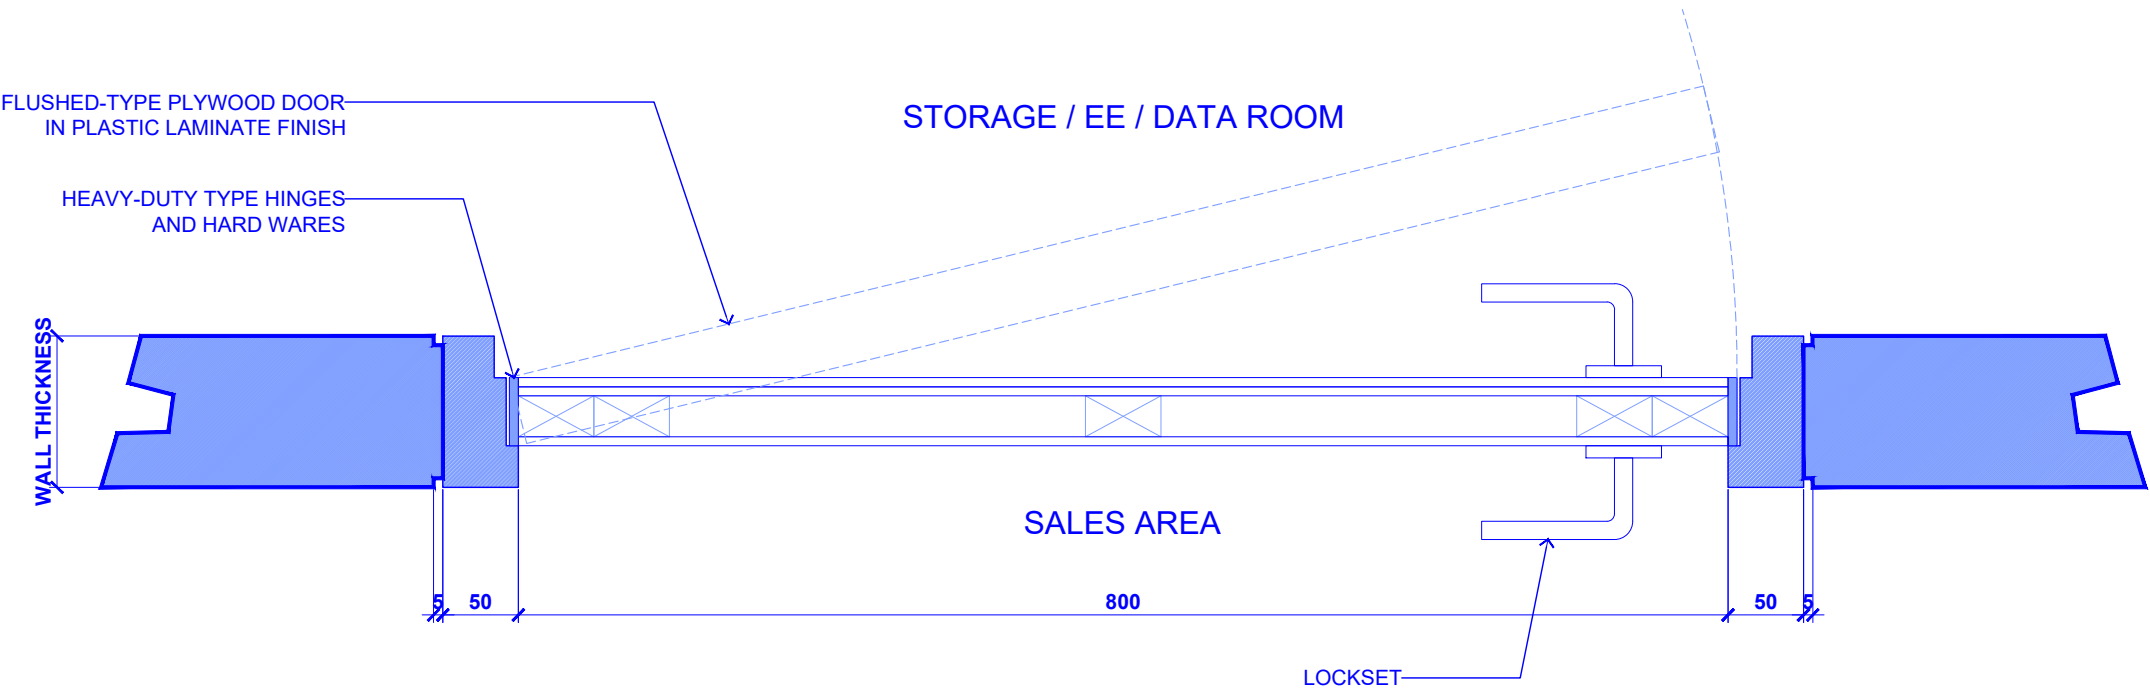


B
A-7 SCALE 1:5M **STORAGE / EE / DATA ROOM DOOR - BLOW-UP PLAN**


AS-BUILT PLAN

GENERAL NOTES:


- ALL ELECTRONICS WORKS SHALL BE DONE IN ACCORDANCE WITH THE LATEST PHILIPPINES NATIONAL BUILDING CODE AND REGULATIONS, THE FIRE CODE OF THE PHILIPPINES & REGULATIONS, THE PHILIPPINE ELECTRONICS CODES, LOCAL ENFORCING AUTHORITIES, AND THE RULES AND REGULATIONS OF THE LOCAL SERVICE PROVIDER.
- ALL ELECTRONICS WORKS SHALL BE COORDINATED WITH THE OTHER ENGINEERING TRADES.
- ALL INSTALLATIONS SHALL BE EXECUTED BY THE QUALIFIED ELECTRONICS PERSONNEL UNDER THE DIRECT SUPERVISION OF THE REGISTERED ELECTRONICS ENGINEER.
- ALL ELECTRONICS EQUIPMENTS & INSTRUMENTS SHALL BE CONFORMED TO "UL" STANDARD.
- ALL WIRING SHALL BE IN CONCEALED CONDUIT/ TRUNKING UNLESS OTHERWISE SPECIFIED.
- EXPOSED CIRCUIT RUN SHALL BE INSTALLED PARALLEL TO OR PERPENDICULAR WITH THE BUILDING LINE AND SUPPORTED BY CONDUIT CLAMPS EVERY 1.5 METERS, DIAGONAL CONDUIT RUN SHALL NOT BE ACCEPTED.
- ALL CIRCUITS SHALL BE PROVIDED WITH SEPARATE GREEN INSULATED GROUNDING WIRE.
- UNLESS OTHERWISE SPECIFIED, ALL WIRING INSTALLATIONS CONCEALED IN CEILING, WALL OR FLOOR SHALL USED IMC. ALL EXPOSED, SURFACED OR SUBJECT TO PHYSICAL DAMAGE AND SERVICE ENTRANCE SHALL USED IMC.
- ALL CONDUITS SHALL BE SWABBED CLEAN BEFORE THE INSTALLATION OF WIRES.
- ALL MISCELLANEOUS SUPPORT MATERIALS, BOLTS, ETC. SHALL BE COATED WITH AN APPROVED CORROSION RESISTANT MATERIAL.
- ALL THREAD OF PLUGS, JUNCTION BOXES AND OTHER FITTINGS SHALL BE LIGHTLY LUBRICATED WITH RUST PREVENTIVE GREASE BEFORE ASSEMBLY (ALL UNUSED ENTRIES TO DEVICES SHALL BE PLUGGED).
- ALL PULL BOXES AND JUNCTION BOXES SHALL BE GALVANIZED, AT LEAST 54MM DEEP, GAUGE 16, AND WITH ADEQUATE COVER TO PROTECT FROM PHYSICAL DAMAGE.
- THERE SHALL BE NO OPEN WIRING, NO EXPOSED AND DANGLED WIRES.
- USE APPROVED TYPE HANGERS & SUPPORTS WHICH ARE DIRECTLY CONNECTED TO THE CEILING SLAB. HANGERS AND SUPPORTS ARE NOT ALLOWED TO CONNECT AT THE BEAM. GI WIRE AS SUPPORT IS STRICTLY NOT ALLOWED.
- MOUNTING HEIGHTS OF ELECTRONICS DEVICES SHALL BE THE FOLLOWING: (SUBJECT TO OWNER AND INTERIOR DESIGNER OR ARCHITECT'S APPROVAL) (A) TEL/ DATA/ POS OUTLET: 0.3M ABOVE FINISHED FLOOR TO CENTER OF THE DEVICE.
- ALL ELECTRONICS WORK HEREIN SHALL BE EXECUTED BY PERSONNEL WITH ELECTRONICS EXPERIENCE UNDER THE DIRECT SUPERVISION OF LICENSED ELECTRONICS ENGINEER. ALL WORKS SHALL BE NEATLY PLACED, SECURELY FASTENED AND PROPERLY FINISHED.
- THE CONTRACTOR SHALL VERIFY AND ORIENT THE ACTUAL LOCATION OF SERVICE ENTRANCE FOR CONNECTION TO COMMUNICATION SUPPLY.
- NETWORK CABLES/CONDUIT SHALL HAVE A MINIMUM DISTANCE OF 0.3M FROM POWER CONDUIT WHEN LAID PARALLEL & MUST RUN PERPENDICULAR TO THE STEEL CONDUIT WHEN CUTTING ACROSS A POWER LINE.
- THE PLANS AS DRAWN ARE BASED UPON THE ARCHITECTURAL aPLANS & THE DETAILS & SHOW CONDITION AS ACCURATELY AS IT IS POSSIBLE TO INDICATE THEM IN SCALE. THE PLANS ARE DIAGRAMMATICAL AND DOES NOT NECESSARILY SHOW ALL FITTINGS NECESSARY TO FIT TO THE BUILDING CONDITIONS. THE LOCATIONS OF OUTLETS, APPARATUS AND APPLIANCES SHOWN ON THE PLANS ARE APPROXIMATE. THE CONTRACTOR SHALL BE HELD RESPONSIBLE FOR THEIR PROPER LOCATION IN ORDER TO MAKE THEM FIT WITH THE ARCHITECTURAL DETAILS AND INSTRUCTIONS FROM THE ENGINEER'S REPRESENTATIVE AT THE SITE.

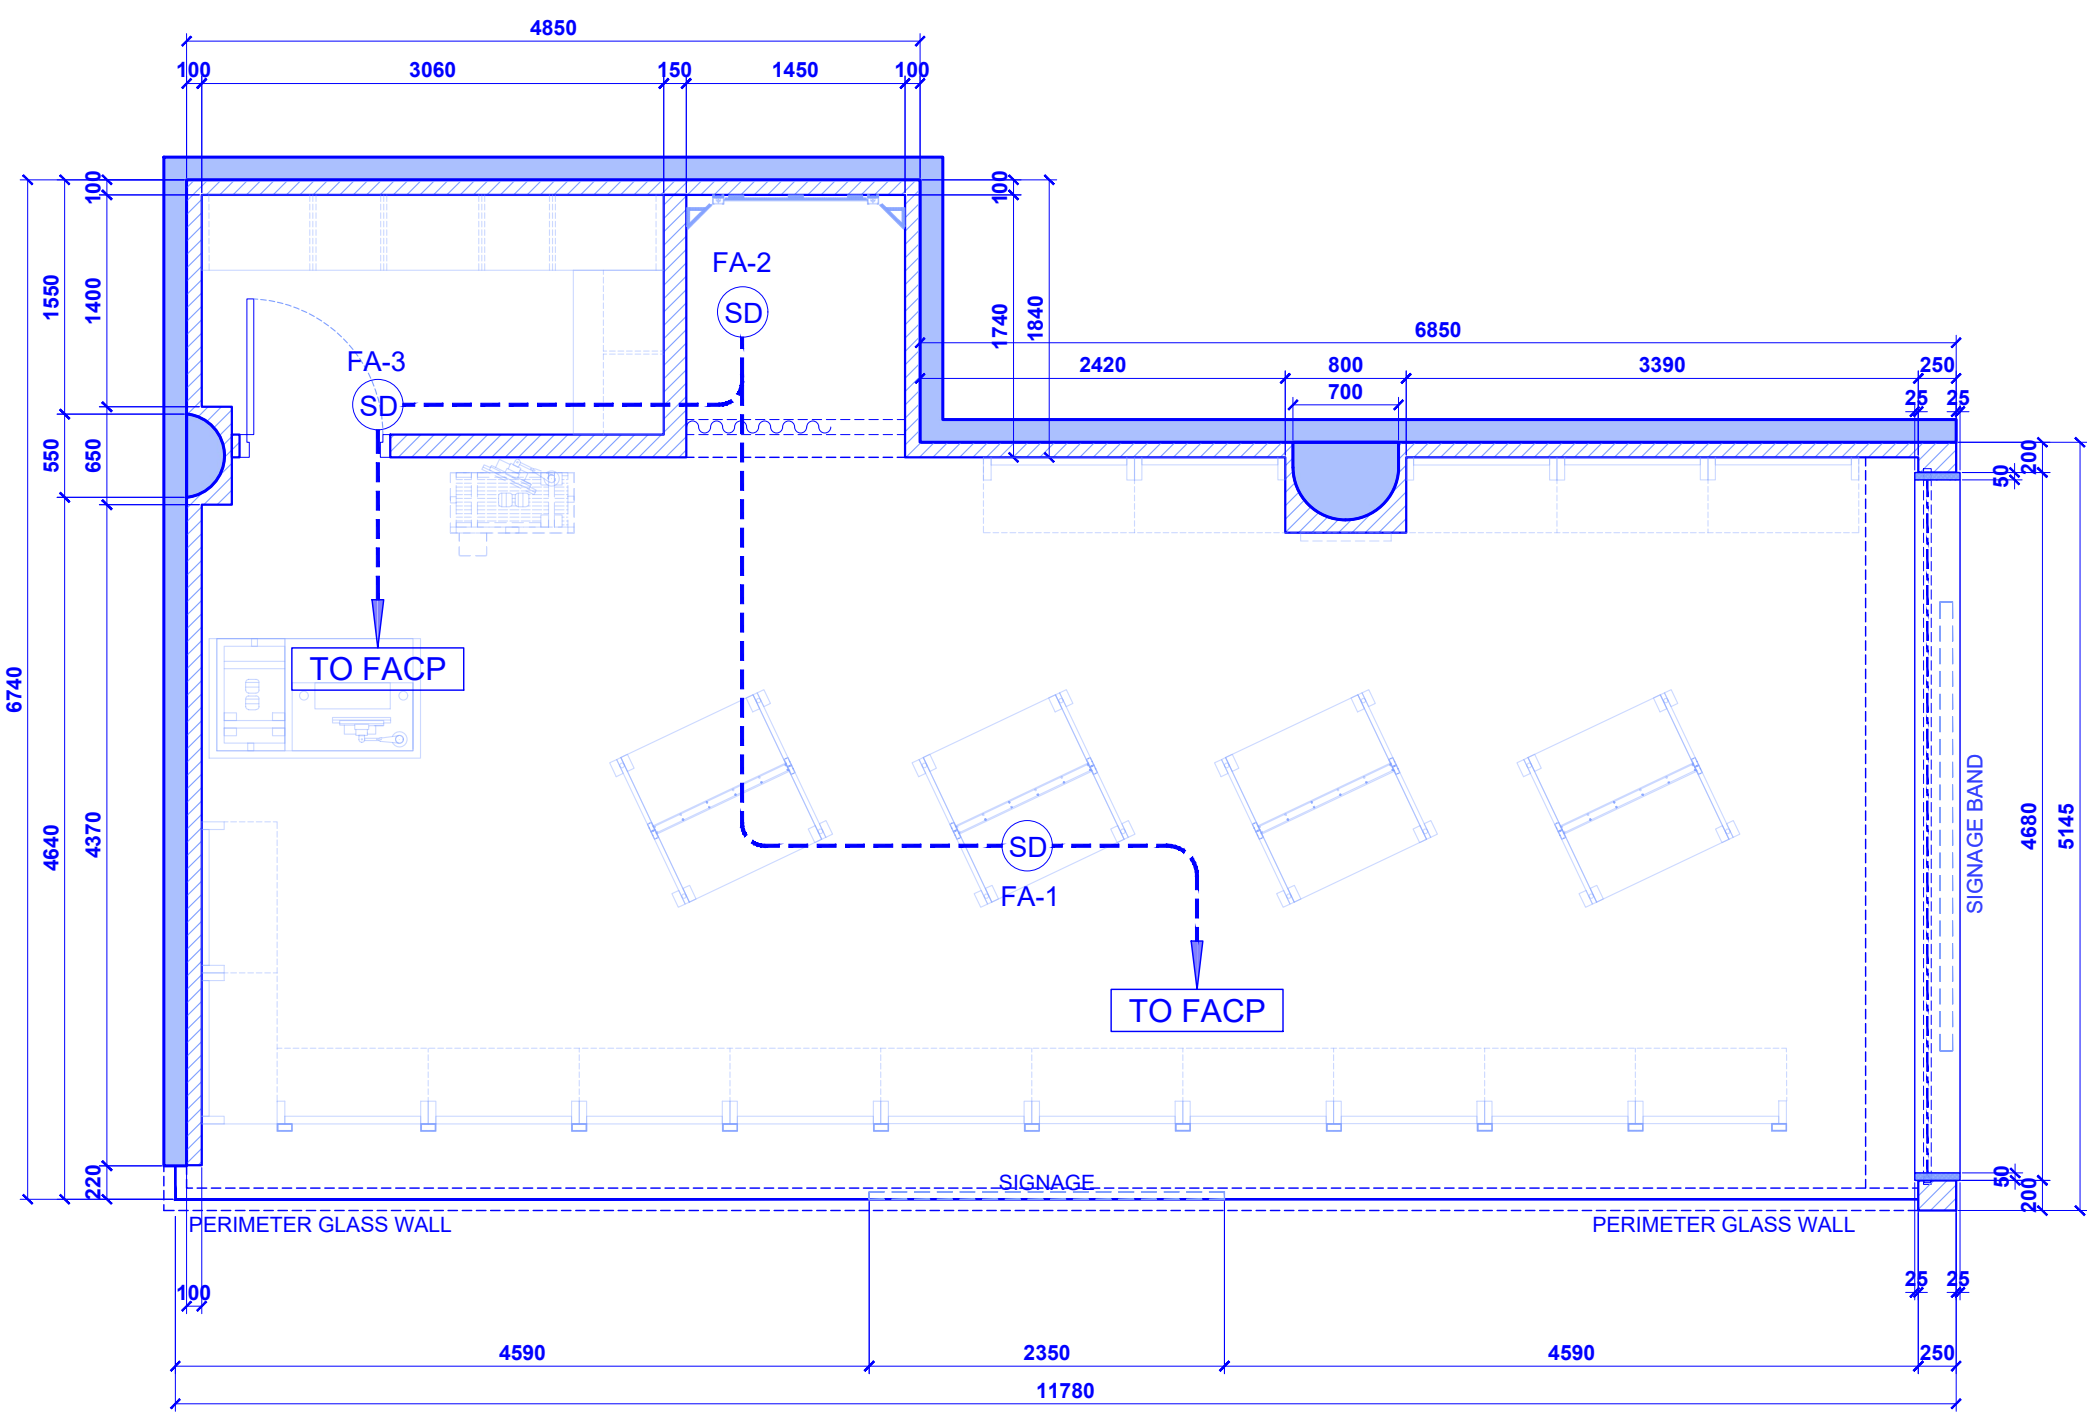



A
ECE-1 SCALE 1:50 M
FIRE DETECTION AND ALARM SYSTEM

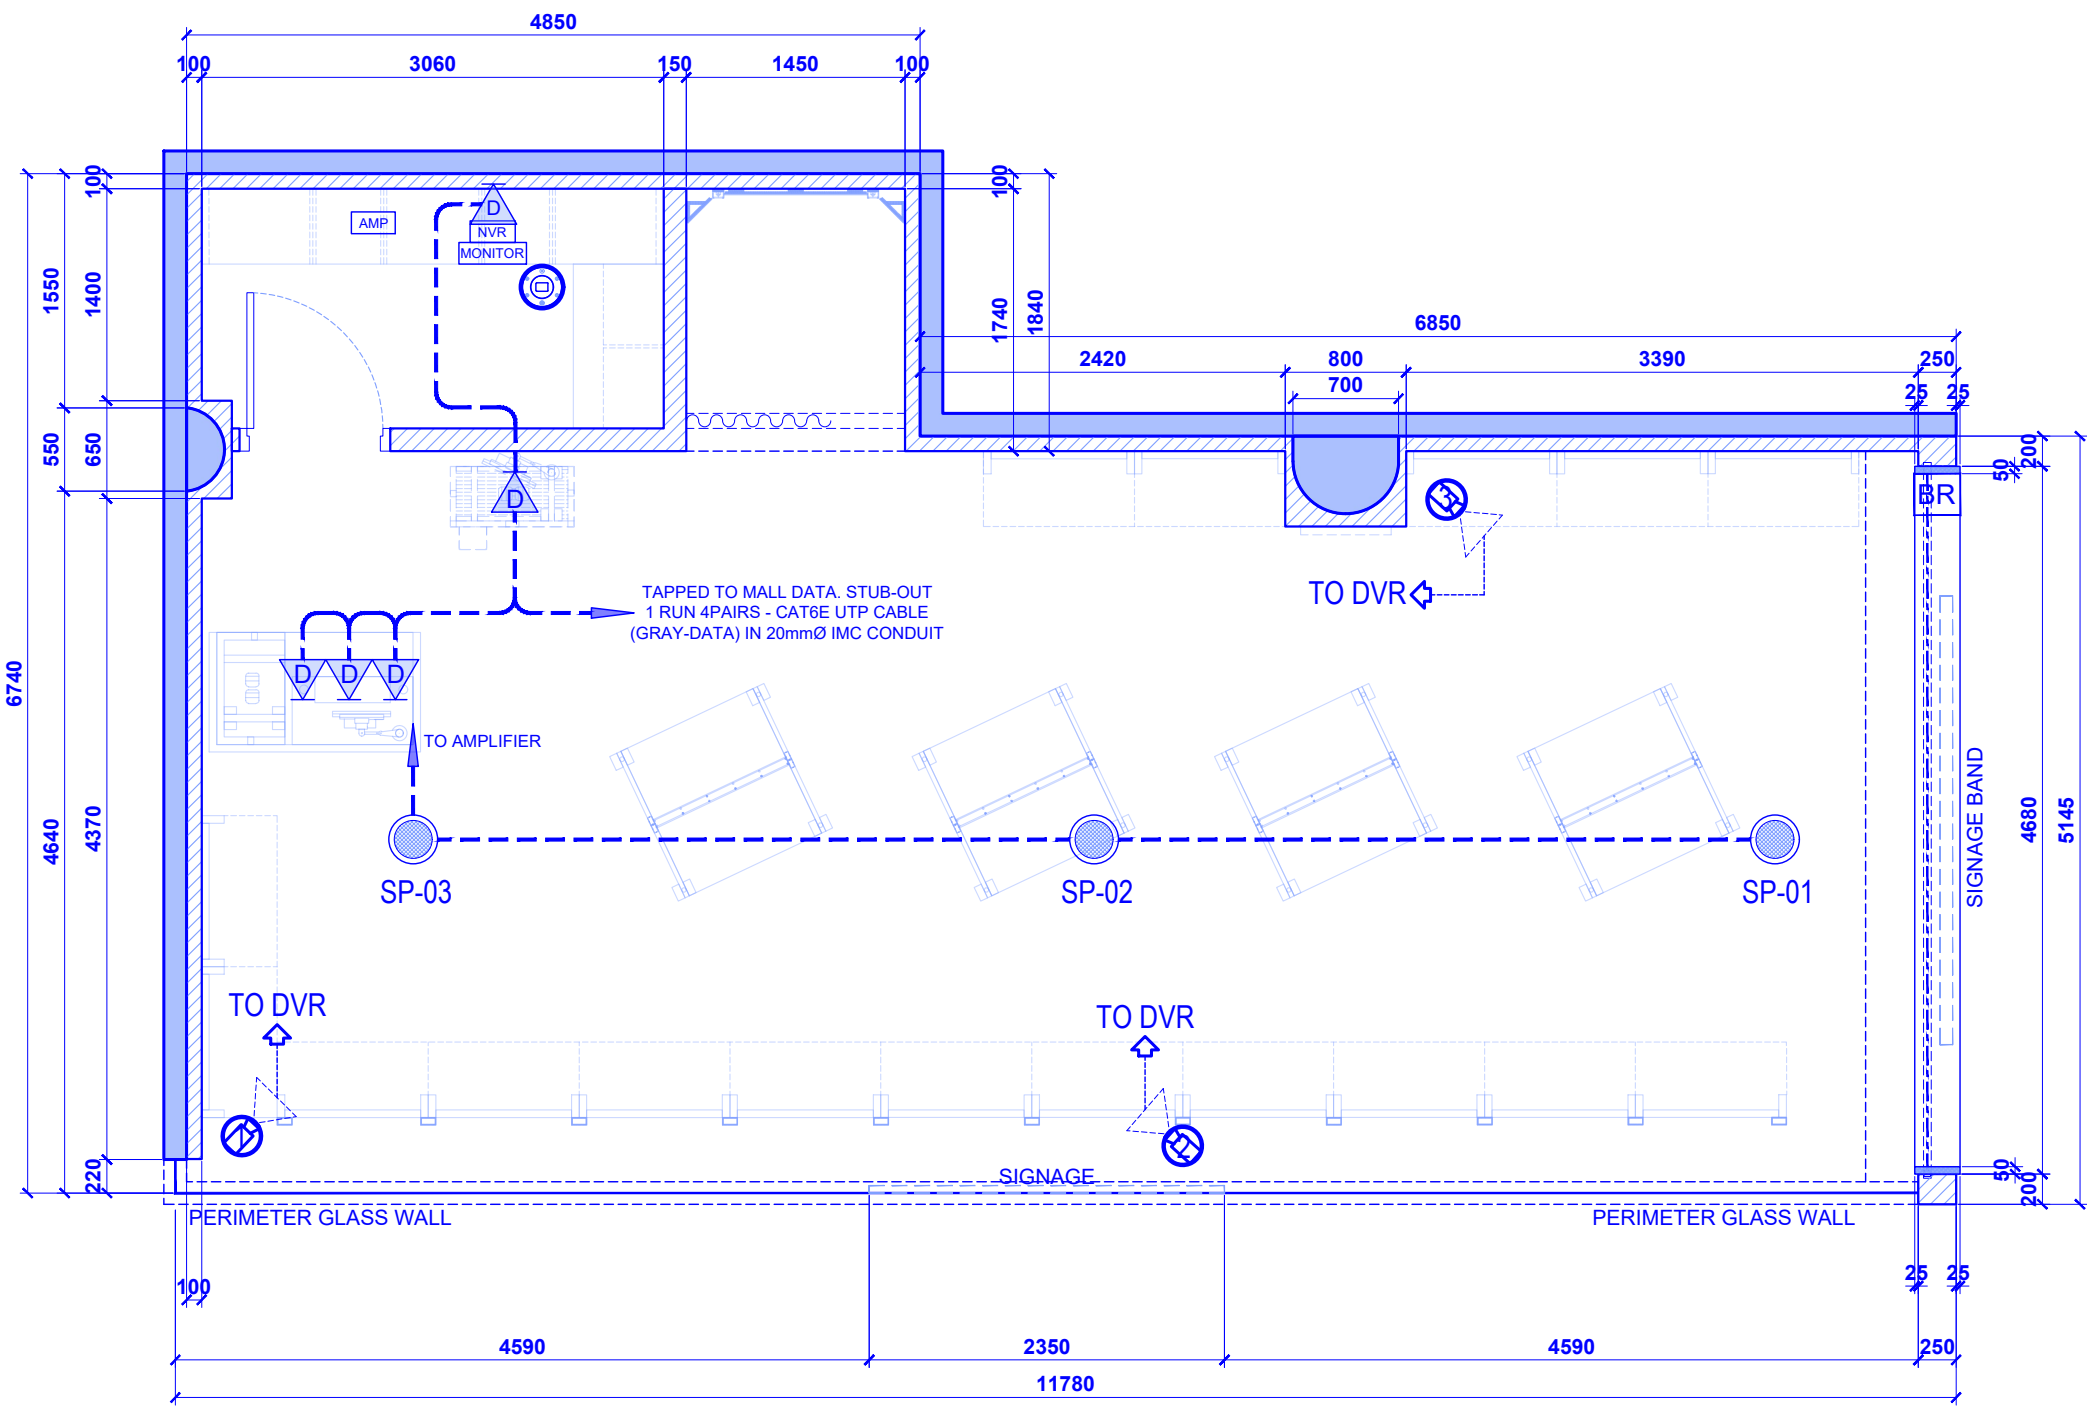

B
ECE-1 SCALE 1:50 M
DATA/TEL, CCTV & SPEAKER LAYOUT

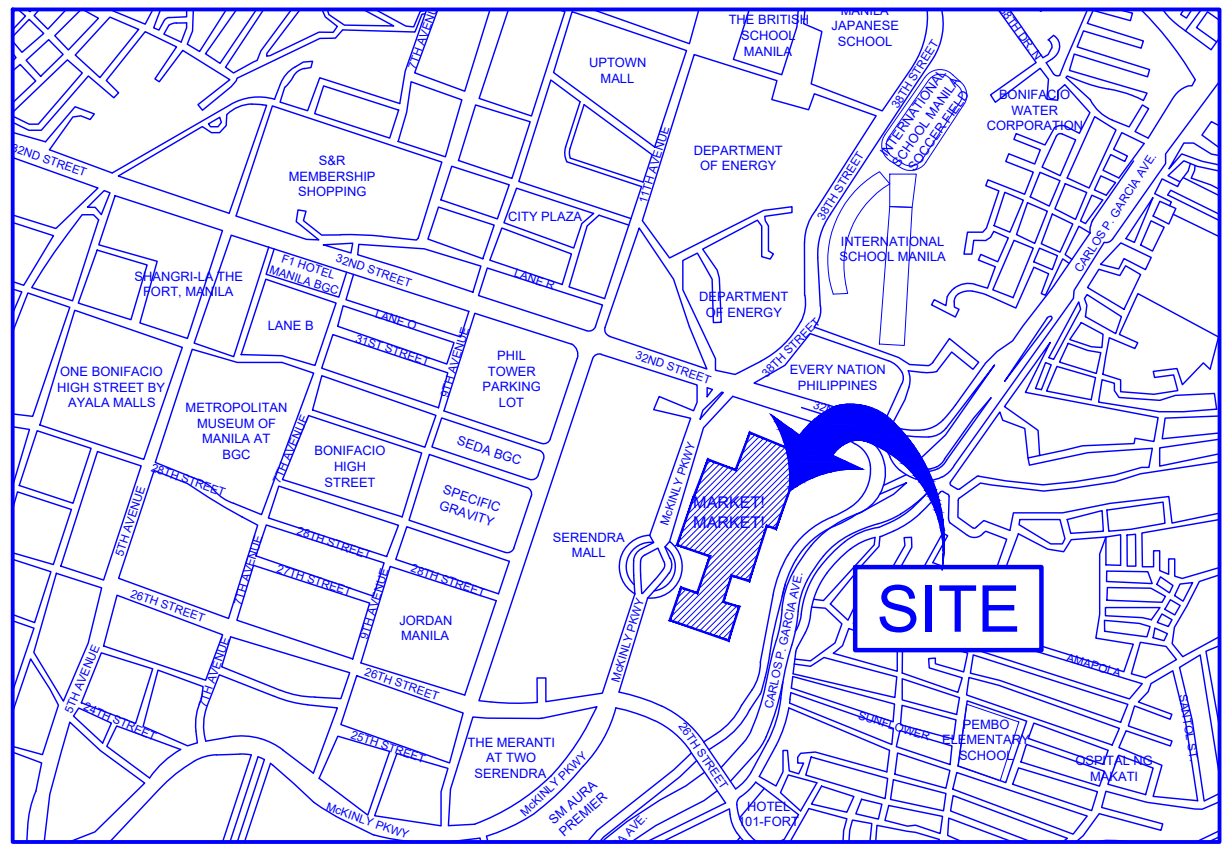

C
ECE-1 SCALE NTS
VICINITY MAP

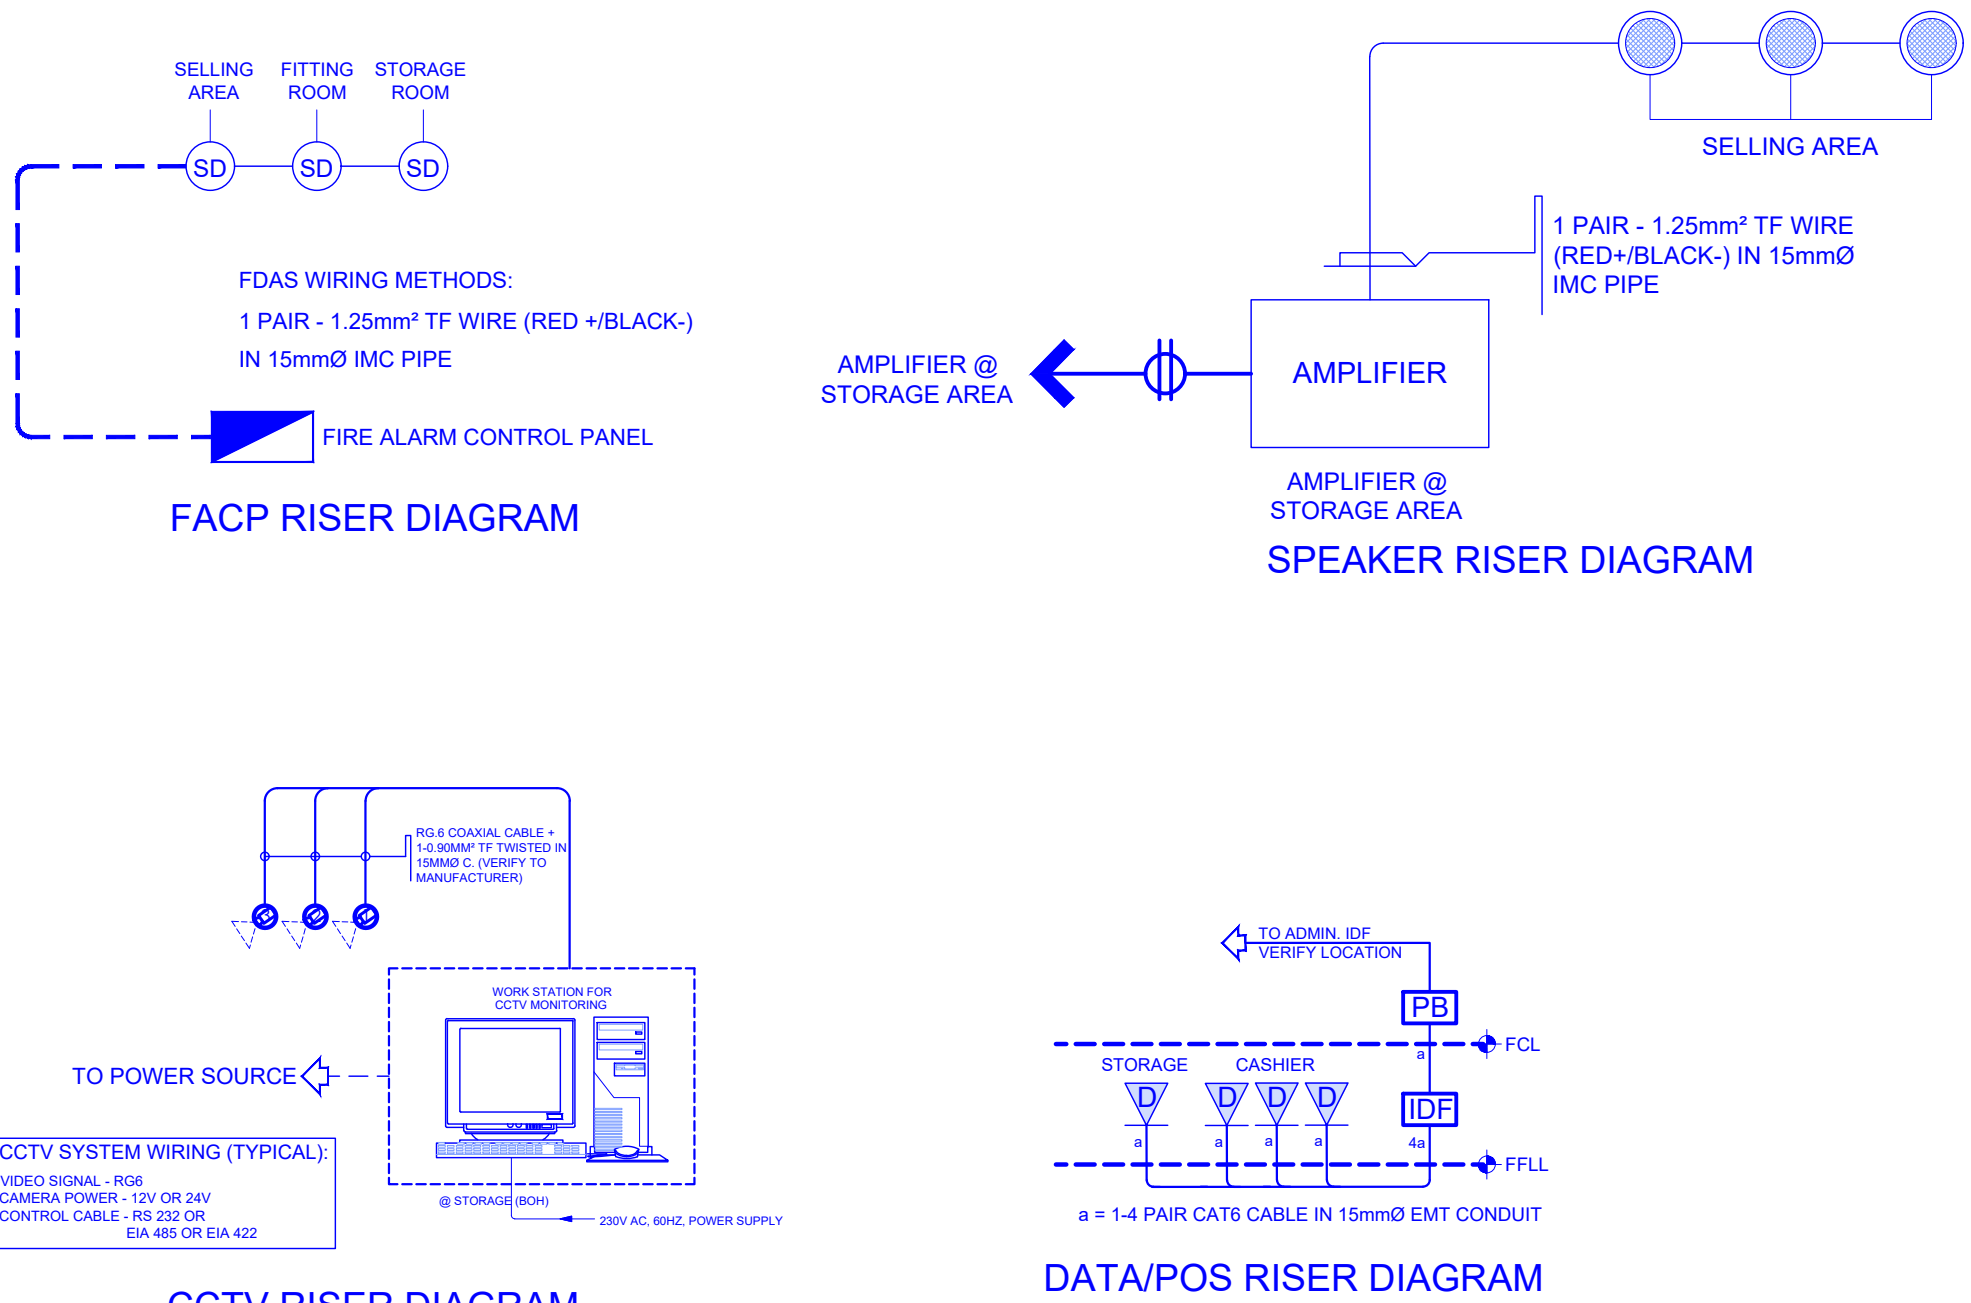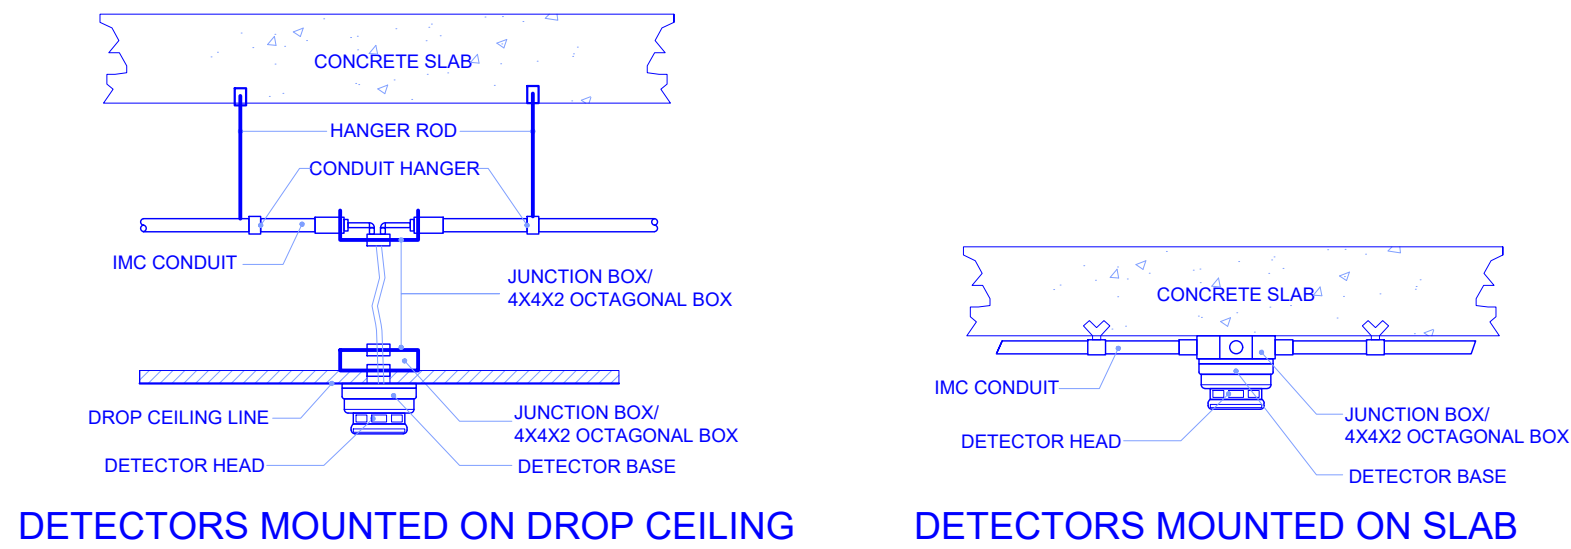

AS-BUILT PLAN



R.A.9266 Section 33

Drawing and specifications and other contract documents signed, stamped or sealed, as instruments of service, are the intellectual property and documents of the architect, whether the object for which they are made is executed or not, if shall be unlawful for any person to duplicate or to make copies of said documents for use in the repetition of and for other projects of building, whether executed partly in whole, without the written consent of architect or author of said documents.

PROFESSIONAL ELECTRONICS ENGINEER		
PRC. NO.:	ISSUED :	VALID :
PTR NO. :	ISSUED :	PLACE :
TIN :		

SEAL

PROJECT TITLE

AS-BUILT OF
DECATHLON CONNECT
(71.95 SQM. INTERIOR RENOVATION)

LOCATION: Unit L1 224-225 Market! Market! McKinley Parkway, Bonifacio Global City, Taguig, Metro Manila

APPROVED BY

DECATHLON PHILIPPINES INC.
LAILA MONICA FLOR
OWNER

ADDRESS:

SHEET CONTENT

-GENERAL NOTES
-VICINITY NOTES
-HANGER DETAIL
-FDAS MOUNTING DETAIL
-FDAS SYSTEM
-DATA/TEL, CCTV & SPEAKER LAYOUT
-SINGLE LINE DIAGRAM

DESIGNED BY:

DRAFTED BY: SBMI

DATE ISSUED:

REVISIONS	DATE
①	①
②	②
③	③

THIS DRAWING IS ISSUED FOR :

☒ AS BUILT
☐ BIDDING
☐ BUILDING PERMIT
☐ CONSTRUCTION
☐ ESTIMATE
☐ FABRICATION
☐ OWNER'S APPROVAL
☐ PRESENTATION

REVISIONS	DATE	REVISIONS	DATE
①	①	①	①
②	②	②	②
③	③	③	③

SHEET NO.

ECE-1

01


01

GENERAL NOTES:


- ALL WORKS SHALL BE DONE IN ACCORDANCE TO THE NATIONAL FIRE PROTECTION AGENCY (NFPA-13) AND FIRE CODE OF THE PHILIPPINES.
- ALL WORKS SHALL BE DONE BY ACCREDITED MALL CONTRACTOR ONLY.
- DO NOT PAINT NOR OBSTRUCT THE SPRINKLER HEADS.
- SECURING OF HOT WORK PERMIT WILL REQUIRE ONLY IF SPRINKLER WORKS WILL HAVE CUTTING, GRINDING OR WELDING WORKS.
- PROVIDE PENDENT HEADS ON AREA WITH CEILING AND UPRIGHT ON AREAS WITHOUT CEILING.
- PENDENT SPRINKLER HEADS SHOULD BE RECESSED TYPE WITH CHROME PLATE FINISH.
- AREA WITH CEILING (COMBUSTIBLE) MUST BE PROVIDED WITH COMBINATION OF UPRIGHT AND PENDENT SPRINKLER HEADS.
- UPRIGHT SPRINKLER HEADS SHOULD BE BRASS TYPE.
- INSTALL ORDINARY SPRINKLER HEAD, 57°C - 77°C (135°F - 170°F) FOR ORDINARY ROOMS. FOR KITCHEN OR OTHER AREAS WITH HEAT EMITTING EQUIPMENT, INSTALL INTERMEDIATE SPRINKLER HEAD, 79°C - 107°C (175°F - 225°F).
- REQUIRED BRAND: VIKING OR VICTAULIC
- ORDINARY SPRINKLER HEAD: RED FUSIBLE GLASS
- INTERMEDIATE SPRINKLER HEAD: GREEN FUSIBLE GLASS
- OBSERVE PROPER LEVEL AND ALIGNMENT OF SPRINKLER HEADS.
- SPACES BETWEEN SPRINKLER HEADS SHOULD NOT BE MORE THAN 3.00 METERS FROM EACH OTHER.
- MAXIMUM DISTANCE OF SPRINKLER HEAD FROM WALL OR PARTITION SHALL BE 1.5 METERS.
- SPRINKLER HEADS SHOULD HAVE A 300mm HORIZONTAL CLEARANCE ON SLAB OR ANY CEILING OBSTRUCTIONS.
- ALL ADDITIONAL BRANCH LINES AND DROPS SHALL BE B.I. PIPE SCHEDULE 40 AND SHALL BE PROVIDED WITH ADEQUATE HANGERS.
- ALL PIPE HANGERS AND SUPPORTS MUST BE SPECIFIED ON THE PLAN, INCLUDING THE EXISTING AND THE NEW INSTALLATION.
- FIRE PIPE LINES SHALL BE BLACK IRON (B.I.), SCHEDULE 40. FITTINGS SHALL CONFORM WITH ASTM A 53/ A153 (SEAMLESS). PIPE THICKNESS: 1" - 0.133mm, 1-1/4" - 0.140mm, 1-1/2" - 0.145mm.
- ALL PIPE HANGERS AND SUPPORTS MUST BE PAINTED WITH DOUBLE COAT OF RUST PROTECTIVE PAINT COLOR AND COATED WITH EPOXY RED PRIMER AND GLOSSY RED FINISH.
- ALL SPRINKLER SYSTEM LINES SHALL BE HYDROSTATIC TESTED AND MUST OBSERVED FOR 24HRS.
- PROVIDE FIRE EXTINGUISHER.
- INDICATE ON THE PLAN / LEGEND THE TYPE OF SPRINKLER USED.

LEGEND & SYMBOLS


- MAIN CONNECTION
- EXISTING SPRINKLER LINE/HEAD
- DROPPING LINE FOR PENDENT SPRINKLER HEAD
- A ADDITIONAL SPRINKLER HEAD
- R RELOCATED SPRINKLER HEAD
- P PENDENT SPRINKLER HEAD
- U UPRIGHT SPRINKLER HEAD
- E EXISTING UPRIGHT SPRINKLER HEAD FROM MALL
- 10lbs. CEILING MOUNTED HFC-236FA TYPE
- 10lbs. TYPE HFC-236fa PORTABLE FIRE EXTINGUISHER (x4pcs.)

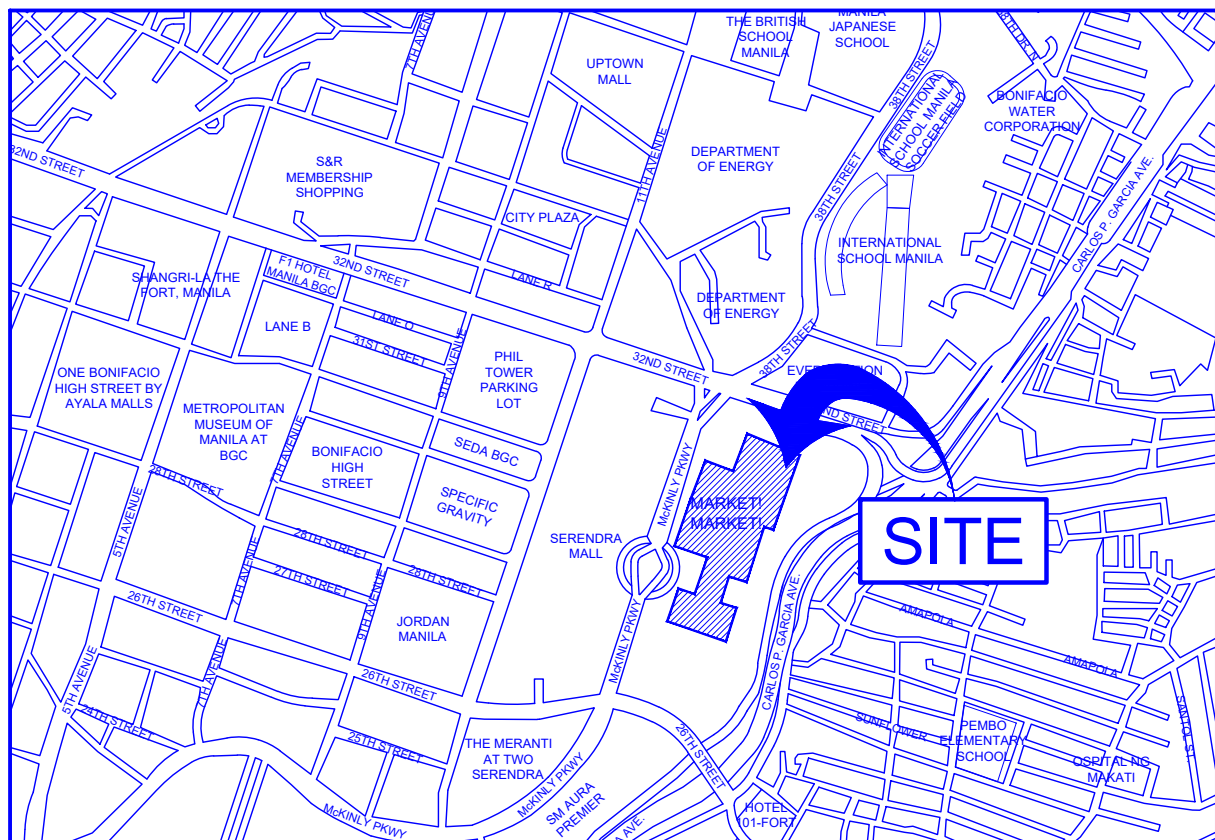


B VICINITY MAP
SCALE NTS

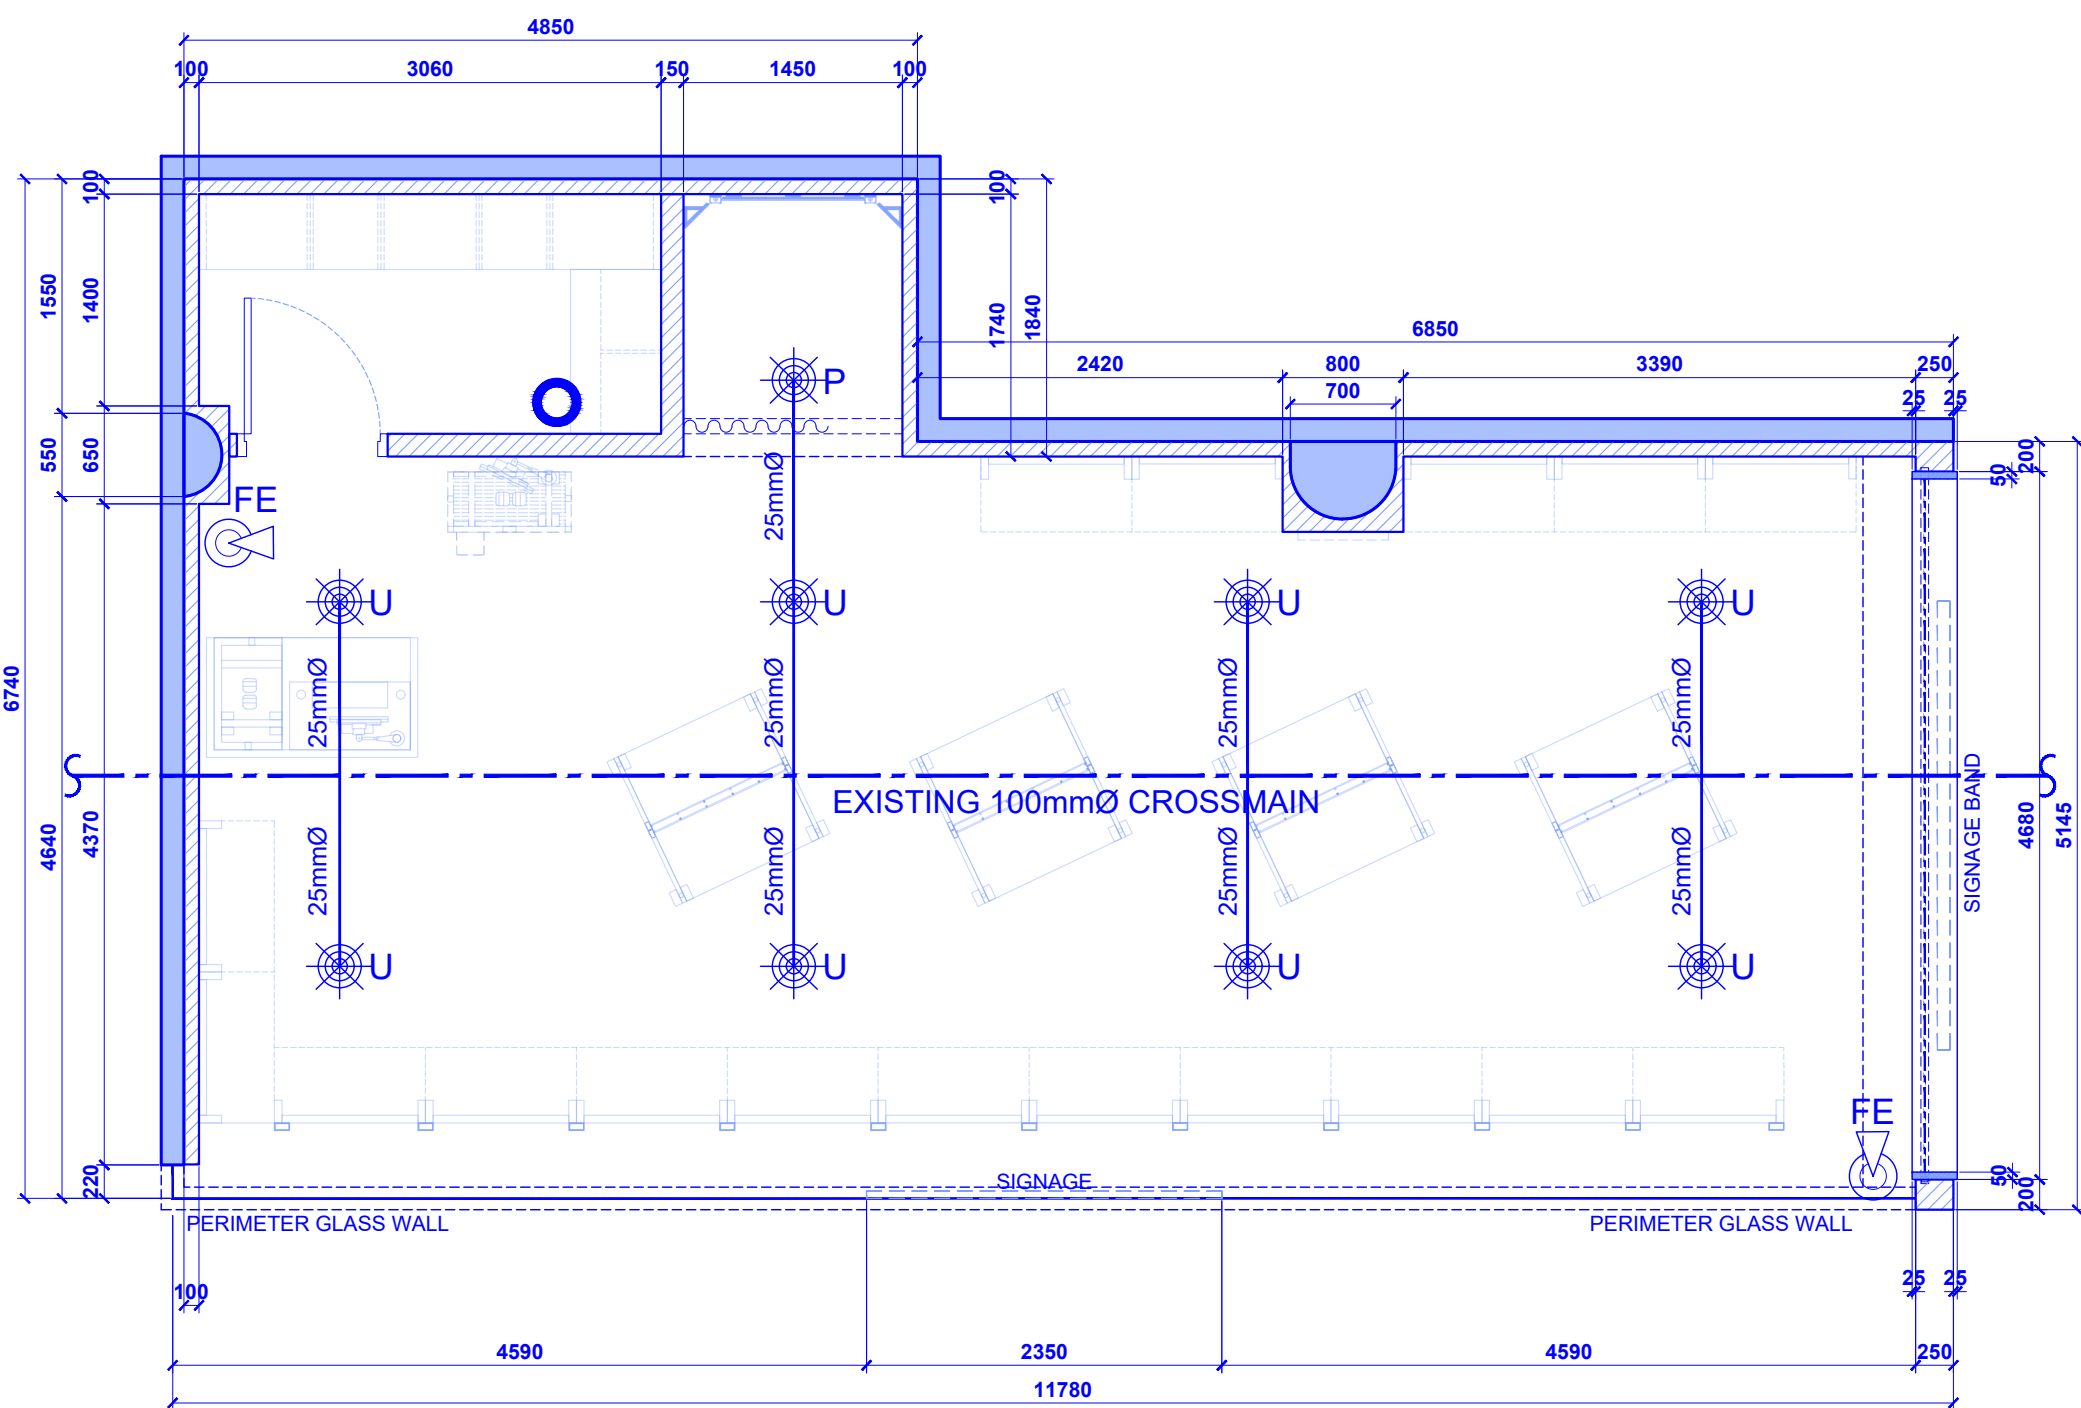

A FIRE PROTECTION SYSTEM LAYOUT
SCALE 1:50 M

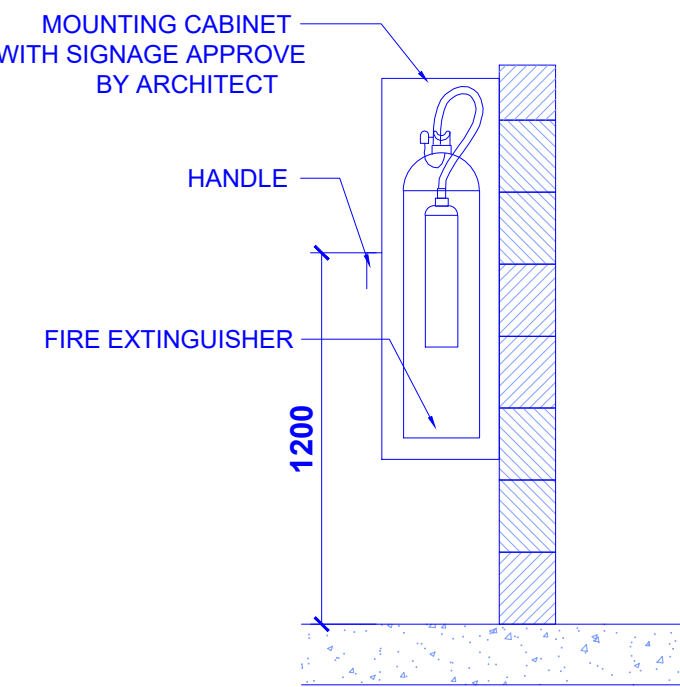

C FIRE EXTINGUISHER DETAIL
SCALE NTS

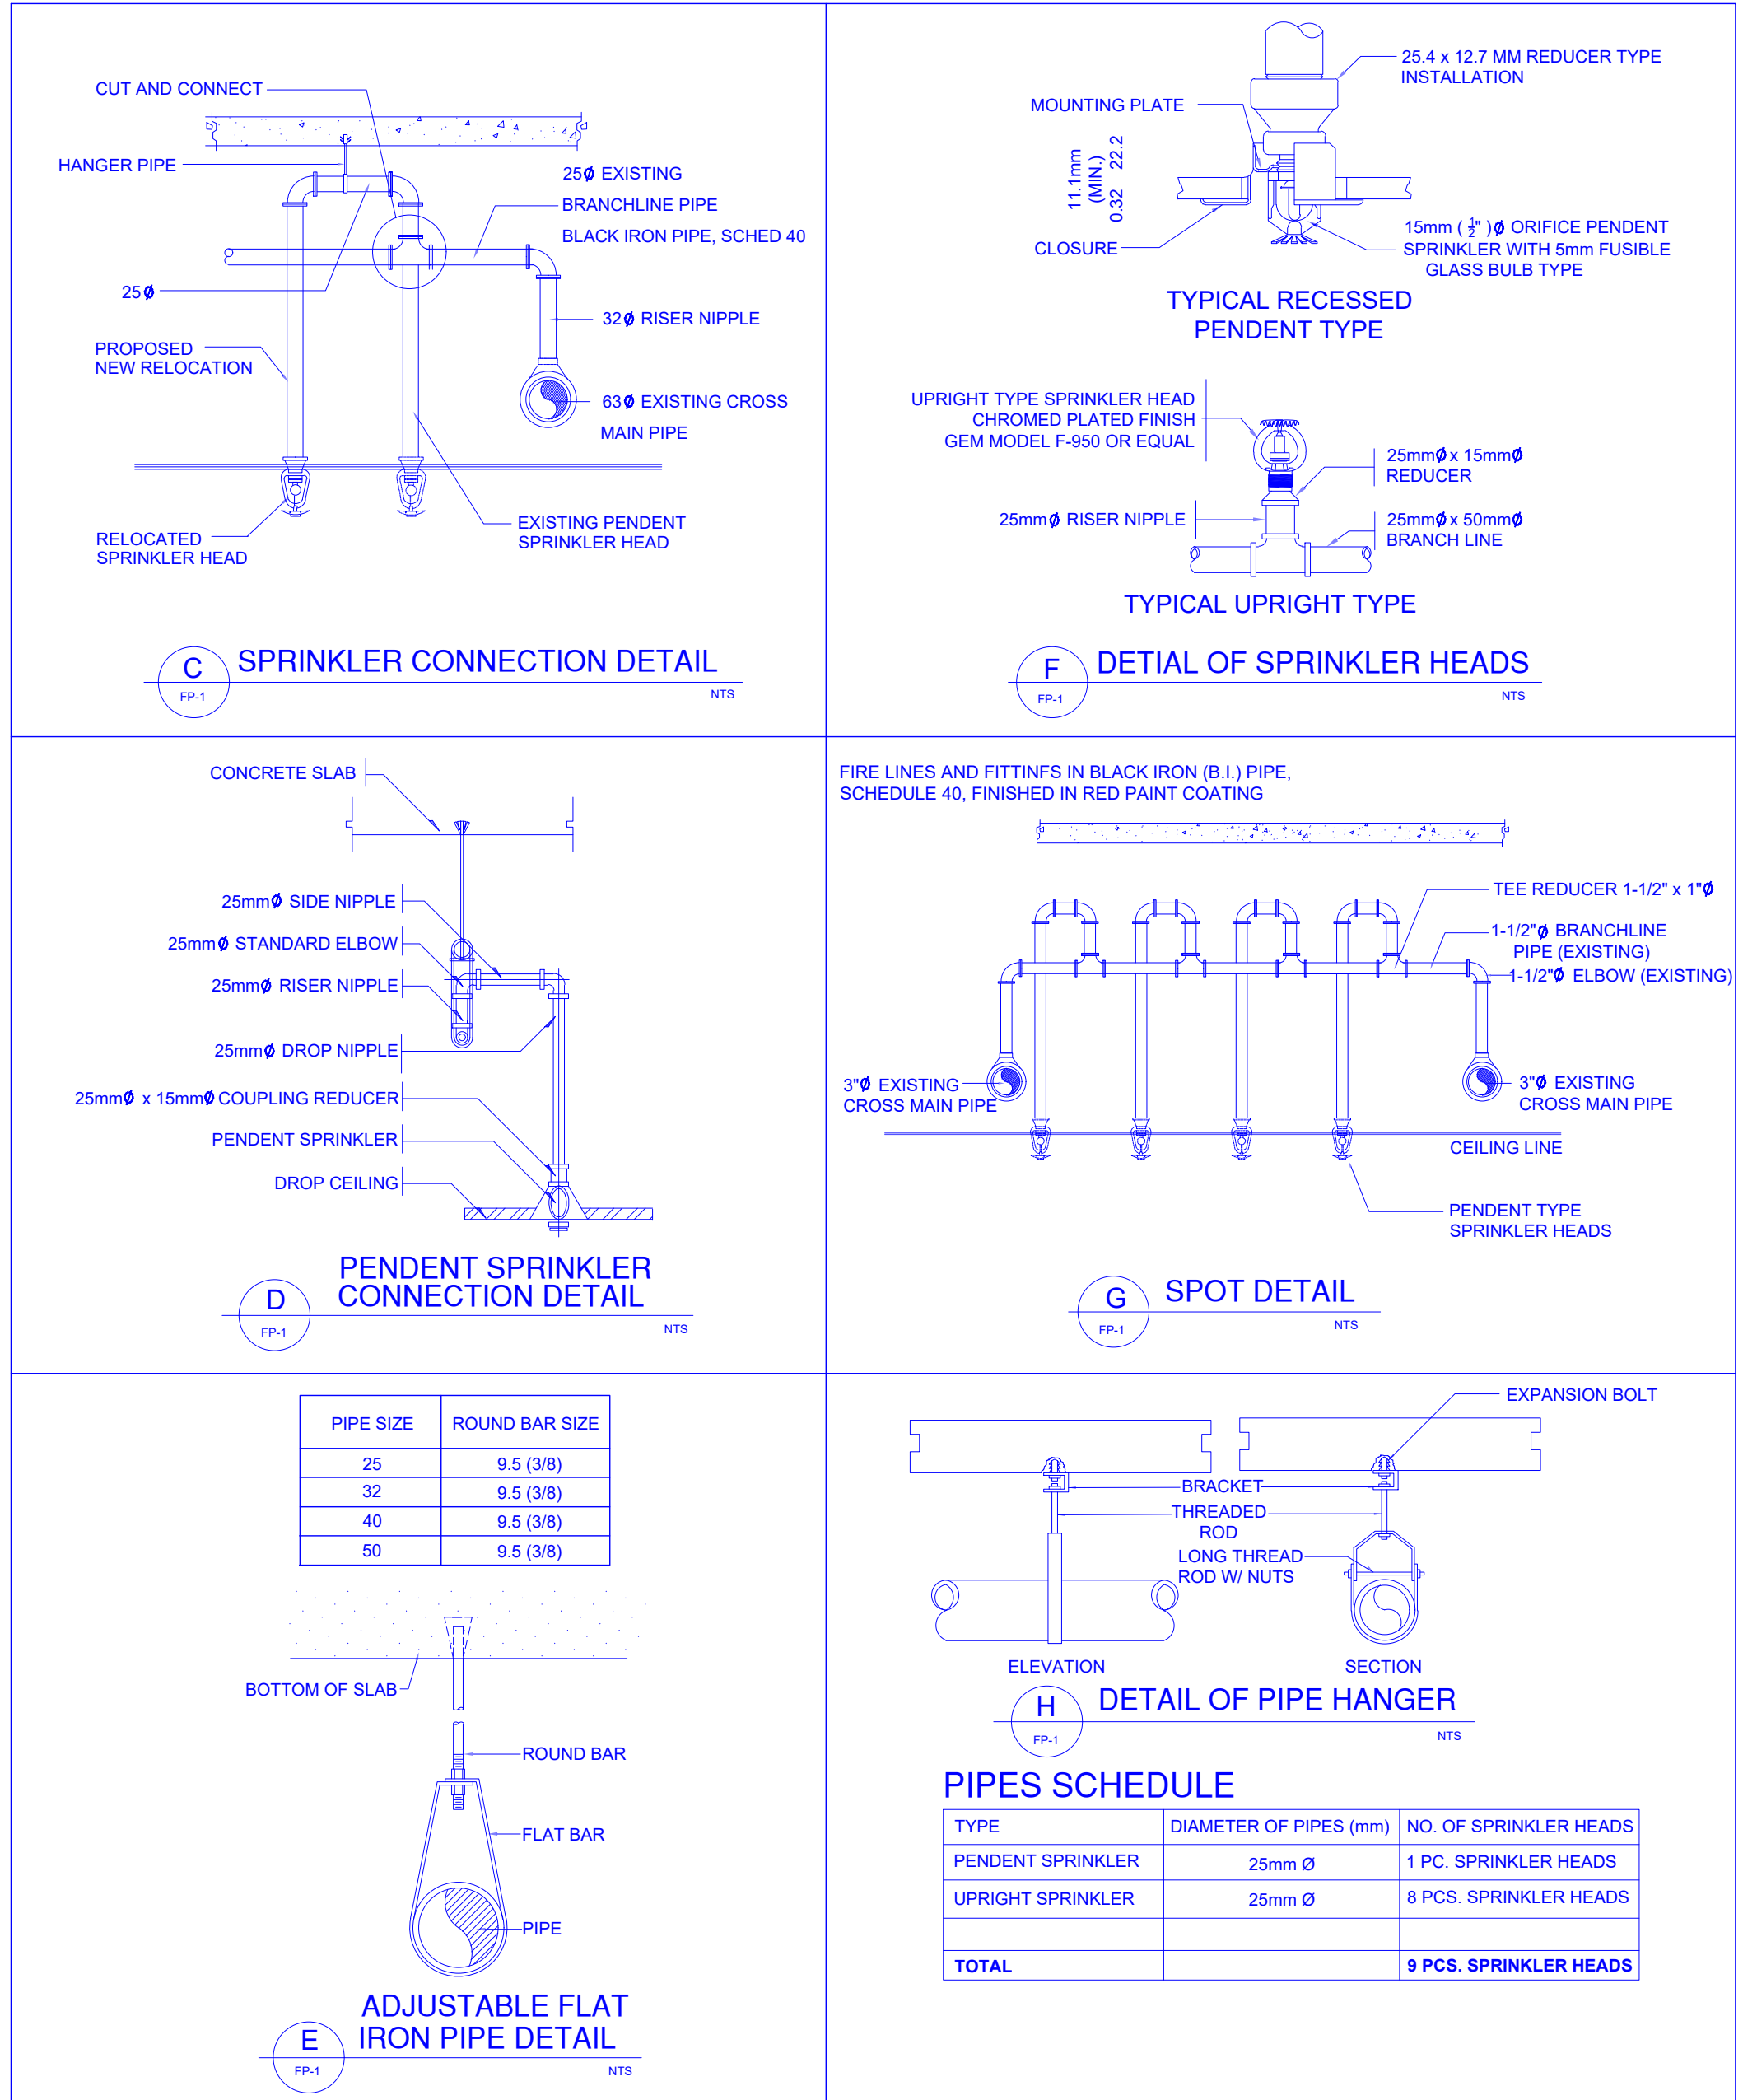

REPUBLIC OF THE PHILIPPINES
DEPARTMENT OF
PUBLIC WORKS & HIGHWAYS

OFFICE OF THE BUILDING OFFICIAL
CITY OF TAGUIG

ISSUANCE RECOMMENDED

SECTION HEAD: DATE
ISSUED BY:

BUILDING OFFICIAL DATE

AS-BUILT PLAN



R.A.9266 Section 33

Drawing and specifications and other contract documents signed, stamped or sealed, as instruments of service, are the intellectual property and documents of the architect, whether the object for which they are made is executed or not, if shall be unlawful for any person to duplicate or to make copies of said documents for use in the repetition of and for other projects of building, whether executed partly in whole, without the written consent of architect or author of said documents.

PROFESSIONAL MECHANICAL ENGINEER

PRC. NO.:	ISSUED :	VALID :
PTR NO.:	ISSUED :	PLACE :
TIN :		

SEAL

PROJECT TITLE

AS-BUILT OF
DECATHLON CONNECT
(71.95 SQM. INTERIOR RENOVATION)

LOCATION: Unit L1 224-225 Market! Market! McKinley Parkway, Bonifacio Global City, Taguig, Metro Manila

APPROVED BY

DECATHLON PHILIPPINES INC.
LAILA MONICA FLOR
OWNER

ADDRESS:

SHEET CONTENT

GENERAL NOTES
FIRE PROTECTION SYSTEM
LEGEND & SYMBOLS
VICINITY MAP
FIRE EXTINGUISHER DETAIL
SPRINKLER DETAILS

DESIGNED BY:

DRAFTED BY: SBMI
DATE ISSUED:

REVISIONS	DATE	REVISIONS	DATE
①		①	
②		②	
③		③	

THIS DRAWING IS ISSUED FOR :

☒ AS BUILT	☐ ESTIMATE
☐ BIDDING	☐ FABRICATION
☐ BUILDING PERMIT	☐ OWNER'S APPROVAL
☐ CONSTRUCTION	☐ PRESENTATION

SHEET NO.


FP-1

01



01

GENERAL NOTES:


- CONTRACTOR IS ADVISED TO HAVE AN ACTUAL SURVEY OF THE EXISTING CONDITION AT SITE.
- ALL EQUIPMENT SHALL BE INSTALLED IN APPROXIMATE LOCATION AS SHOWN ON THE PLANS.
- INSTALLATION OF ALL WORKS SHALL BE DONE IN A NEAT AND WORKMANLIKE MANNER, IMPROPERLY SETWORK OR FINISH AS DETERMINED BY THE ARCHITECT SHALL BE REMOVED AND REPLACED AT NO EXTRA COST.
- ALL EQUIPMENT SHALL BE ON 150mm THICK , LEVEL REINFORCED STEEL BASE, UNLESS OTHERWISE SPECIFIED. (FOR FLOOR MOUNTED EQUIPMENT)
- ALL EQUIPMENT SHALL BE MOUNTED ON OR SUPPORTED BY VIBRATION ISOLATOR OR ASSEMBLIES.
- ALL UNIT CEILING CONCEALED SHALL HAVE SERVICE ACCESS TO BE PROVIDED BY THE CIVIL CONTRACTOR.
- ALL PIPING SHALL BE LEAK TESTED WITH A PRESSURE OF AT LEAST 1-1/2 TIMES THE DESIGN WORKING PRESSURE (24 HRS.)
- ALL MATERIALS SHALL BE NEW & CLEAN.
- DEVIATIONS AND REVISIONS FROM THE PLANS SHALL BE PREFERRED TO THE ARCHITECTS FOR REVIEW AND APPROVAL.
- ALL NECESSARY GOVERNMENT PERMITS SHALL BE SECURED AND BORNE BY THIS CONTRACTOR.
- ALL WORKS SHALL BE GUARANTEED FOR A PERIOD OF ONE (1) YEAR AFTER DATE OF ACCEPTANCE.
- THE AIR CONDITIONING AND VENTILATION SYSTEM SHOULD BE PROPERLY BALANCE BY A SEPARATE CONTRACTOR AND TO SUBMIT BALANCING REPORT FOR EVALUATION (BY TENANT'S CONTRACTOR).
- THIS CONTRACTOR SHOULD COORDINATE HIS WORKS CLOSELY WITH THE WORKS OF OTHER TRADES. PROVISION FOR THE PIPE PASSAGES THRU WALLS SHALL BE COORDINATED IN ADVANCE WITH THE BUILDING CONTRACTOR. FAILURE ON THE PART OF THUS TO MAKE SUCH PROVISION IN ADVANCE SHALL MEAN PROVIDING THEM LATER AT HIS OWN EXPENSE.
- ALL WORKS SHALL CONFORM WITH MALL DESIGN GUIDELINES.

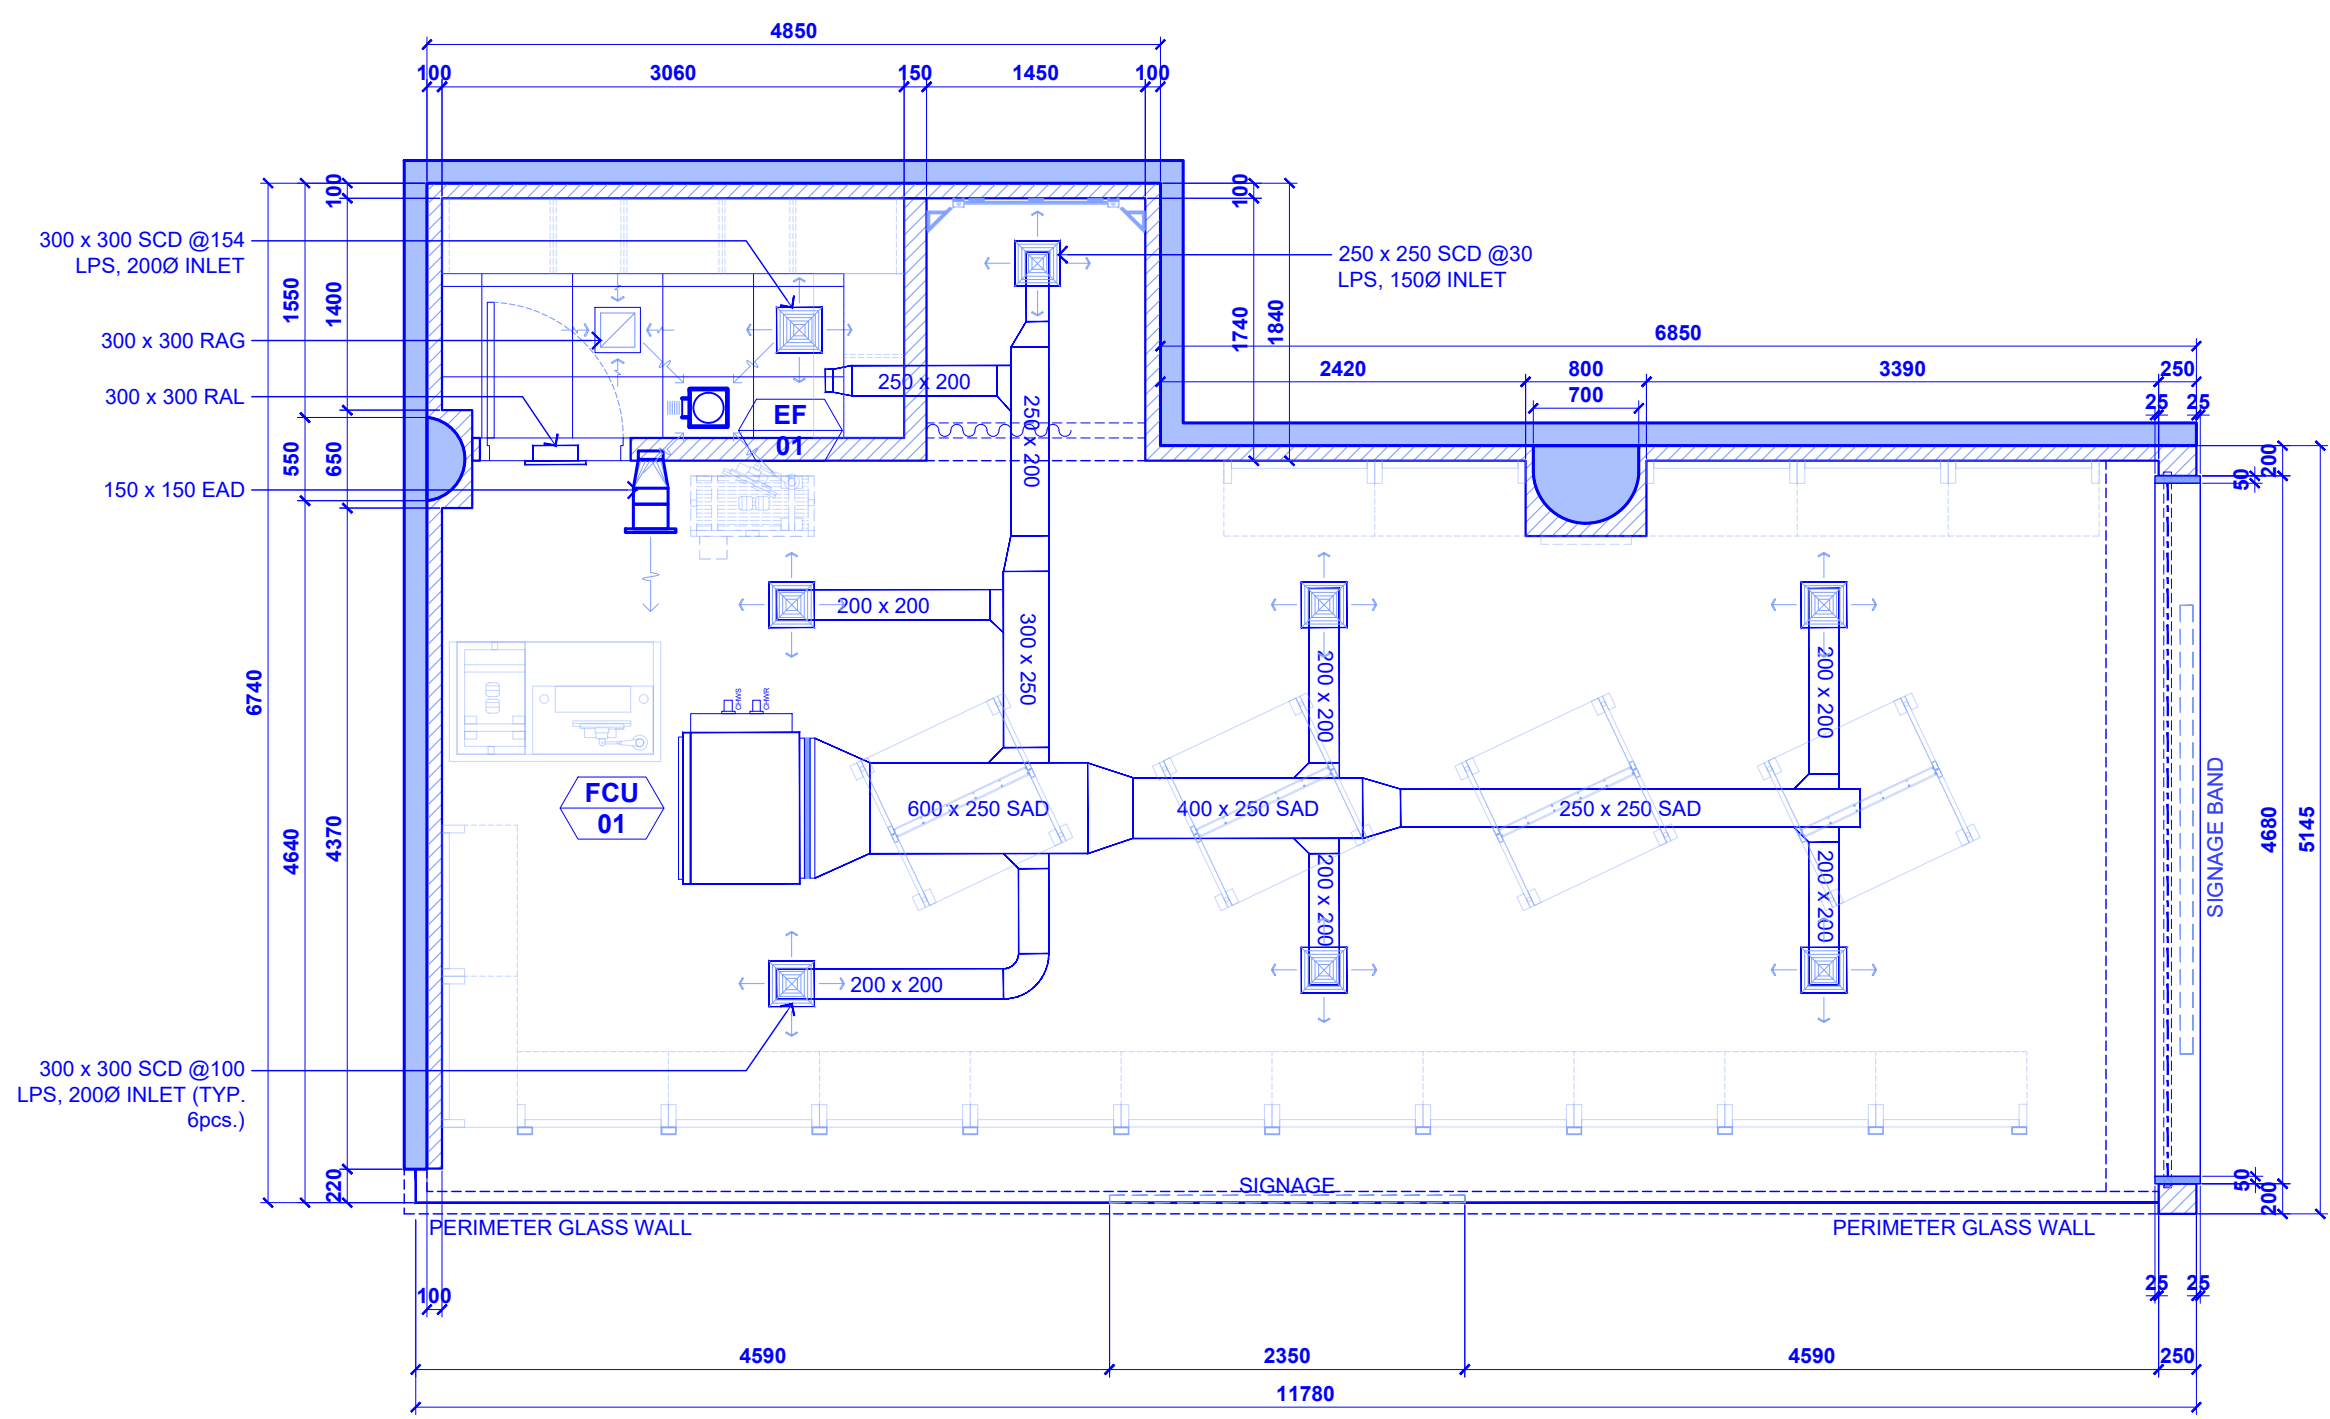



AIR-CONDITIONING LAYOUT
M-1 SCALE 1:50 M

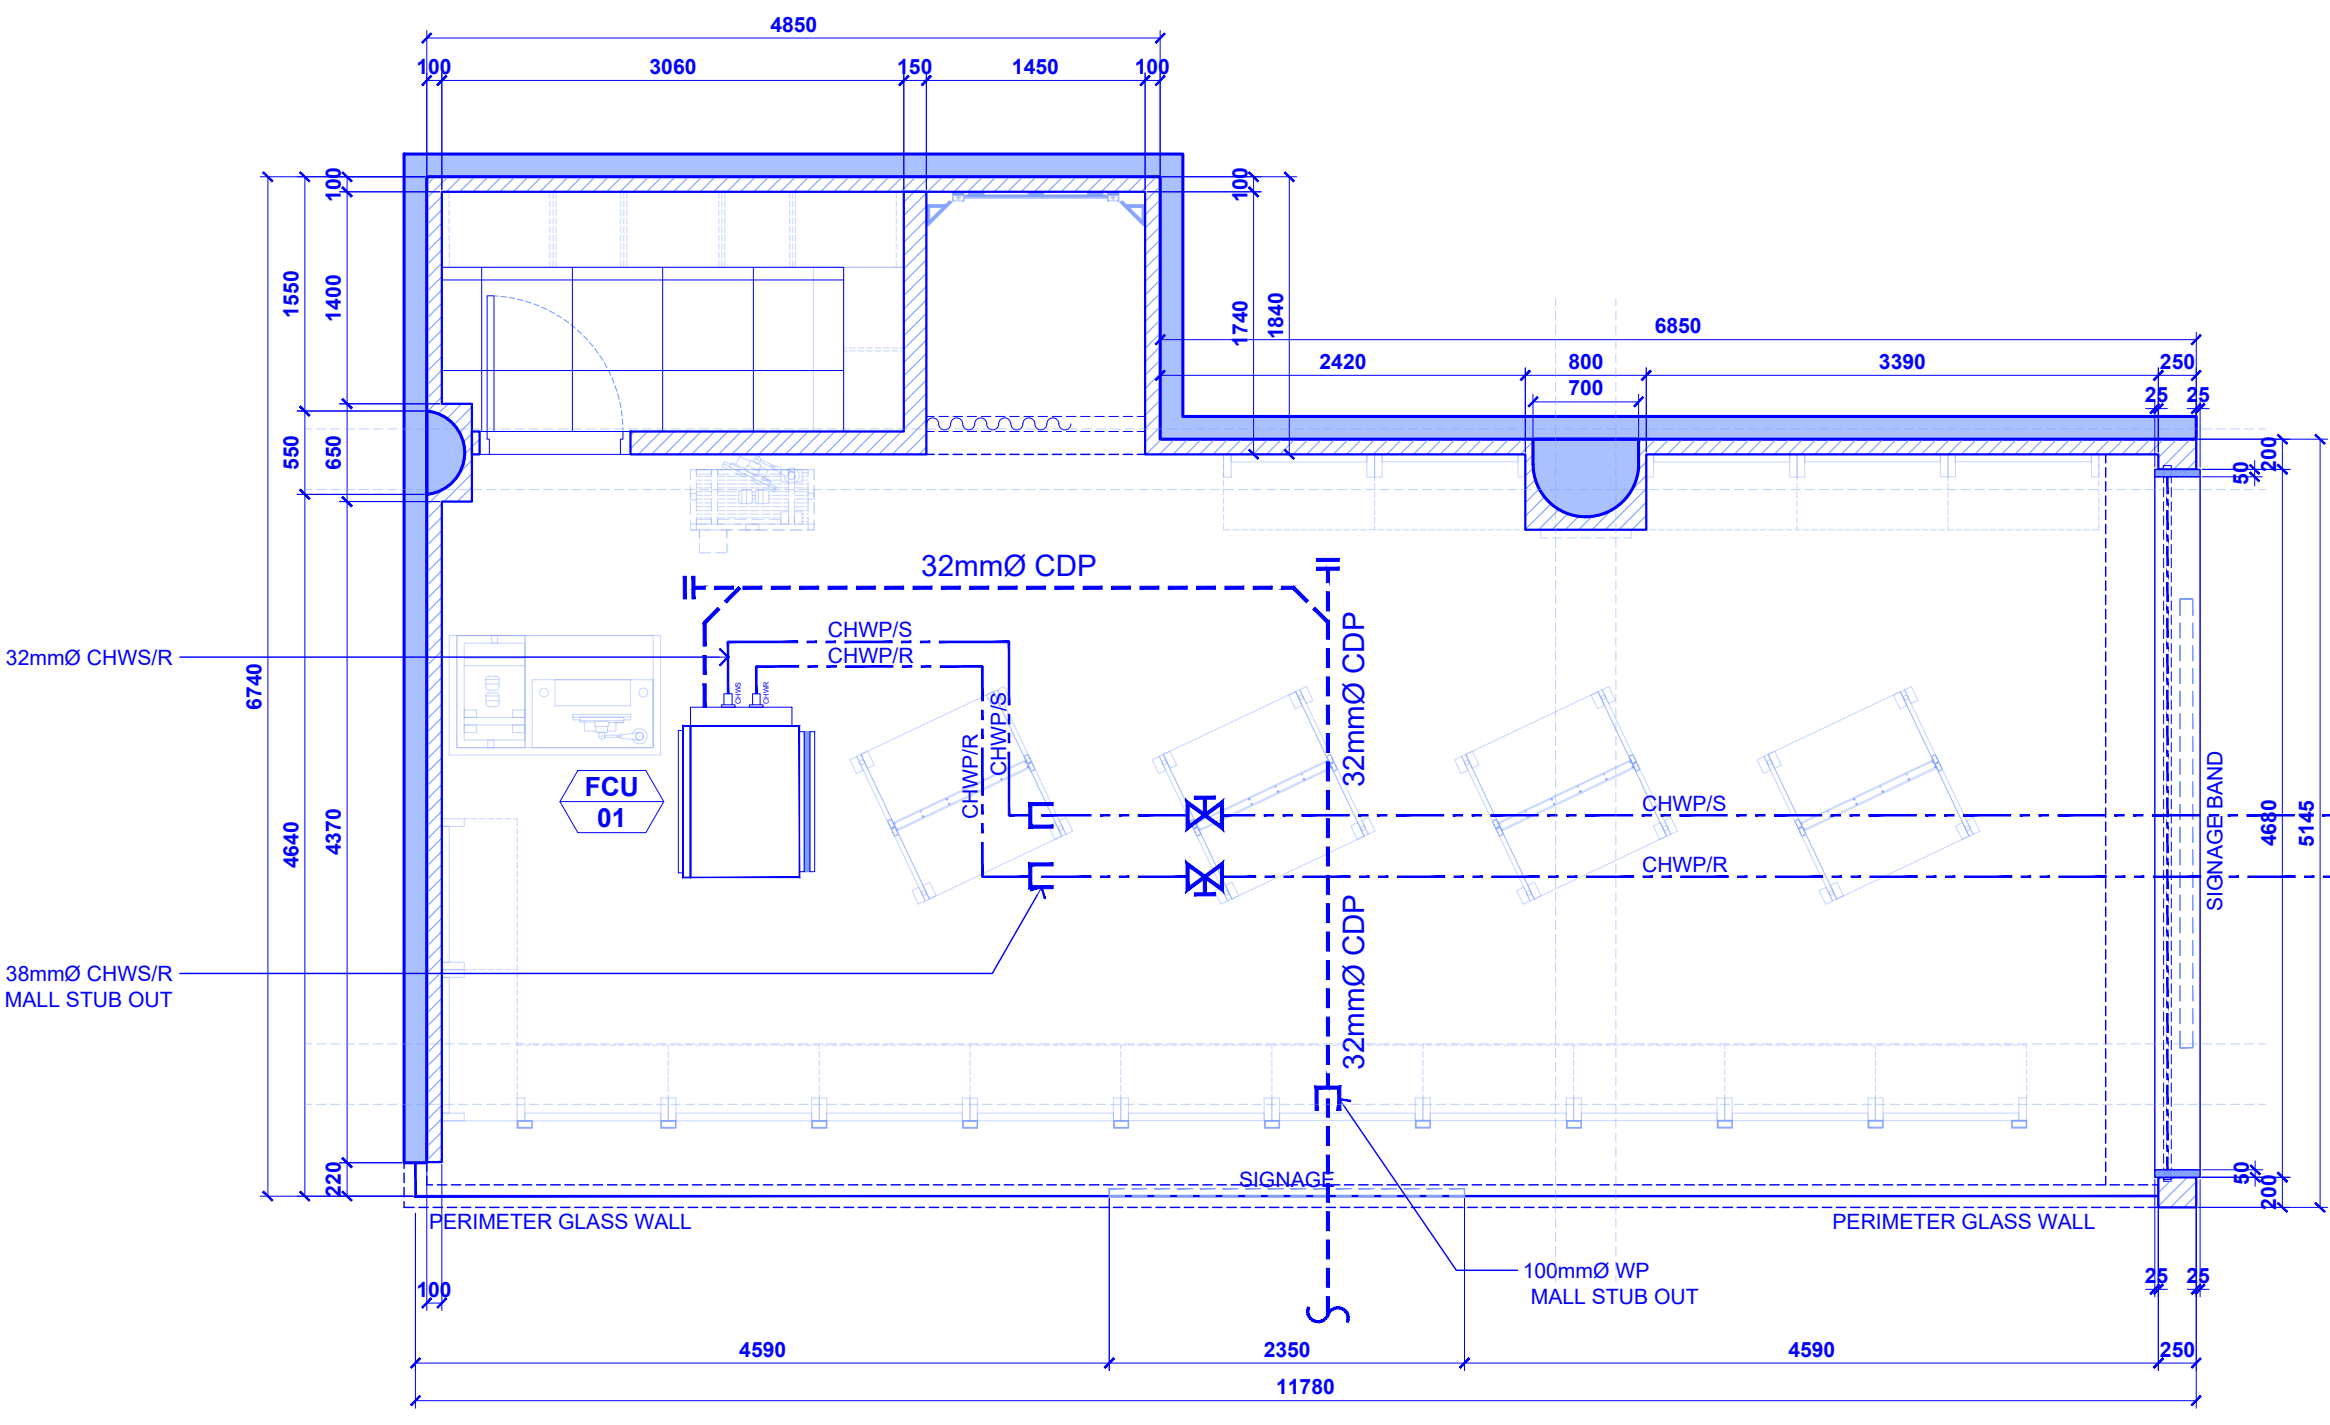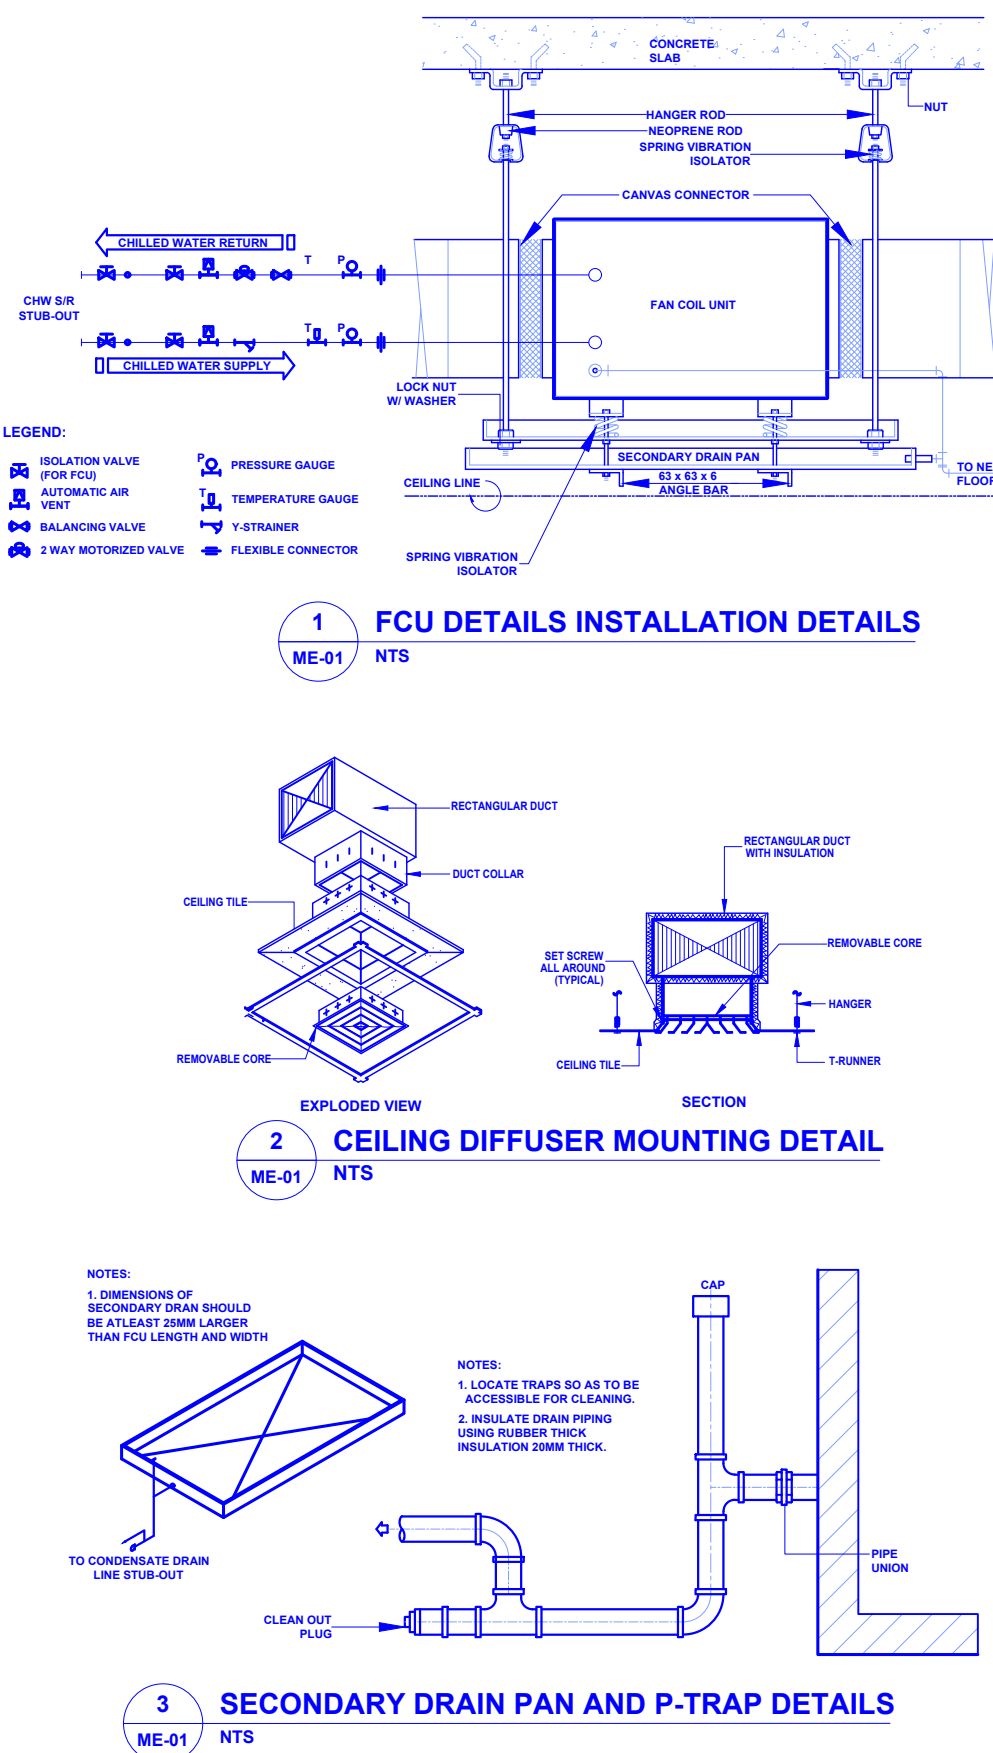

CHILLED WATER AND CONDENSATE DRAIN PIPING
M-1 SCALE 1:50 M

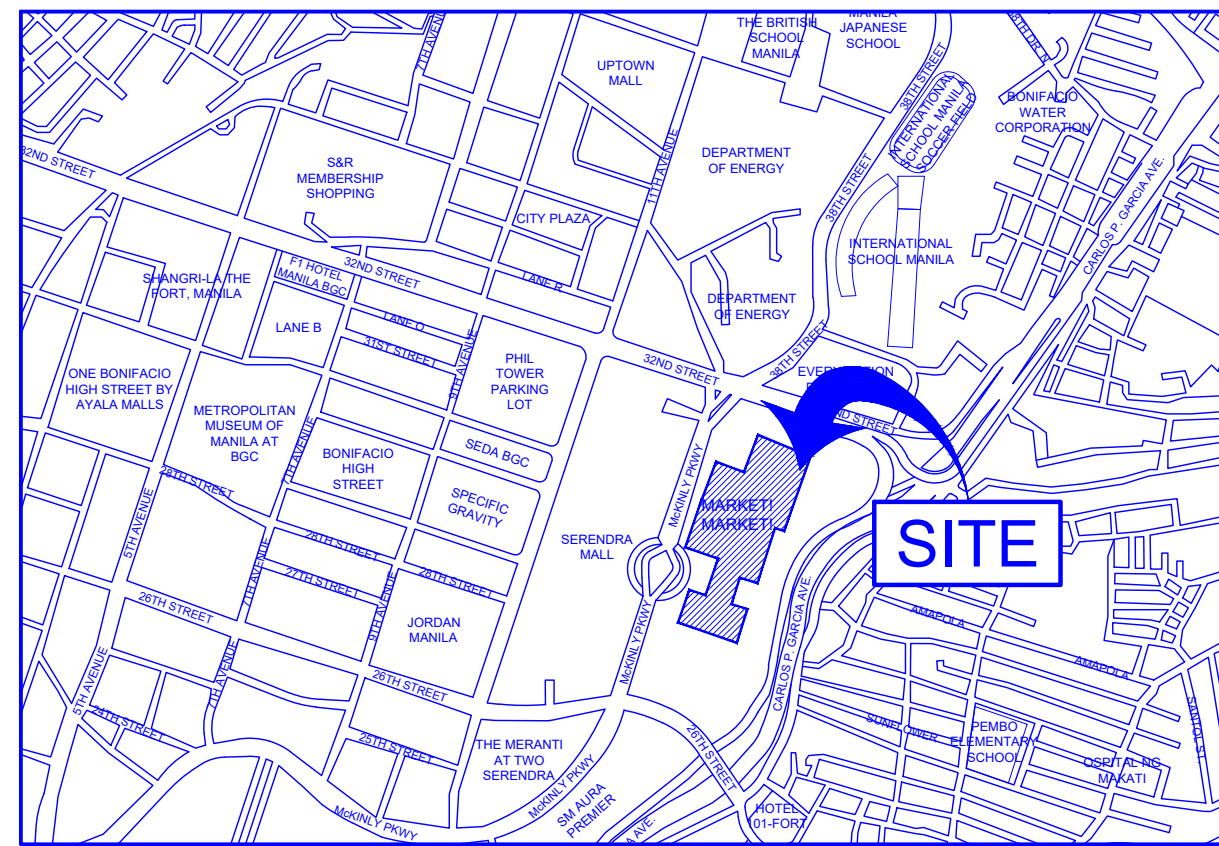

VICINITY MAP
M-1 SCALE

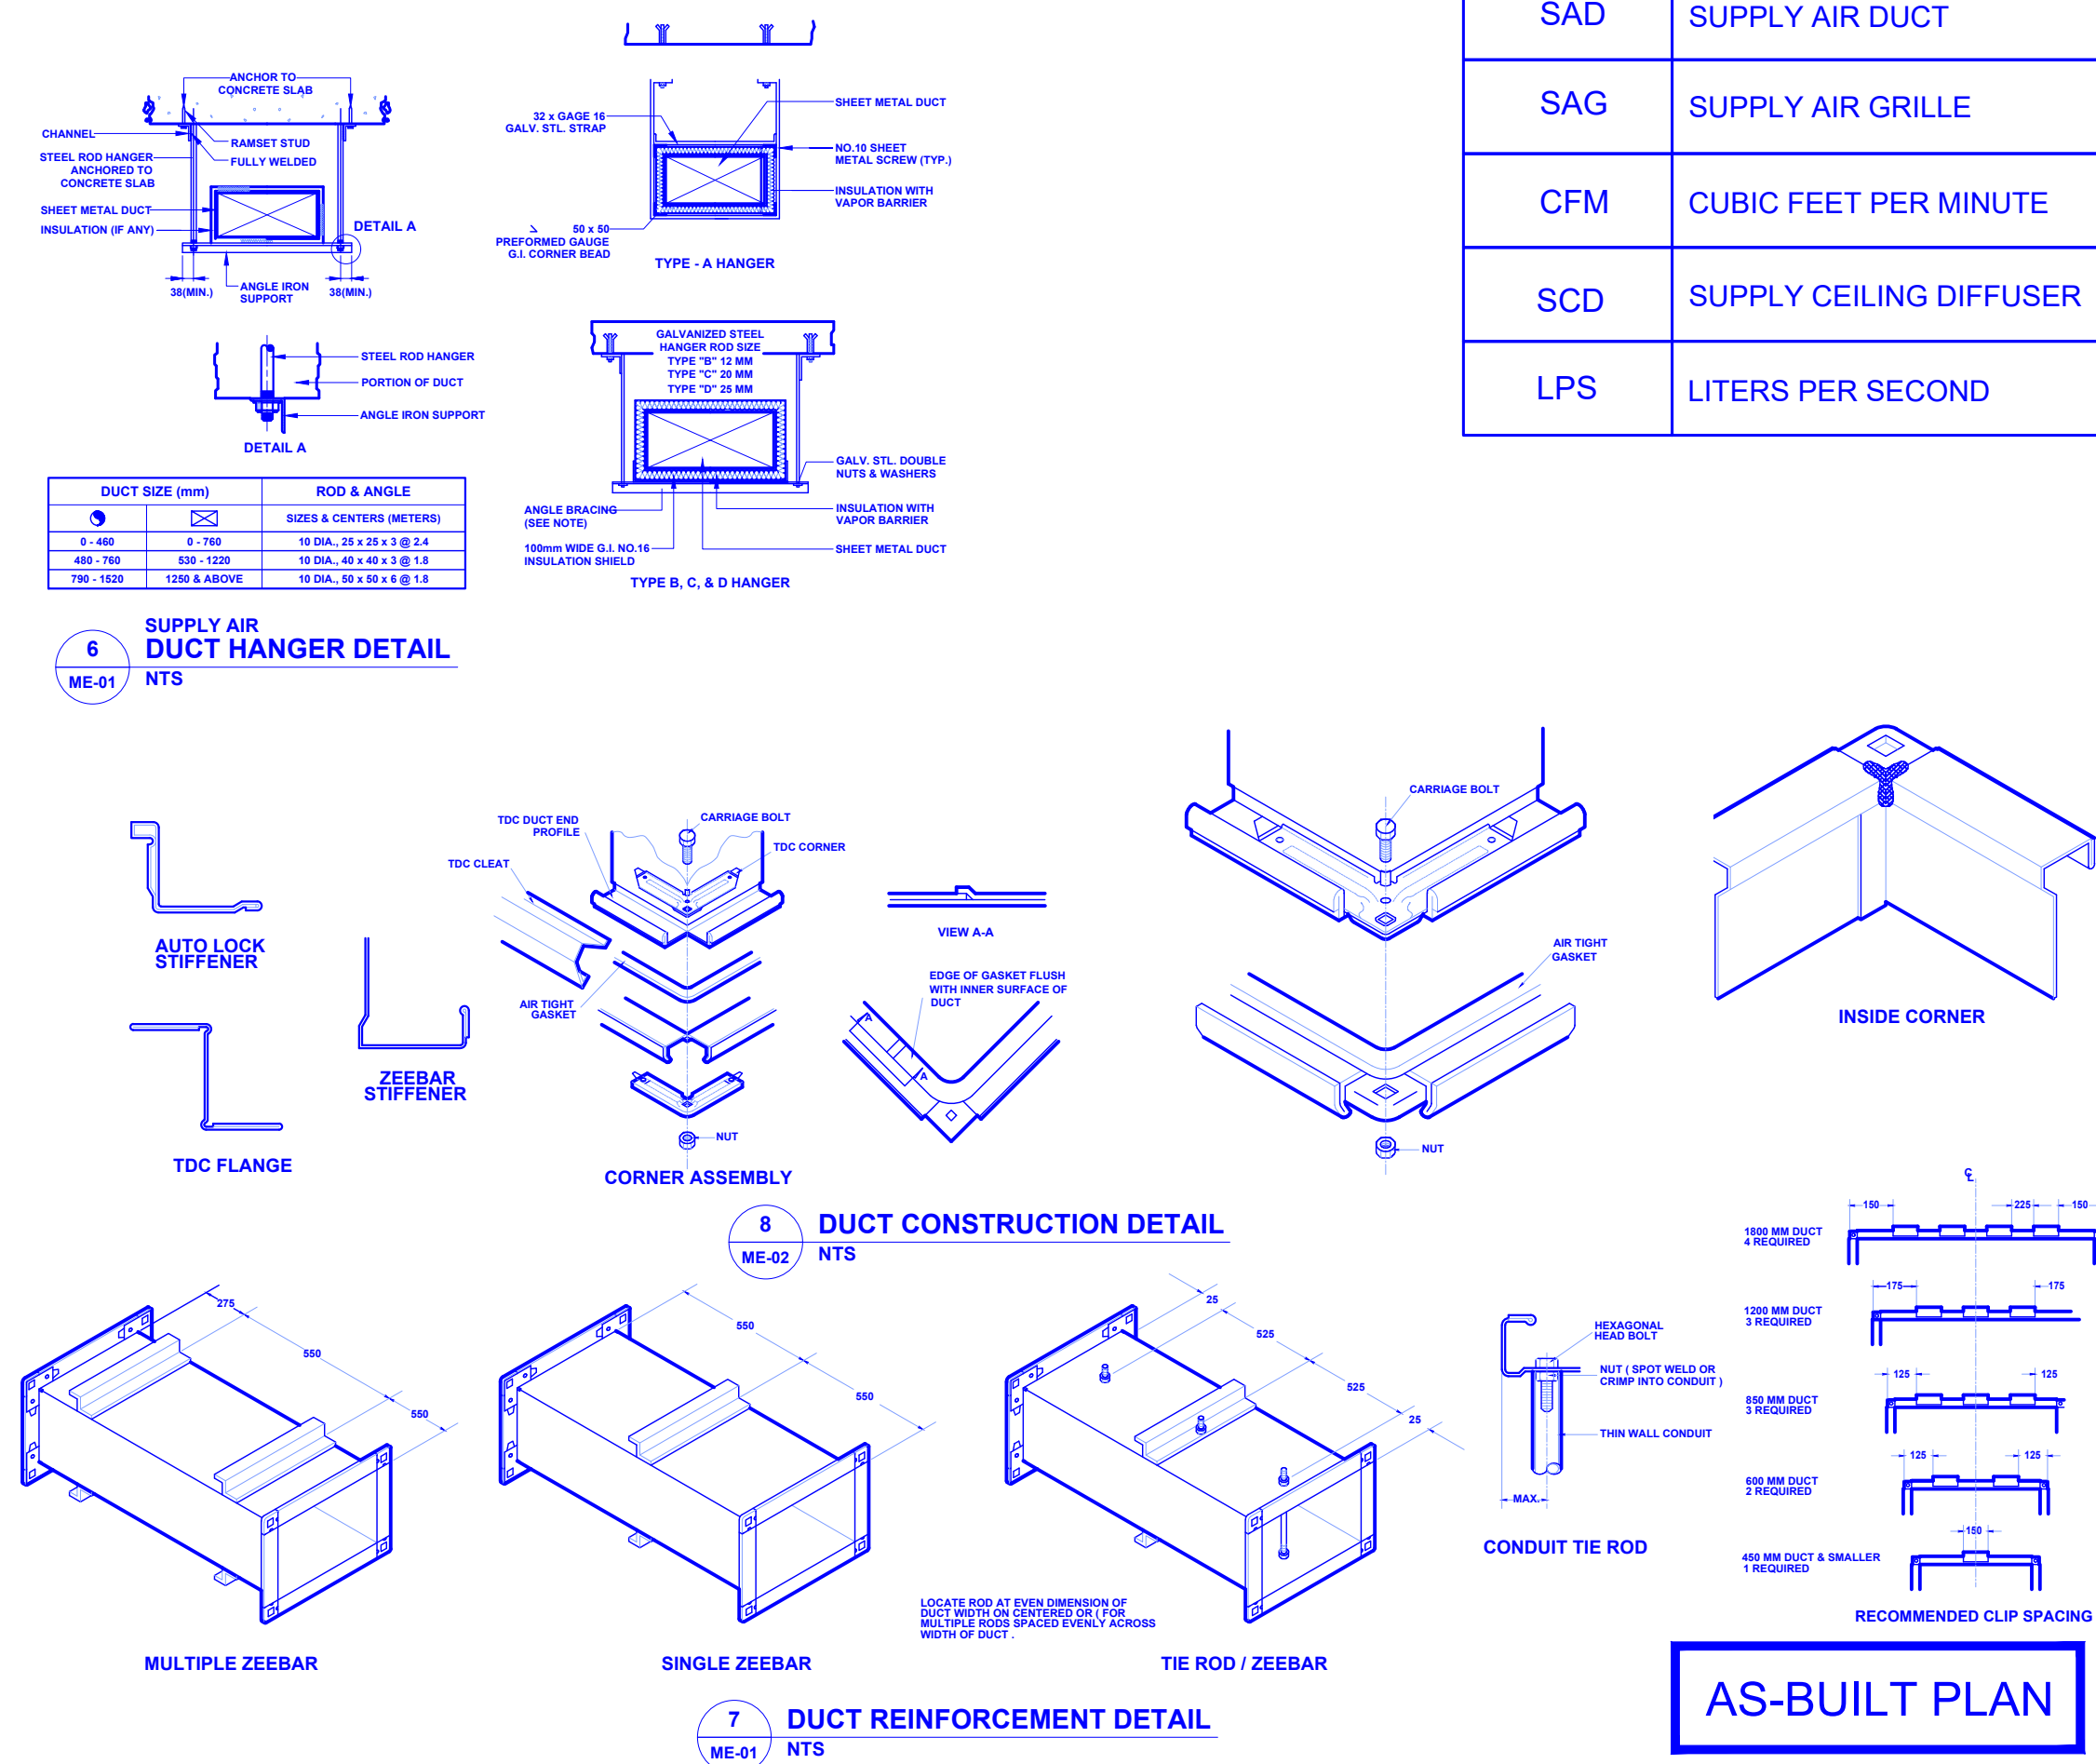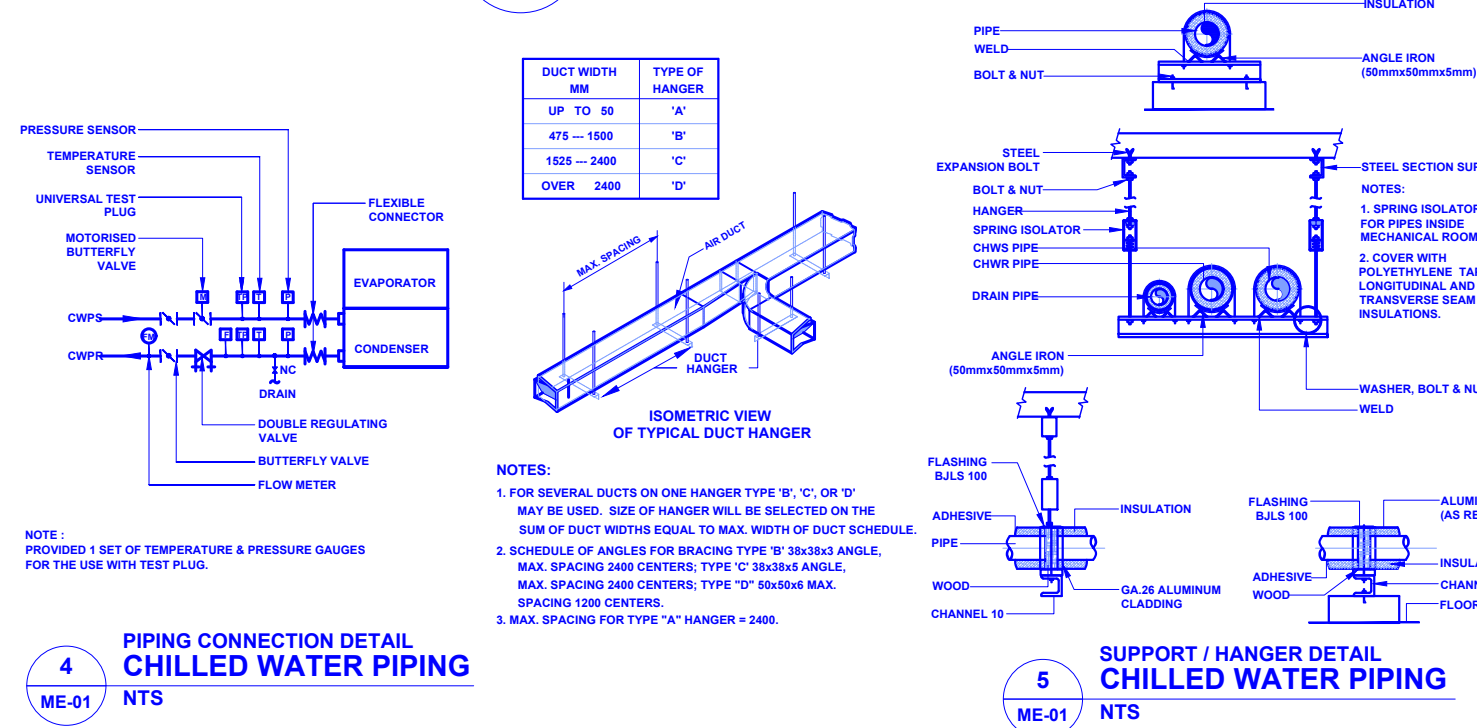

AS-BUILT PLAN
ME-01 NTS



R.A.9266 Section 33

Drawing and specifications and other contract documents signed, stamped or sealed, as instruments of service, are the intellectual property and documents of the architect, whether the object for which they are made is executed or not, if shall be unlawful for any person to duplicate or to make copies of said documents for use in the repetition of and for other projects of building, whether executed partly in whole, without the written consent of architect or author of said documents.

PROFESSIONAL MECHANICAL ENGINEER		
PRC. NO.:	ISSUED :	VALID :
PTR NO. :	ISSUED :	PLACE :
TIN :		

SEAL

PROJECT TITLE

AS-BUILT OF
DECATHLON CONNECT
(71.95 SQM. INTERIOR RENOVATION)

LOCATION: Unit L1 224-225 Market! McKinley Parkway, Bonifacio Global City, Taguig, Metro Manila

APPROVED BY

DECATHLON PHILIPPINES INC.
LAILA MONICA FLOR
OWNER

ADDRESS:

SHEET CONTENT

-GENERAL NOTES
-VICINITY MAP
-TYPICAL DETAILS
-AIR-CONDITIONING LAYOUT
-CHILLED WATER AND CONDENSATE DRAIN PIPING

DESIGNED BY:

DRAFTED BY: SBMI

DATE ISSUED:

REVISIONS
①
②
③

THIS DRAWING IS ISSUED FOR :

AS BUILT
BIDDING
BUILDING PERMIT
CONSTRUCTION

ESTIMATE
FABRICATION
OWNER'S APPROVAL
PRESENTATION

SHEET NO.

M-1

01

01

GENERAL NOTES:

1. ALL ELECTRICAL WORKS HERE IN SHALL BE DONE IN ACCORDANCE WITH THESE PLANS AND SPECIFICATIONS, THE APPLICABLE PROVISIONS OF THE LATEST EDITION OF THE PHILIPPINE ELECTRICAL CODE, THE RULES AND REGULATIONS OF THE LOCAL POWER COMPANY. THE ELECTRICAL WORKS SHALL BE UNDER IMMEDIATE SUPERVISION OF A DULY REGISTERED LICENSED ELECTRICAL ENGINEER OR MASTER ELECTRICIAN.
2. POWER SERVICE TO THE UNIT SHALL BE 400V, THREE-PHASE, LINE TO LINE, 4-WIRES + GROUND, 60 HERTZ.
3. WIRING METHOD SHALL BE DONE IN INTERMEDIATE METALLIC CONDUIT (IMC) FOR LIGHTING AND POWER SYSTEM. MINIMUM SIZE FOR ALL CONDUIT SHALL BE 15MM DIAMETER ELECTRICAL TRADE SIZE.
4. ALL WIRE SHALL BE COPPER AND THERMOPLASTIC INSULATED TYPE "THHN" UNLESS OTHERWISE INDICATED IN THE PLANS.
5. SMALLEST BRANCH CIRCUIT WIRE SHALL BE NO. 3.5MM SQ. THHN FOR POWER AND LIGHTING SYSTEM AND RACEWAY 15MM DIAMETER TRADE SIDE IMC CONDUIT. ALL WIRES SHALL BE INSULATED FOR 600 VOLTS.
6. ALL BRANCH CIRCUITS SHALL BE INSTALLED AS INDICATED IN THE PLANS, INDIVIDUAL BRANCH CIRCUIT HOMERUNS SHALL NOT BE COMBINED IN THE SAME RACEWAY.
7. WHENEVER NECESSARY, PULLBOXES OF PROPER SIZE AND DIMENSIONS SHALL BE PROVIDED ALTHOUGH NOT INDICATED IN THE PLAN.
8. ALL JUNCTION AND PULLBOXES SHALL BE PROVIDED WITH METAL PLATE COVERS.
9. ALL FLUORESCENT LAMP SHALL BE LED, SPRING LOADED LAMP HOLDERS AND ENCLOSED IN A METALLIC BOX.
10. ALL MATERIALS TO BE USED SHALL BE BRAND NEW AND APPROVED TYPE FOR ITS LOCATION AND PURPOSE.
11. ALL EXPOSED CONDUIT RUN SHALL BE INSTALLED PARALLEL TO OR PERPENDICULAR WITH THE BUILDING LINE AND SUPPORTED BY CONDUIT CLAMPS FOR EVERY 1.0 METER. DIAGONAL CONDUIT RUN SHALL NOT BE ACCEPTED.
12. THE ELECTRICAL CONTRACTOR IS REQUIRED TO VISIT THE SITE TO ASCERTAIN HIMSELF TO THE ACTUAL CONDITIONS THAT MAY AFFECT HIS WORK.
13. ALL WIRES AND CABLES SHALL BE COLOR CODED AS FOLLOWS:

LINE 1

LINE 2

LINE 3

GREEN

WHITE

- RED

- YELLOW

- BLUE

- GROUND

- NEUTRAL
14. MOUNTING HEIGHTS NOT SHOWN IN THE PLAN SHALL BE AS FOLLOWS:

A. LIGHT CONTROLLED SWITCHES

B. CONVENIENCE OUTLETS

C. PANEL BOARD

- 1400MM AFFL @ CENTER







- 300MM AFFL @ CENTER

- 100MM ABOVE COUNTER

BASEBOARD HEIGHT IN LOW


PARTITION

- 1400MM AFFL @ CENTER
15. THE ELECTRICAL CONTRACTOR SHALL SECURE ALL WIRING PERMITS AND ALL FEES REQUIRED FOR THE WORK AND SHALL FURNISH THE OWNER THROUGH THE PROJECT MANAGER. CERTIFICATE OF FINAL ELECTRICAL INSPECTION (CFEI) AND APPROVAL FROM THE PROPER AUTHORITIES.
16. UPON COMPLETION OF ELECTRICAL WORK, INSULATION RESISTANCE TEST, GROUNDING TEST AND LOAD BALANCE TEST SHALL BE CONDUCTED BY THE CONTRACTOR IN THE PRESENCE OF MALL ADMIN/ENGINEERING REPRESENTATIVE.
17. ALL WORKS HEREIN SHALL COMPLY TO THE CONSTRUCTION GUIDELINES AND SHALL BE COORDINATED WITH THE MALL ADMIN/ENGINEERING.
18. THE ELECTRICAL CONTRACTOR IS REQUIRED TO REPORT ANY DISCREPANCY TO THE PLANS AND SPECIFICATIONS IN THE ACTUAL SITE CONDITIONS.
19. PROVIDE APPROVED TYPE OF HANGERS AND SUPPORT DIRECTLY CONNECTED TO CEILING SLAB (GI WIRE NOT ALLOWED), NO HANGER SHOULD BE CONNECTED AT BEAM.

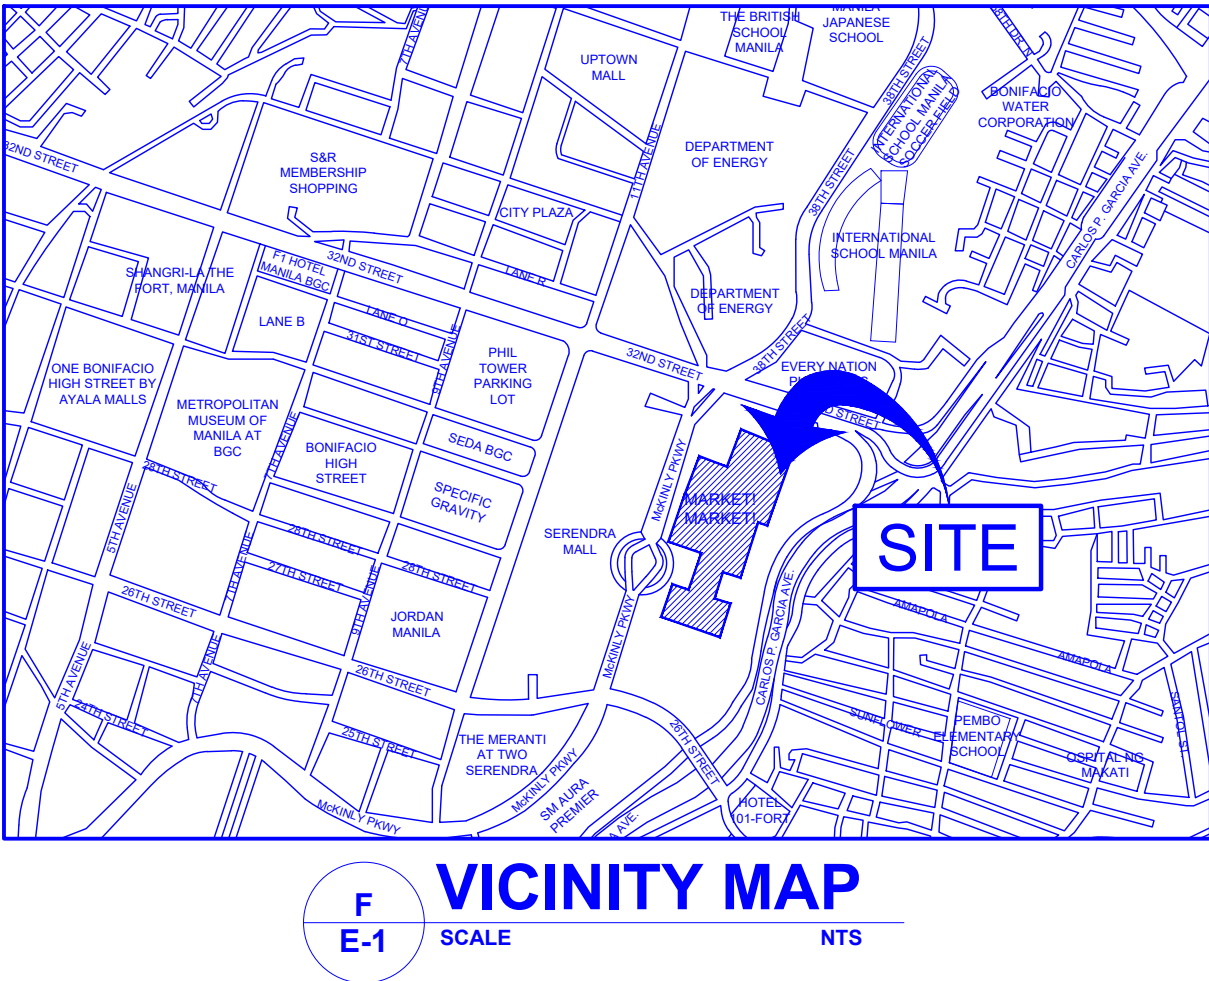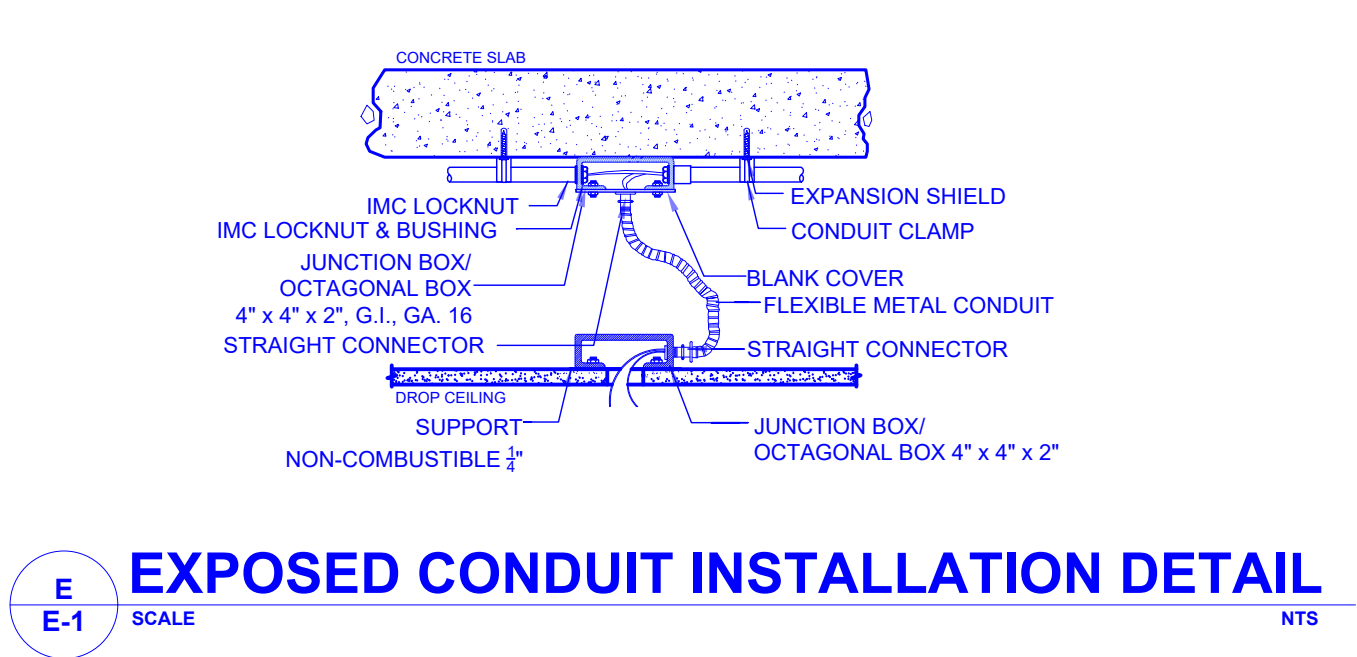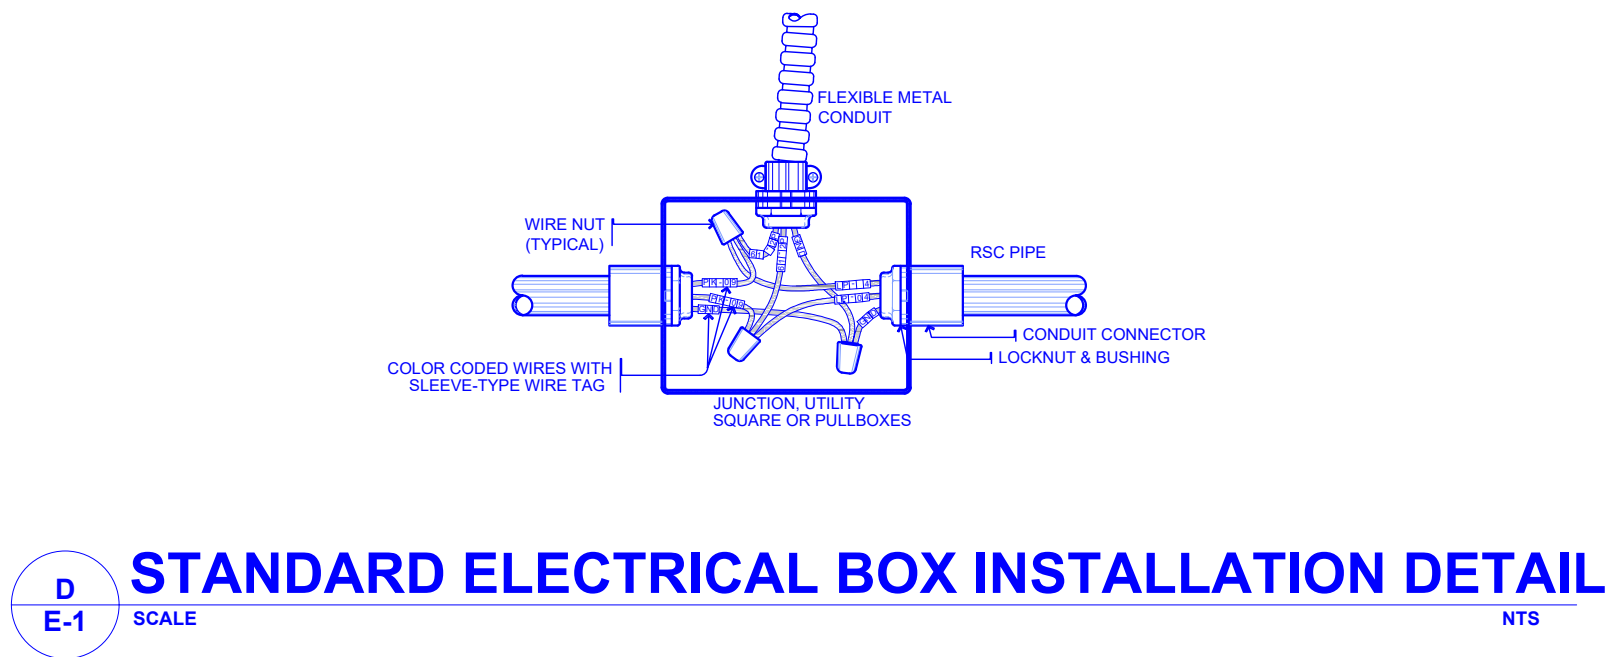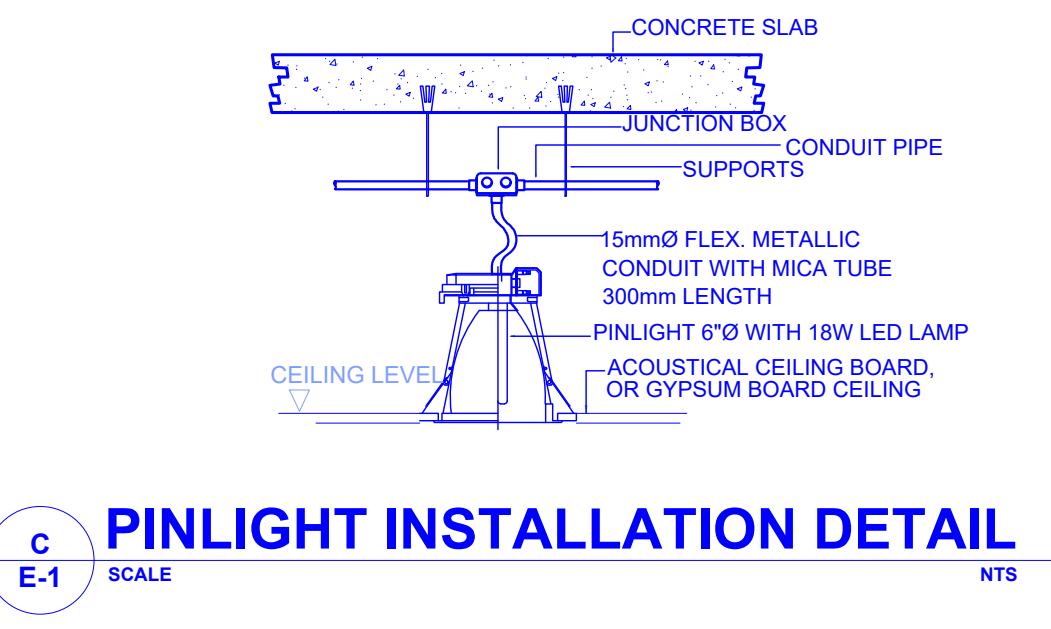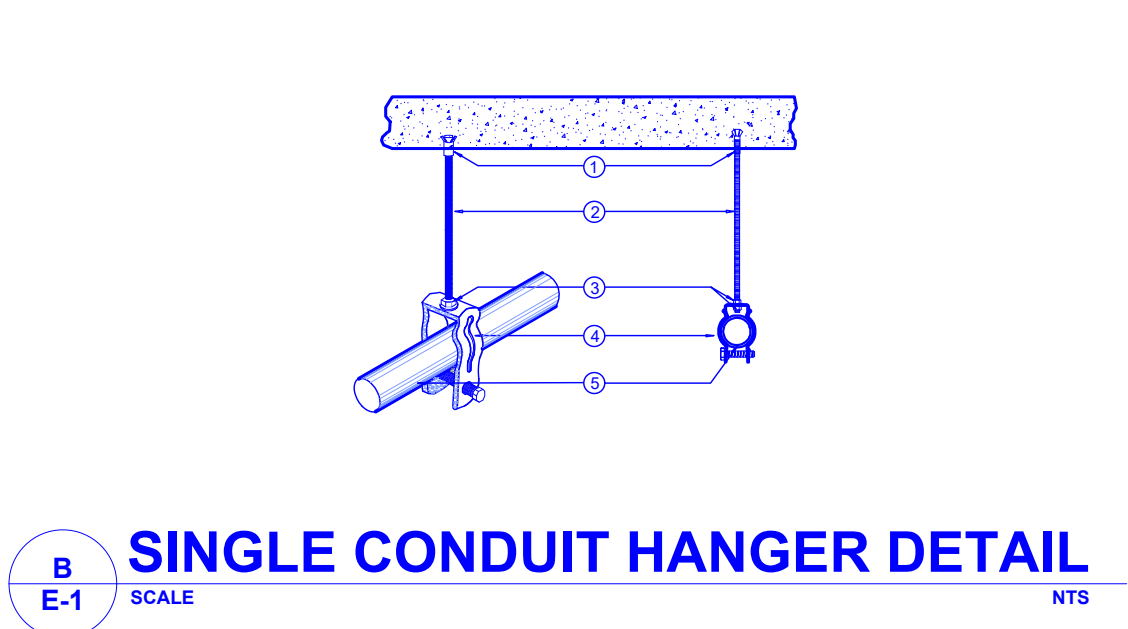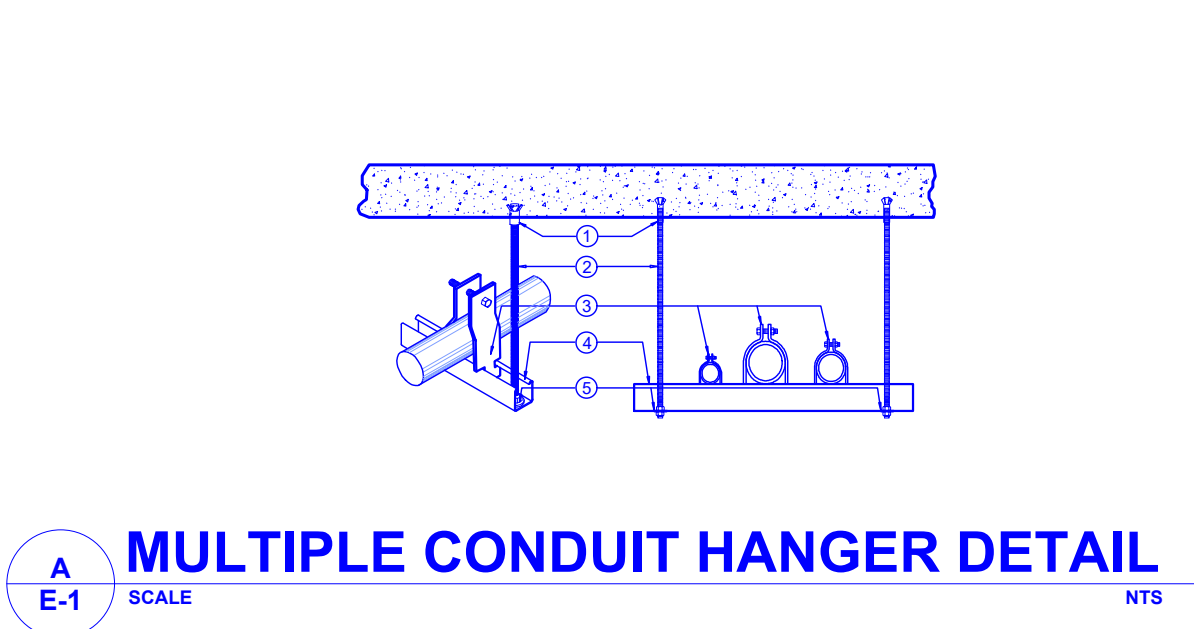

SCHEDULE OF LOADS

CKT. NO.	DESCRIPTION	PHASE	VOLTS	VA	AMPERE LOAD	CIRCUIT BREAKER RATING				WIRE	CONDUIT
					L-N	AT	AF	POLE	KAIC		
1	FCU	1	230	410	1.78	20	50	1	10	2 - 3.5mm² THHN + 1 - 3.5mm² THHN (G)	15mmØ IMC
2	DUPLEX CONVENIENCE OUTLET	1	230	2160	9.39	20	50	1	10	2 - 3.5mm² THHN + 1 - 3.5mm² THHN (G)	15mmØ IMC
3	LIGHTING	1	230	550	2.39	20	50	1	10	2 - 3.5mm² THHN + 1 - 3.5mm² THHN (G)	15mmØ IMC
4	LIGHTING	1	230	1000	4.35	20	50	1	10	2 - 3.5mm² THHN + 1 - 3.5mm² THHN (G)	15mmØ IMC
5	SIGNAGE	1	230	500	2.17	20	50	1	10	2 - 3.5mm² THHN + 1 - 3.5mm² THHN (G)	15mmØ IMC
6	SIGNAGE	1	230	500	2.17	20	50	1	10	2 - 3.5mm² THHN + 1 - 3.5mm² THHN (G)	15mmØ IMC
7	NVR/CCTV	1	230	500	2.17	20	50	1	10	2 - 3.5mm² THHN + 1 - 3.5mm² THHN (G)	15mmØ IMC
8	AMPLIFIER	1	230	500	2.17	20	50	1	10	2 - 3.5mm² THHN + 1 - 3.5mm² THHN (G)	15mmØ IMC
9	RFID	1	230	500	2.17	20	50	1	10	2 - 3.5mm² THHN + 1 - 3.5mm² THHN (G)	15mmØ IMC
10	DOOR ACCESS	1	230	500	2.17	20	50	1	10	2 - 3.5mm² THHN + 1 - 3.5mm² THHN (G)	15mmØ IMC
11	SPARE	1	230	1000	4.35	20	50	1	10	2 - 3.5mm² THHN + 1 - 3.5mm² THHN (G)	15mmØ IMC
12	SPARE	1	230	1000	4.35	20	50	1	10	2 - 3.5mm² THHN + 1 - 3.5mm² THHN (G)	15mmØ IMC
TOTAL CONNECTED LOAD				9120	39.63						
SYSTEM: 230V, 3-WIRE + NEUTRAL + GROUND, 60Hz DF: 80% ifl = { [(IØ + I3Ø) x D.F.] } = <u>32.17 AMP.</u> MAIN: 50AT, 100AF, 1 - POLE, 230V FEEDER: 2 - 8.0mm² THHN + 1 - 5.5mm² THHN (GROUND) IN 25mmØ IMC											

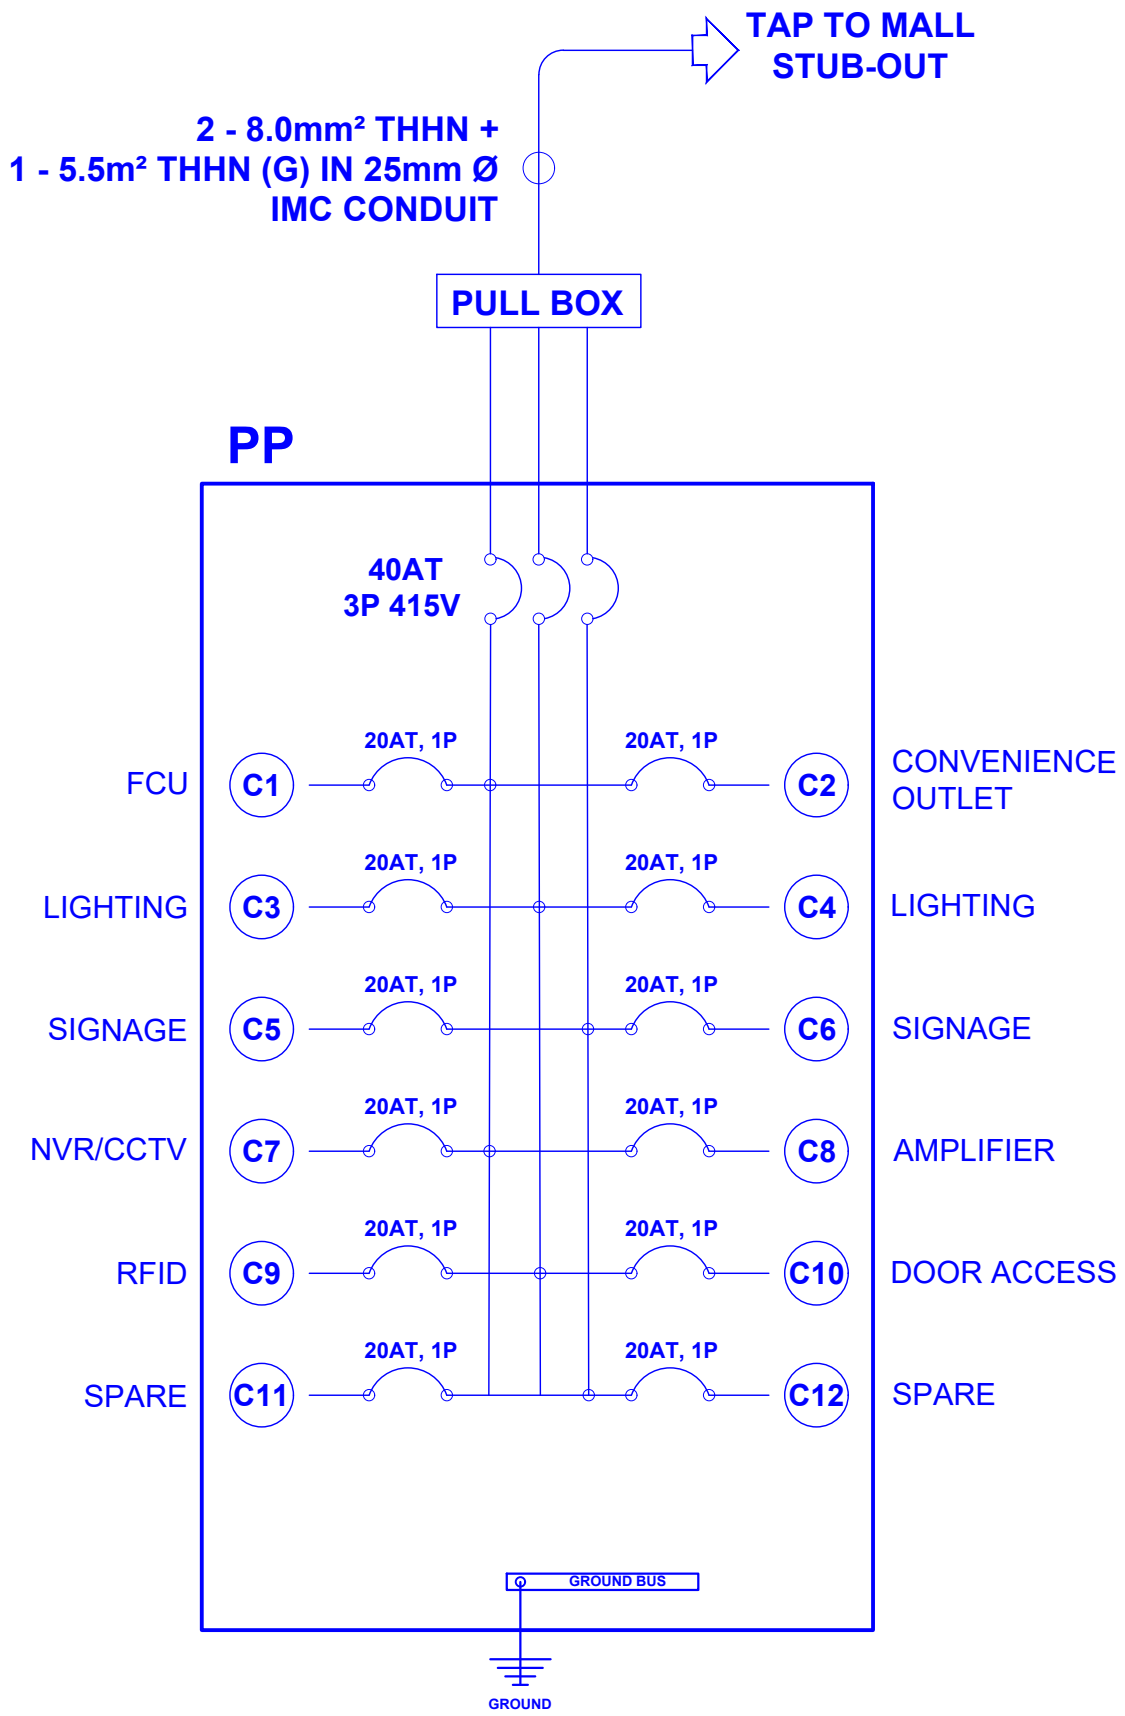

SINGLE LINE DIAGRAM

AS-BUILT PLAN



	R.A.9266 Section 33 Drawing and specifications and other contract documents signed, stamped or sealed, as instruments of service, are the intellectual property and documents of the architect, whether the object for which they are made is executed or not, if shall be unlawful for any person to duplicate or to make copies of said documents for use in the repetition of and for other projects of building, whether executed partly in whole, without the written consent of architect or author of said documents.	PROFESSIONAL ELECTRICAL ENGINEER			SEAL	PROJECT TITLE	APPROVED BY	SHEET CONTENT	DESIGNED BY:	THIS DRAWING IS ISSUED FOR : ☒ AS BUILT ☐ BIDDING ☐ BUILDING PERMIT ☐ CONSTRUCTION ☐ ESTIMATE ☐ FABRICATION ☐ OWNER'S APPROVAL ☐ PRESENTATION	SHEET NO.		
		PRC. NO.:	ISSUED :	VALID :		AS-BUILT OF DECATHLON CONNECT (71.95 SQM. INTERIOR RENOVATION)	DECATHLON PHILIPPINES INC. LAILA MONICA FLOR OWNER	GENERAL NOTES TYPICAL DETAILS VICINITY MAP SCHEDULE OF LOADS SINGLE LINE DIAGRAM	DRAFTED BY: SBMI DATE ISSUED:		E-1 0102		
		PTR NO.:	ISSUED :	PLACE :									
		TIN :											
LOCATION: Unit L1 224-225 Market! Market! McKinley Parkway, Bonifacio Global City, Taguig, Metro Manila						ADDRESS:							

SECTION HEAD: DATE
ISSUED BY:

BUILDING OFFICIAL DATE

LEGEND & SYMBOLS

	SYSTEM TRACKLIGHT (L01)
	DECATHLON ACCENT PERIMETER LIGHT UNIT
	LED FLAT PANEL LIGHT
	TRACK-LIGHT SYSTEM
	SURFACE MOUNTED DOWN LIGHT FIXTURE SUSPENDED TO SLAB
	EMERGENCY LIGHT
	EMERGENCY EXIT
	PANEL BOARD
	SWITCH BANK

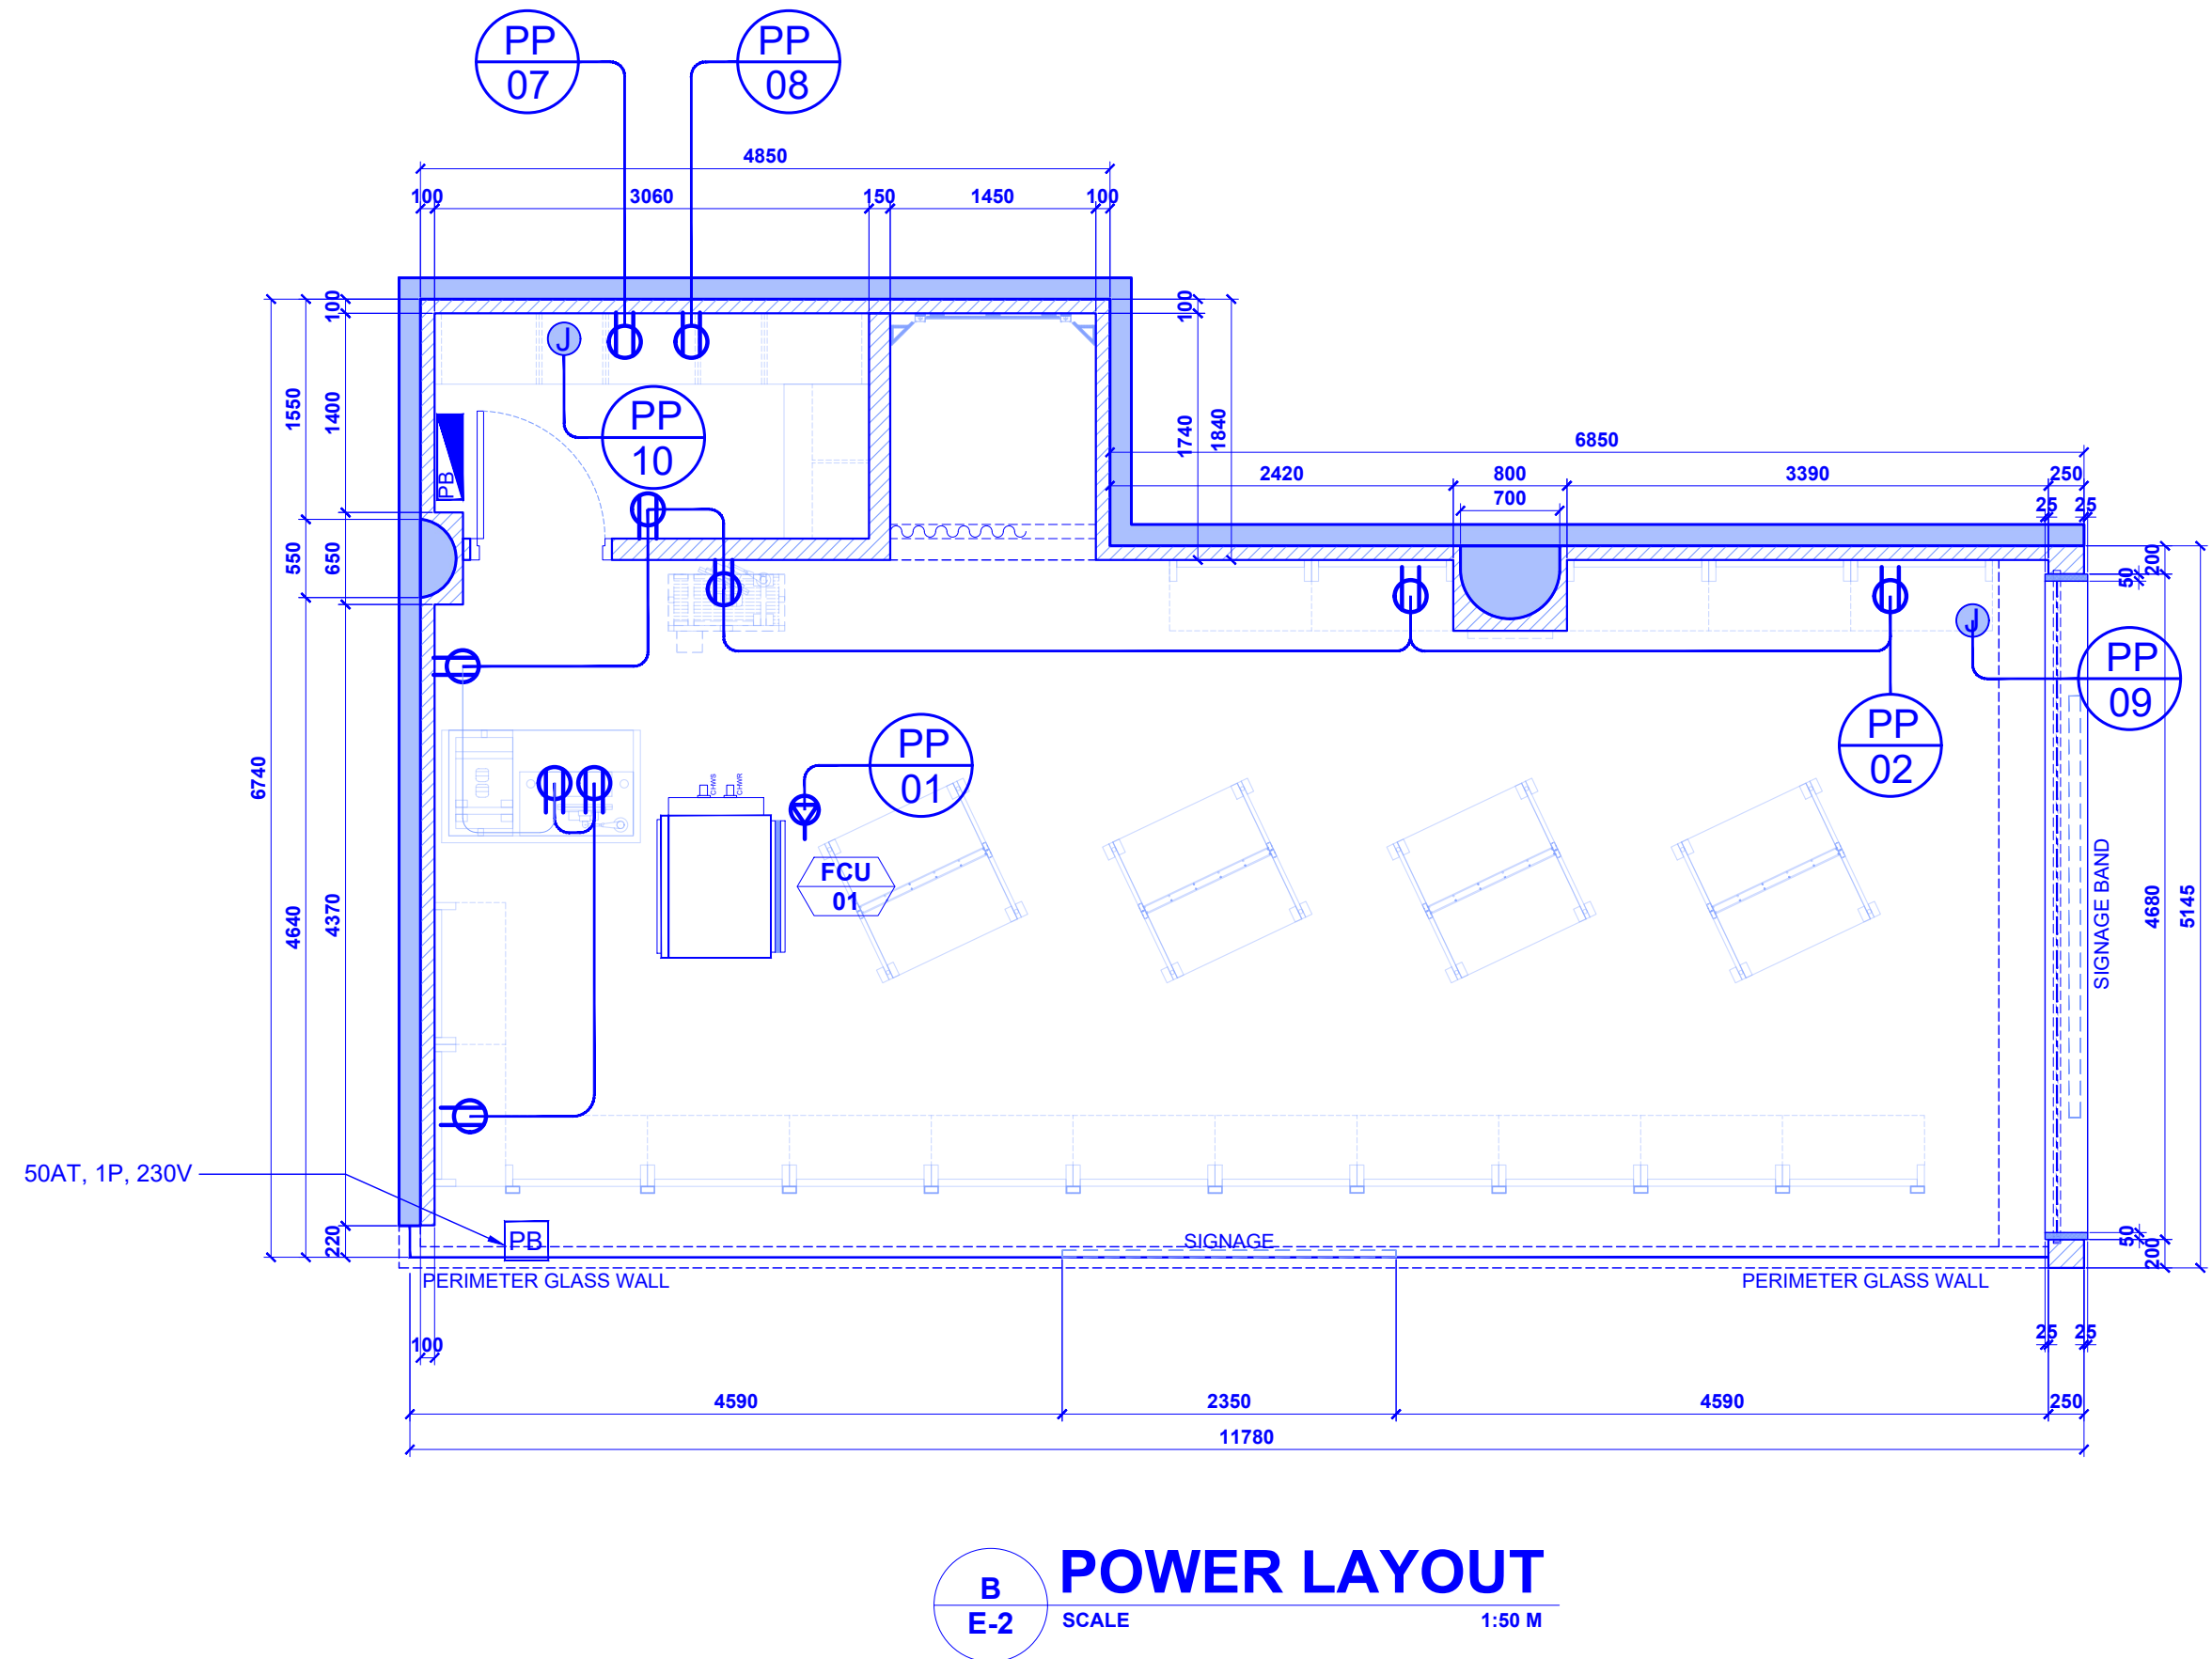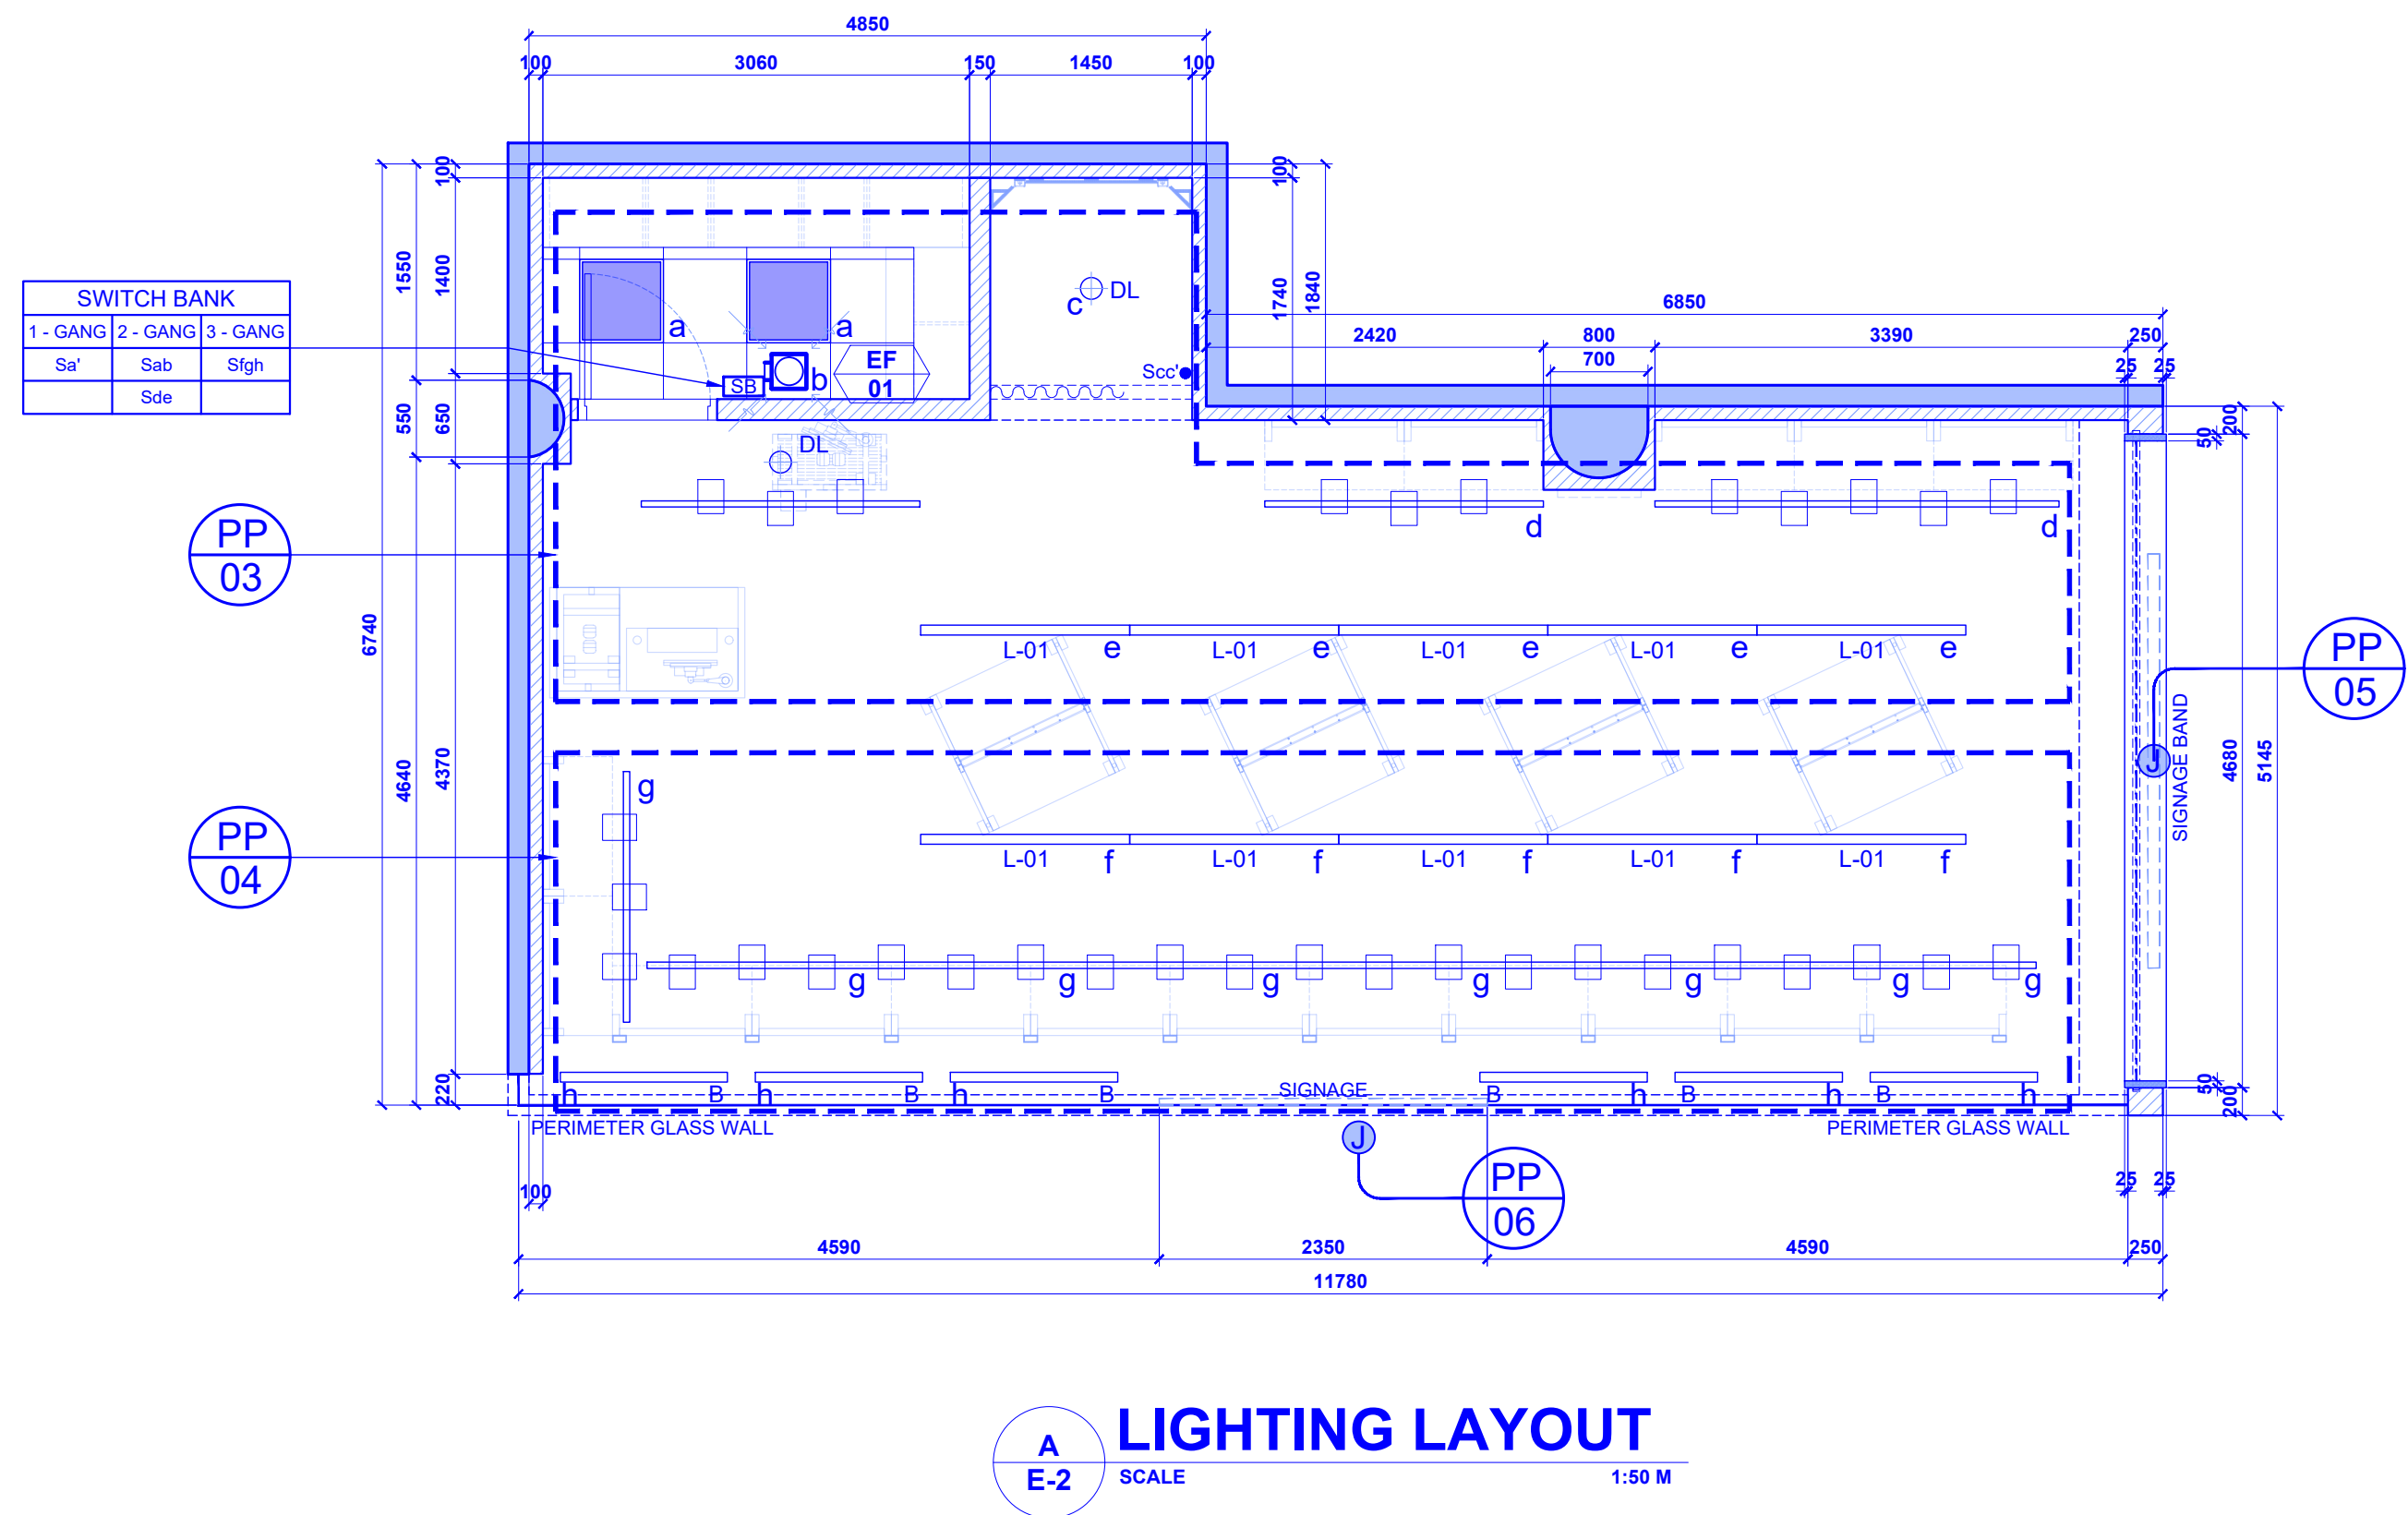

AS-BUILT PLAN



R.A.9266 Section 33
Drawing and specifications and other contract documents signed, stamped or sealed, as instruments of service, are the intellectual property and documents of the architect, whether the object for which they are made is executed or not, if shall be unlawful for any person to duplicate or to make copies of said documents for use in the repetition of and for other projects of building, whether executed partly in whole, without the written consent of architect or author of said documents.

PROFESSIONAL ELECTRICAL ENGINEER		
PRC. NO.:	ISSUED :	VALID :
PTR NO. :	ISSUED :	PLACE :
TIN :		

SEAL

PROJECT TITLE
AS-BUILT OF
DECATHLON CONNECT
(71.95 SQM. INTERIOR RENOVATION)
LOCATION: Unit L1 224-225 Market! Market! McKinley Parkway, Bonifacio Global City, Taguig, Metro Manila

APPROVED BY
DECATHLON PHILIPPINES INC.
LAILA MONICA FLOR
OWNER
ADDRESS:

SHEET CONTENT
LIGHTING LAYOUT
POWER LAYOUT
LEGEND & SYMBOLS

DESIGNED BY:	THIS DRAWING IS ISSUED FOR :
DRAFTED BY: SBMI	☒ AS BUILT ☐ ESTIMATE
DATE ISSUED:	☐ BIDDING ☐ FABRICATION
	☐ BUILDING PERMIT ☐ OWNER'S APPROVAL
	☐ CONSTRUCTION ☐ PRESENTATION
REVISIONS	DATE
①	①
②	②
③	③

SHEET NO.
E-2
02 02